

FLORIDA POWER AND LIGHT

From: [Mcjunkin, Chris](#)
To: [John Czerkowski, E.I.](#)
Subject: RE: 436928-1: Burnt Store Rd PD&E Study- UAO coordination follow-up
Date: Thursday, November 10, 2022 4:13:04 PM
Attachments: [image002.png](#)
[image003.png](#)
[image006.png](#)
[image001.png](#)

John, we don't serve south of the Marina on Burnt Store rd. that would be Lee county electric coop

Chris McJunkin

Service Planner

Toledo Blade Service Planer – Power Delivery

Florida Power & Light

Phone: (941-423-4833) | chris.mcjunkin@fpl.com

Cell: (941-267-7476)

2245 Murphy Court – Mailstop TB1 | Northport, FL 34289



Link to FPL's Project Portal:

<https://partner.fpl.com/construction.html>

Please contact me with any questions or concerns. If you cannot reach me, feel free to contact my Engineering Leader Nikolás Zapata at (o) 941-423-4831.

From: John Czerkowski, E.I. <jczerkowski@scalarinc.net>

Sent: Thursday, November 10, 2022 9:44 AM

To: Mcjunkin, Chris <Chris.Mcjunkin@fpl.com>

Subject: RE: 436928-1: Burnt Store Rd PD&E Study- UAO coordination follow-up

Good morning,

No worries, Chris. Please follow the OneDrive link to see a set of roadway plans.

 [436928-1_Greenlines_red.pdf](#)

See also the attached KMZ to help you locate the project, along with the initial email response from FPL.

Thanks,

John Czerkowski, E.I.

Engineer Intern



13337 North 56th Street

Tampa, Florida 33617

Ph: (904) 762-8040

jczerkawski@scalarinc.net
www.scalargroupinc.net

From: Mcjunkin, Chris <Chris.Mcjunkin@fpl.com>
Sent: Thursday, November 10, 2022 9:00 AM
To: John Czerkawski, E.I. <jczerkawski@scalarinc.net>
Subject: RE: 436928-1: Burnt Store Rd PD&E Study- UAO coordination follow-up

John, sorry for being so delayed. Can you send me a set of plans or drawings of the location so I can get this for you?

Chris McJunkin

Service Planner

Toledo Blade Service Planer – Power Delivery

Florida Power & Light

Phone: (941-423-4833) | chris.mcjunkin@fpl.com

Cell: (941-267-7476)

2245 Murphy Court – Mailstop TB1 | Northport, FL 34289



Link to FPL's Project Portal:

<https://partner.fpl.com/construction.html>

Please contact me with any questions or concerns. If you cannot reach me, feel free to contact my Engineering Leader Nikolas Zapata at (o) 941-423-4831.

From: John Czerkawski, E.I. <jczerkawski@scalarinc.net>
Sent: Wednesday, October 12, 2022 10:35 AM
To: Mcjunkin, Chris <Chris.Mcjunkin@fpl.com>
Subject: FW: 436928-1: Burnt Store Rd PD&E Study- UAO coordination follow-up

Good morning,

I am the utility coordinator for the Burnt Store Rd PD&E Study hoping to acquire information on existing utility easements within the R/W and relocation cost estimates. Juan Cruz referred us to you as the present Road Relocation Coordinator. Please let me know if you can help us out with our request..

Thanks,

John Czerkawski, E.I.

Engineer Intern



13337 North 56th Street
Tampa, Florida 33617

Ph: (904) 762-8040

jczerkawski@scalarinc.net

www.scalargroupinc.net

From: Cruz, Juan <Juan.Cruz@fpl.com>

Sent: Wednesday, October 12, 2022 10:20 AM

To: John Czerkawski, E.I. <jczerkawski@scalarinc.net>; Andy.Amendola@charlottecountyfl.gov;
Danny.Haskett@crowncastle.com; Ezekiel.Reid1@centurylink.com; Dolleman, Hendrik
<Hendrik.Dolleman@charlottecountyfl.gov>; JFencil@leegov.com; Keith.Lanman@lcec.net;
leonard_maxwell-newbold@comcast.com

Cc: Kristin Caruso <kcaruso@scalarinc.net>

Subject: RE: 436928-1: Burnt Store Rd PD&E Study- UAO coordination follow-up

ALL, this is to notify you that I am no longer the FPL Road Relocation Coordinator. Please remove my contact information from your list (for all road projects) and replace it with the present Road Relocation Coordinator Chris McJunkin. His contact info is listed below.

Chris McJunkin

Florida Power & Light

941-423-4833 (Office)

Chris.McJunkin@FPL.com

Thanks,

Juan Cruz

FPL

West Region Hardening

Project Engineer – Storm Hardening, Power Delivery

863-491-7001 (Office)

941-220-9266 (Cell)

Juan.Cruz@FPL.com

From: John Czerkawski, E.I. <jczerkawski@scalarinc.net>

Sent: Tuesday, October 11, 2022 3:45 PM

To: Andy.Amendola@charlottecountyfl.gov; Danny.Haskett@crowncastle.com;
Ezekiel.Reid1@centurylink.com; Dolleman, Hendrik <Hendrik.Dolleman@charlottecountyfl.gov>;
JFencil@leegov.com; Cruz, Juan <Juan.Cruz@fpl.com>; Keith.Lanman@lcec.net; leonard_maxwell-newbold@comcast.com

Cc: Kristin Caruso <kcaruso@scalarinc.net>

Subject: 436928-1: Burnt Store Rd PD&E Study- UAO coordination follow-up

Good afternoon,

Thank you for responding with the utility markups.

I am confirming that none of your company's have existing utility easements within the roadway R/W.

I am also requesting that you provide a ball-park estimate of how much it would cost for relocation.

Please refer to the FPN and description listed below and reply with the information at your earliest convenience.

Any issues, comments, or concerns can be directed towards myself or Kristen Caruso at (813) 988-1199 ext. 209 or email kcaruso@scalarinc.net.

FPN: 436928-1-22-01

Description: Burnt Store Road (CR 765) from Van Buren Parkway to Charlotte County Line PD&E Study

County: Lee

Thanks,

John Czerkowski, E.I.
Engineer Intern



13337 North 56th Street
Tampa, Florida 33617
Ph: (904) 762-8040

jczerkowski@scalarinc.net
www.scalargroupinc.net

This message is for the named person's use only. It may contain confidential, proprietary or legally privileged information. No confidentiality or privilege is waived or lost by any mistransmission. If you receive this message in error, please immediately delete it and all copies of it from your system, destroy any hard copies of it and notify the sender. You must not, directly or indirectly, use, disclose, distribute, print, or copy any part of this message if you are not the intended recipient.

Kristin Caruso

From: Cruz, Juan <Juan.Cruz@fpl.com>
Sent: Friday, October 16, 2020 5:41 PM
To: Winnie Kwong,
Subject: RE: 436928-1: Burnt Store Rd PD&E Study- Initial UAO coordination

Follow Up Flag: Follow up
Flag Status: Flagged

Winnie, FPL Distribution does **NOT** have any facilities with-in the limits of the project, with the only minor exception being on the North side of Vincent Ave. on the Charlotte County side. The green lines shown in the image below indicate the approximate location of the FPL Distribution facilities. FPL Distribution will have NO Involvement in this project.

The area below this location to the beginning of the project limits will most likely be covered by **LCEC**. See the contacts below for LCEC in case you need them.


LCEC Contacts:

Keith Lanman (Possibly involved in Road Relocation Projects)
Keith.Lanman@LCEC.net

Tom Bailey
Tom.Bailey@LCEC.net

Samuel "Sam" Lee (Design Engineer , Transmission)
Sam.Lee@LCEC.net

Adrian Rojas
Adrian.Rojas@LCEC.net

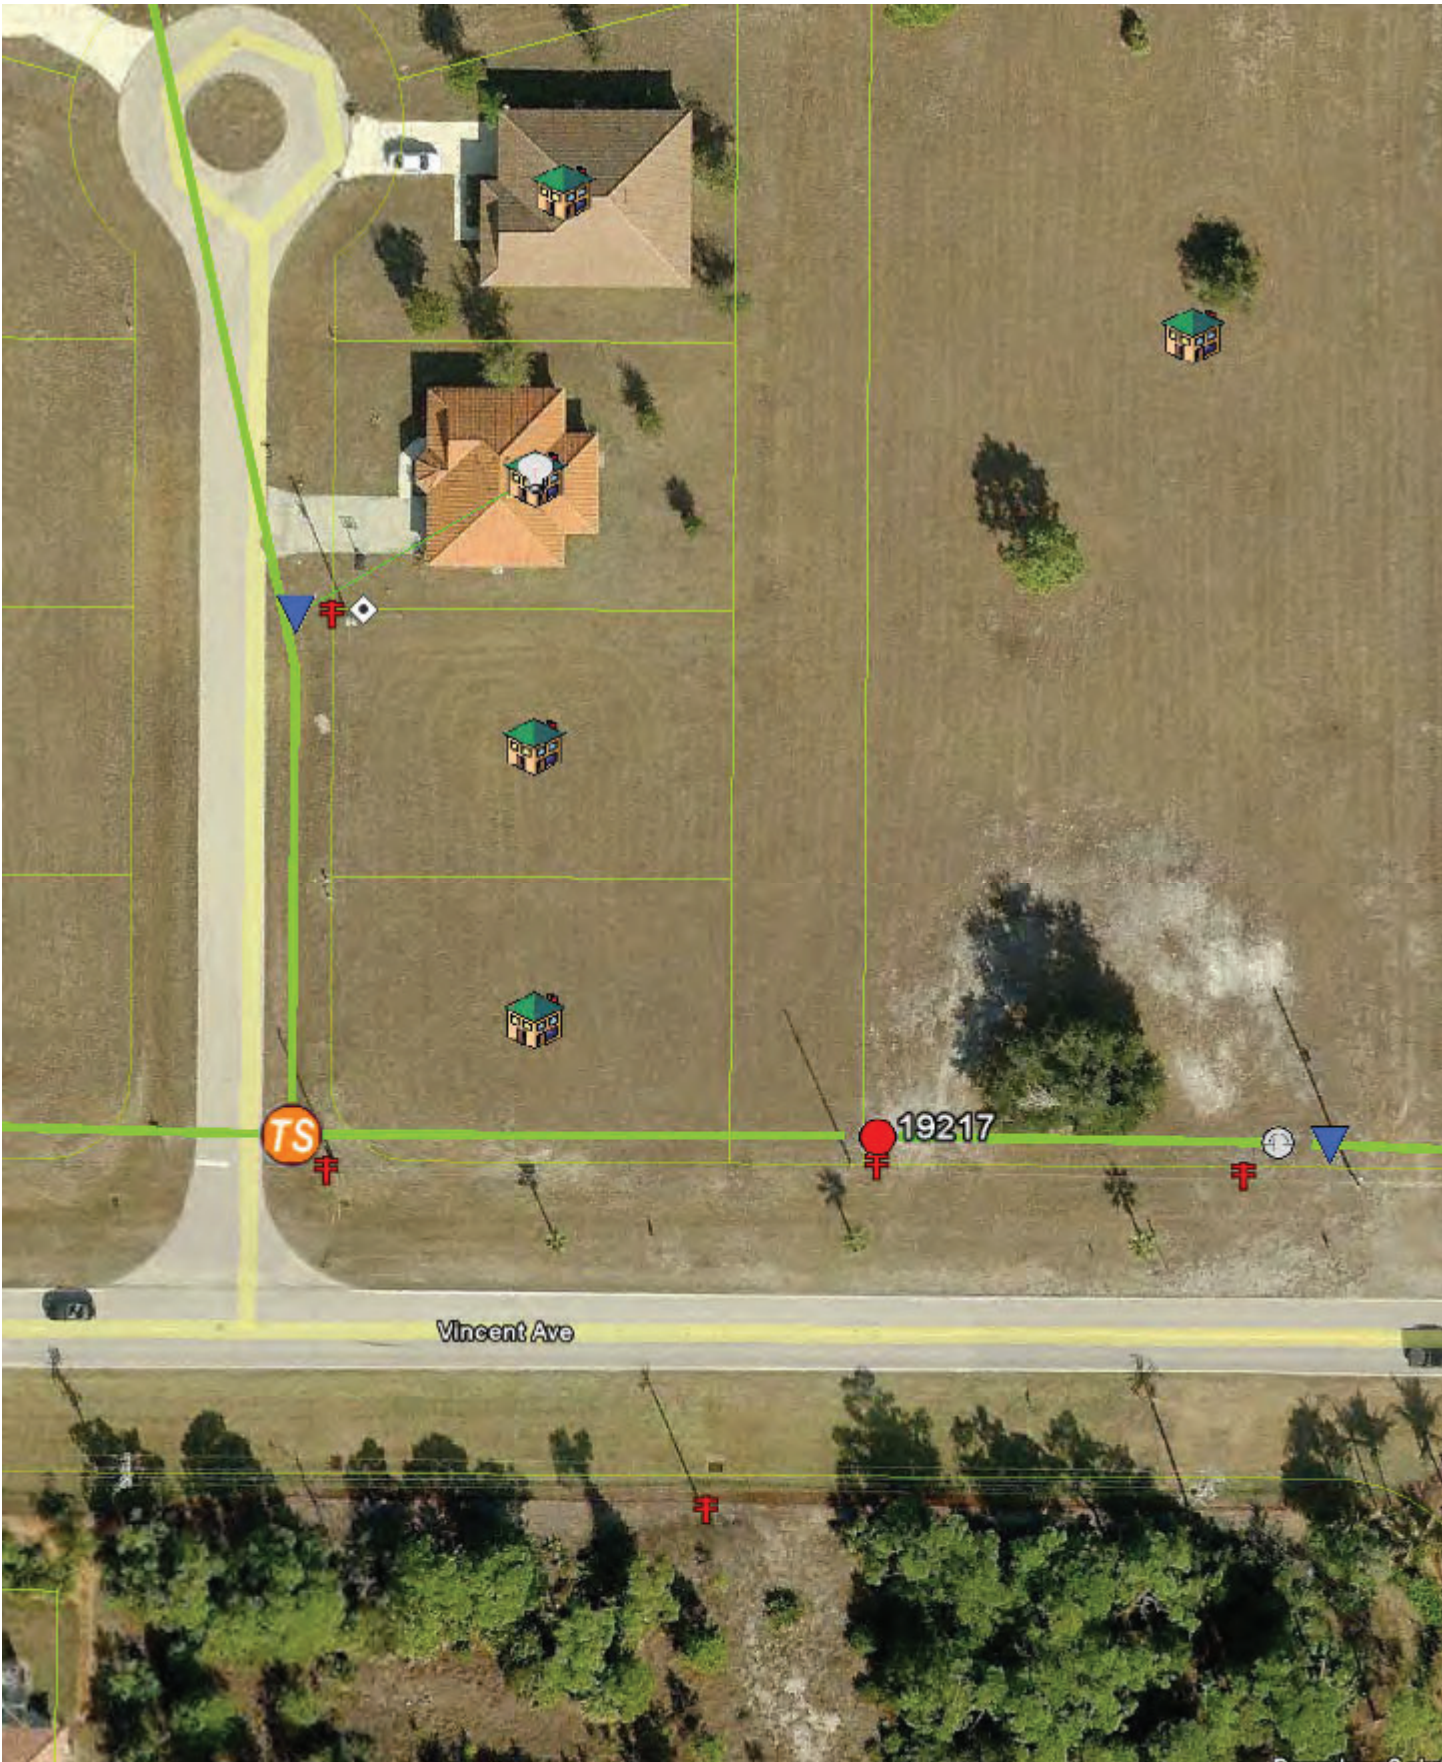

Thanks,

Juan Cruz
FPL
941-423-4842 (Office)
941-220-9266 (Cell)
Juan.Cruz@FPL.com

Link to FPL's Electrical Service Standards:
<https://www.fpl.com/partner/builders/service-standards.html>

To report an outage please call 1-800-4-OUTAGE (1-800-468-8243)



FPL Please contact me with any questions or concerns. If you cannot reach me, feel free to contact my Engineering Leader Scott Overbaugh at (o) 941-423-4852, (c) 941-239-246-1021 or Scott.Overbaugh@FPL.com

From: Winnie Kwong, <wkwong@scalarinc.net>
Sent: Friday, October 16, 2020 5:14 PM
To: Roll, Candice <Candice.Roll@fpl.com>
Cc: Cruz, Juan <Juan.Cruz@fpl.com>
Subject: RE: 436928-1: Burnt Store Rd PD&E Study- Initial UAO coordination

Caution - External Email (wkwong@scalarinc.net)

Report This Email

Tips

FPN: 436928-1-22-01

Description: Burnt Store Road (CR 765) from Van Buren Parkway to Charlotte County Line PD&E Study
County: Lee

Hi Candice,

Thank you for letting me know.

Would Juan Cruz be the person I should be contacting? Or is there someone else I should be in contact with in order to obtain markups?

Kind Regards,

Winnie Kwong, E.I.



13337 North 56th Street
Tampa, Florida 33617
Ph: (813) 988-1199 Ext. 215
Cell: (561) 568-9676
wkwong@scalarinc.net

From: Roll, Candice <Candice.Roll@fpl.com>
Sent: Friday, October 16, 2020 4:58 PM
To: Winnie Kwong, <wkwong@scalarinc.net>
Cc: Cruz, Juan <Juan.Cruz@fpl.com>
Subject: Re: 436928-1: Burnt Store Rd PD&E Study- Initial UAO coordination

I do not deal with road projects

Candie
Sent from my iPhone

On Oct 16, 2020, at 2:40 PM, Winnie Kwong, <wkwong@scalarinc.net> wrote:

Caution - External Email (wkwong@scalarinc.net)

Report This Email Tips

Hi Candice,

I wanted to reach out to you since I was instructed to contact you through the following email loops. I was told you would be the correct point of contact in order to obtain utility markups. If you are not, please let me know who I should contact instead.

Please mark-up (using the standard FDOT color code) and return one (1) set of aerial maps indicating the location, size and type, etc., of your existing and any future facilities. The mark-up should also identify all known **EASEMENTS** or other lands of ownership rights. I am also requesting you to provide/prepare a rough cost estimate for relocation of your facilities (per mile basis is acceptable), indicating the impact you anticipate with your facilities.

Please also advise us in writing on your company letterhead if you do not have any existing or planned utility installations within the limits of this job.

The project file can be found in the link below:

Here's a OneDrive link to

[<image002.png>](#)

[436928-1 Burnt Store Road \(CR 765\) from Van Buren Parkway to Charlotte County Line PD&E Study.](#)

Kind Regards,

Winnie Kwong, E.I.

[<image001.png>](#)

13337 North 56th Street

Tampa, Florida 33617

Ph: (813) 988-1199 Ext. 215

Cell: (561) 568-9676

wkwong@scalarinc.net

From: Winnie Kwong,
Sent: Wednesday, September 23, 2020 1:12 PM
To: 'Bray, Joel' <Joel.Bray@fpl.com>
Subject: RE: 436928-1: Burnt Store Rd PD&E Study- Initial UAO coordination

Hi Joel,

Thank you for information!

Kind Regards,

Winnie Kwong

<image001.png>

13337 North 56th Street

Tampa, Florida 33617

Ph: (813) 988-1199 Ext. 215

Cell: (561) 568-9676

wk Wong@scalarinc.net

From: Bray, Joel <Joel.Bray@fpl.com>
Sent: Wednesday, September 23, 2020 12:28 PM
To: Winnie Kwong, <wk Wong@scalarinc.net>
Subject: RE: 436928-1: Burnt Store Rd PD&E Study- Initial UAO coordination

I cannot assist, please refer to <https://partner.fpl.com/construction.html> scroll down to the map and enter the address of the project and the local construction/engineering office information will appear.

From: Winnie Kwong, <wk Wong@scalarinc.net>
Sent: Wednesday, September 23, 2020 11:34 AM
To: tshevche@capecoral.net; Andy.Amendola@CharlotteCountyFL.gov; Maxwell-Newbold, Leonard <leonard_maxwell-newbold@comcast.com>; russb@broadstar.com; Bray, Joel <Joel.Bray@fpl.com>; Haskett, Danny <Danny.Haskett@crowncastle.com>; bruce.bullert@charlottefl.com; Eiverson@pineislandwater.com; ucdinfo@capecoral.net; Rkirsch@leegov.com; Tom.Bailey@lcec.net; Dreycraft@leegov.com; ronald.o.smith@centurylink.com; craig.clark@centurylink.com
Cc: Kristin Caruso <kcaruso@scalarinc.net>; Andrews, Steven <Steven.Andrews@dot.state.fl.us>
Subject: 436928-1: Burnt Store Rd PD&E Study- Initial UAO coordination

Caution - External Email (wk Wong@scalarinc.net)

[Report This Email](#) [Tips](#)

FPN: 436928-1-22-01

**Description: Burnt Store Road (CR 765) from Van Buren Parkway to Charlotte County Line PD&E Study
County: Lee**

Good morning,

Scalar Consulting Group Inc. has been selected to represent the Florida Department of Transportation in utility coordination between the Department and your agency on the above referenced project.

In an effort to better coordinate the selection of corridor and typical alternatives for roadway widening, and their impact on utilities, I am providing for your review the corridor aerial base maps for the Burnt Store Road PD&E Study. The utilities owned by you may require relocation and/or adjustment as necessitated by the highway construction.

Please mark-up (using the standard FDOT color code) and return one (1) set of aerial maps indicating the location, size and type, etc., of your existing and any future facilities. The mark-up should also identify all known **EASEMENTS** or other lands of ownership rights. I am also requesting you to provide/prepare a rough cost estimate for relocation of your facilities (per mile basis is acceptable), indicating the impact you anticipate with your facilities.

Please also advise us in writing on your company letterhead if you do not have any existing or planned utility installations within the limits of this job.

In your correspondence to my office, please refer to the FPN and description as listed above. This information will need to be returned by **October 23, 2020**.

Thank you for your cooperation. The Department will make sure the information, which you have furnished, will be considered prior to establishing future corridor(s). Please feel free to contact me should you have any questions regarding the project or need any additional information.

The project file can be found in the link below:

Here's a OneDrive link to [436928-1 Burnt Store Road \(CR 765\) from Van Buren Parkway to Charlotte County Line PD&E Study](#).

If you have any issues opening the file, please feel free to reach out to me at (813)988-1199 or through my email at (wk Wong@scalarinc.net).

Kind Regards,

Winnie Kwong

<image001.png>

13337 North 56th Street

Tampa, Florida 33617

Ph: (813) 988-1199 Ext. 215

Cell: (561) 568-9676

wk Wong@scalarinc.net

This message is for the named person's use only. It may contain confidential, proprietary or legally privileged information. No confidentiality or privilege is waived or lost by any mistransmission. If you receive this message in error, please immediately delete it and all copies of it from your system, destroy any hard copies of it and notify the sender. You must not, directly or indirectly, use, disclose, distribute, print, or copy any part of this message if you are not the intended recipient.

This message is for the named person's use only. It may contain confidential, proprietary or legally privileged information. No confidentiality or privilege is waived or lost by any mistransmission. If you receive this message in error, please immediately delete it and all copies of it from your system, destroy

any hard copies of it and notify the sender. You must not, directly or indirectly, use, disclose, distribute, print, or copy any part of this message if you are not the intended recipient.

This message is for the named person's use only. It may contain confidential, proprietary or legally privileged information. No confidentiality or privilege is waived or lost by any mistransmission. If you receive this message in error, please immediately delete it and all copies of it from your system, destroy any hard copies of it and notify the sender. You must not, directly or indirectly, use, disclose, distribute, print, or copy any part of this message if you are not the intended recipient.

GREATER PINE ISLAND WATER ASSOCIATION

From: [Erik Iverson](#)
To: [Winnie Kwong](#),
Cc: "[Laurie Adams](#)"
Subject: RE: 436928-1: Burnt Store Rd PD&E Study- Initial UAO coordination
Date: Thursday, October 8, 2020 7:41:19 AM
Attachments: [image001.png](#)
[BURNT STORE PROJECT.docx](#)

Enclosed file is our response

From: Winnie Kwong, <wkwong@scalarinc.net>
Sent: Monday, September 28, 2020 3:52 PM
To: Eiverson@pineislandwater.com
Subject: FW: 436928-1: Burnt Store Rd PD&E Study- Initial UAO coordination

FPN: 436928-1-22-01

Description: Burnt Store Road (CR 765) from Van Buren Parkway to Charlotte County Line PD&E Study

County: Lee

Hi Erik,

As requested previously, I ran another ticket Sunshine811/EXACTIX ticket at the project location. The project ticket number is 269005577.

Please mark-up (using the standard FDOT color code) and return one (1) set of aerial maps indicating the location, size and type, etc., of your existing and any future facilities. The mark-up should also identify all known **EASEMENTS** or other lands of ownership rights. I am also requesting you to provide/prepare a rough cost estimate for relocation of your facilities (per mile basis is acceptable), indicating the impact you anticipate with your facilities.

Please also advise us in writing on your company letterhead if you do not have any existing or planned utility installations within the limits of this job.

This information will need to be returned by **October 23, 2020**.

Please let me know if you need anything from my end.

Kind Regards,

Winnie Kwong, E.I.



**13337 North 56th Street
Tampa, Florida 33617
Ph: (813) 988-1199 Ext. 215
Cell: (561) 568-9676**

wk Wong@scalarinc.net

From: Winnie Kwong,

Sent: Wednesday, September 23, 2020 11:34 AM

To: tshevche@capecoral.net; Andy.Amendola@CharlotteCountyFL.gov; Maxwell-Newbold, Leonard <leonard_maxwell-newbold@comcast.com>; russb@broadstar.com; Bray, Joel <Joel.Bray@fpl.com>; Haskett, Danny <Danny.Haskett@crowncastle.com>; bruce.bullert@charlottefl.com; Eiverson@pineislandwater.com; ucdinfo@capecoral.net; Rkirsch@leegov.com; Tom.Bailey@lcec.net; Dreycraft@leegov.com; ronald.o.smith@centurylink.com; craig.clark@centurylink.com

Cc: Kristin Caruso <kcaruso@scalarinc.net>; Andrews, Steven <Steven.Andrews@dot.state.fl.us>

Subject: 436928-1: Burnt Store Rd PD&E Study- Initial UAO coordination

FPN: 436928-1-22-01

Description: Burnt Store Road (CR 765) from Van Buren Parkway to Charlotte County Line PD&E Study

County: Lee

Good morning,

Scalar Consulting Group Inc. has been selected to represent the Florida Department of Transportation in utility coordination between the Department and your agency on the above referenced project.

In an effort to better coordinate the selection of corridor and typical alternatives for roadway widening, and their impact on utilities, I am providing for your review the corridor aerial base maps for the Burnt Store Road PD&E Study. The utilities owned by you may require relocation and/or adjustment as necessitated by the highway construction.

Please mark-up (using the standard FDOT color code) and return one (1) set of aerial maps indicating the location, size and type, etc., of your existing and any future facilities. The mark-up should also identify all known **EASEMENTS** or other lands of ownership rights. I am also requesting you to provide/prepare a rough cost estimate for relocation of your facilities (per mile basis is acceptable), indicating the impact you anticipate with your facilities.

Please also advise us in writing on your company letterhead if you do not have any existing or planned utility installations within the limits of this job.

In your correspondence to my office, please refer to the FPN and description as listed above. This information will need to be returned by **October 23, 2020**.

Thank you for your cooperation. The Department will make sure the information, which you have

furnished, will be considered prior to establishing future corridor(s). Please feel free to contact me should you have any questions regarding the project or need any additional information.

The project file can be found in the link below:

Here's a OneDrive link to [436928-1 Burnt Store Road \(CR 765\) from Van Buren Parkway to Charlotte County Line PD&E Study](#).

If you have any issues opening the file, please feel free to reach out to me at (813)988-1199 or through my email at (wkwong@scalarinc.net).

Kind Regards,

Winnie Kwong



13337 North 56th Street

Tampa, Florida 33617

Ph: (813) 988-1199 Ext. 215

Cell: (561) 568-9676

wkwong@scalarinc.net

This message is for the named person's use only. It may contain confidential, proprietary or legally privileged information. No confidentiality or privilege is waived or lost by any mistransmission. If you receive this message in error, please immediately delete it and all copies of it from your system, destroy any hard copies of it and notify the sender. You must not, directly or indirectly, use, disclose, distribute, print, or copy any part of this message if you are not the intended recipient.



Greater Pine Island Water Association Inc.

Winnie,

In response to your email dated 9/28/2020, Greater Pine Island Water does not have any existing or planned installations within the limits of this job. The area requested is out of our franchise area.

Thanks,

Erik Iverson

Distribution Supervisor

www.pineislandwater.com

5281 Pine Island Rd.

Bokeelia Fl 33922

Ph: 239-283-1071 or 239-673-0880

eiverson@pineislandwater.com



Greater
Pine Island
Water Association, Inc.

LEE COUNTY ELECTRIC COOPERATIVE

From: [Lanman, Keith](#)
To: [Winnie Kwong](#),
Subject: FW: 436928-1: Burnt Store Rd PD&E Study- Initial UAO coordination
Date: Wednesday, September 30, 2020 6:17:02 AM
Attachments: [image001.png](#)
[436928-1-22-01-1.pdf](#)

Hello Winnie:

Please see attached. 1 of 4.

Thanks

Keith Lanman
LCEC – Distribution Design

From: Bailey, Tom <Tom.Bailey@lcec.net>
Sent: Wednesday, September 23, 2020 12:36 PM
To: Lanman, Keith <Keith.Lanman@lcec.net>
Subject: FW: 436928-1: Burnt Store Rd PD&E Study- Initial UAO coordination

Keith,
Please take a look at this.

Thanks,

Tom

From: Winnie Kwong, <wk Wong@scalarinc.net>
Sent: Wednesday, September 23, 2020 11:34 AM
To: tshevche@capecoral.net; Andy.Amendola@CharlotteCountyFL.gov; Maxwell-Newbold, Leonard <leonard_maxwell-newbold@comcast.com>; russb@broadstar.com; Bray, Joel <Joel.Bray@fpl.com>; Haskett, Danny <Danny.Haskett@crowncastle.com>; bruce.bullert@charlottefl.com; Eiverson@pineislandwater.com; ucdinfo@capecoral.net; Rkirsch@leegov.com; Bailey, Tom <Tom.Bailey@lcec.net>; Dreycraft@leegov.com; ronald.o.smith@centurylink.com; craig.clark@centurylink.com
Cc: Kristin Caruso <kcaruso@scalarinc.net>; Andrews, Steven <Steven.Andrews@dot.state.fl.us>
Subject: 436928-1: Burnt Store Rd PD&E Study- Initial UAO coordination

***** WARNING:** This is an EXTERNAL email. DO NOT open attachments or click links from unknown senders or unexpected email. ***

FPN: 436928-1-22-01

Description: Burnt Store Road (CR 765) from Van Buren Parkway to Charlotte County Line PD&E Study

County: Lee

Good morning,

Scalar Consulting Group Inc. has been selected to represent the Florida Department of Transportation in utility coordination between the Department and your agency on the above referenced project.

In an effort to better coordinate the selection of corridor and typical alternatives for roadway widening, and their impact on utilities, I am providing for your review the corridor aerial base maps for the Burnt Store Road PD&E Study. The utilities owned by you may require relocation and/or adjustment as necessitated by the highway construction.

Please mark-up (using the standard FDOT color code) and return one (1) set of aerial maps indicating the location, size and type, etc., of your existing and any future facilities. The mark-up should also identify all known **EASEMENTS** or other lands of ownership rights. I am also requesting you to provide/prepare a rough cost estimate for relocation of your facilities (per mile basis is acceptable), indicating the impact you anticipate with your facilities.

Please also advise us in writing on your company letterhead if you do not have any existing or planned utility installations within the limits of this job.

In your correspondence to my office, please refer to the FPN and description as listed above. This information will need to be returned by **October 23, 2020**.

Thank you for your cooperation. The Department will make sure the information, which you have furnished, will be considered prior to establishing future corridor(s). Please feel free to contact me should you have any questions regarding the project or need any additional information.

The project file can be found in the link below:

Here's a OneDrive link to [436928-1 Burnt Store Road \(CR 765\) from Van Buren Parkway to Charlotte County Line PD&E Study](#).

If you have any issues opening the file, please feel free to reach out to me at (813)988-1199 or through my email at (wkwong@scalarinc.net).

Kind Regards,

Winnie Kwong



**13337 North 56th Street
Tampa, Florida 33617
Ph: (813) 988-1199 Ext. 215**

Cell: (561) 568-9676

wk Wong@scalarinc.net

This message is for the named person's use only. It may contain confidential, proprietary or legally privileged information. No confidentiality or privilege is waived or lost by any mistransmission. If you receive this message in error, please immediately delete it and all copies of it from your system, destroy any hard copies of it and notify the sender. You must not, directly or indirectly, use, disclose, distribute, print, or copy any part of this message if you are not the intended recipient.

COMPONENTS OF CONTRACT PLANS SET
ROADWAY PLANS

STATE OF FLORIDA
DEPARTMENT OF TRANSPORTATION



CONTRACT PLANS

FINANCIAL PROJECT ID 436928-1-22-01

LEE COUNTY
COUNTY ROAD NO. CR 765


INDEX OF ROADWAY PLANS

SHEET NO.	SHEET DESCRIPTION
1	KEY SHEET
2 - 41	ROADWAY PLAN

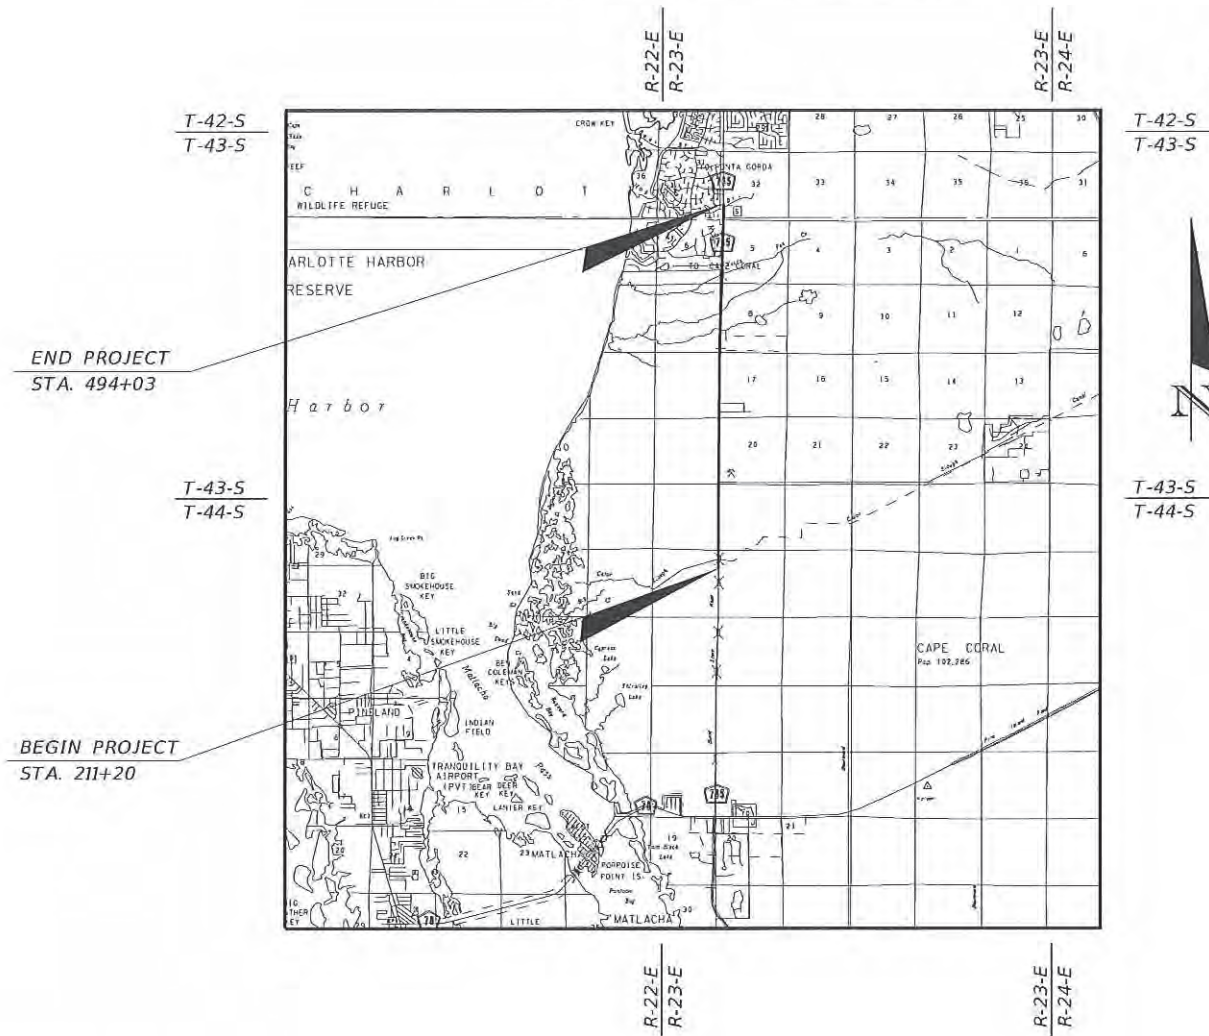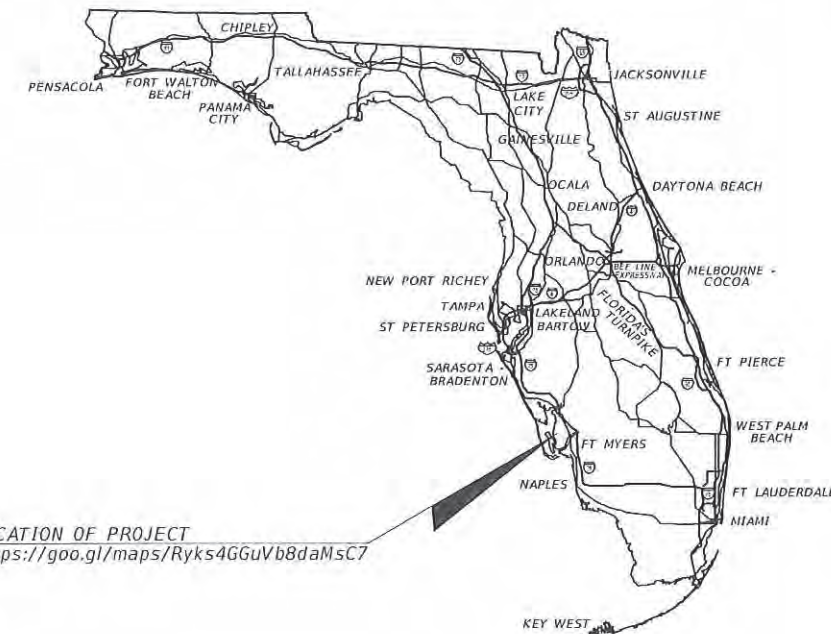

LOCATION OF PROJECT
<https://goo.gl/maps/Ryks4GGuVb8daMsc7>

GREENLINES SUBMITTAL
SEPTEMBER 2020

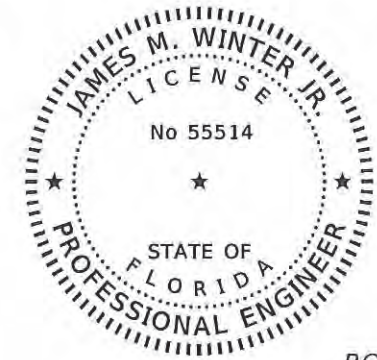

THIS ITEM HAS BEEN DIGITALLY
SIGNED AND SEALED BY

ON THE DATE ADJACENT TO THE SEAL
PRINTED COPIES OF THIS DOCUMENT ARE
NOT CONSIDERED SIGNED AND SEALED
AND THE SIGNATURE MUST BE VERIFIED
ON ANY ELECTRONIC COPIES.

ROADWAY PLANS
ENGINEER OF RECORD:

JAMES M. WINTER, JR., P.E.
P.E. LICENSE NUMBER 55514
SCALAR CONSULTING GROUP INC.
13337 N. 56TH STREET
TAMPA, FLORIDA 33617

FDOT PROJECT MANAGER:
STEVEN A. ANDREWS

GOVERNING STANDARD PLANS:
Florida Department of Transportation, FY 2020-21 Standard Plans for Road and Bridge Construction and applicable Interim Revisions (IRs).


Standard Plans for Road Construction and associated IRs are available at the following website: <http://www.fdot.gov/design/standardplans>

GOVERNING STANDARD SPECIFICATIONS:
Florida Department of Transportation, 2020 Standard Specifications for Road and Bridge Construction at the following website: <http://www.fdot.gov/programmanagement/Implemented/SpecBooks>

CONSTRUCTION CONTRACT NO.	FISCAL YEAR	SHEET NO.
		1

9/10/2020 4:37:53 PM USER: Guest1 C:\Work\seis\FDOT\436928\12201\roadway\KEY\SRD01.dgn

NOTICE: THE OFFICIAL RECORD OF THIS SHEET IS THE ELECTRONIC FILE SIGNED AND SEALED UNDER RULE 61G15-23.003, F.A.C.

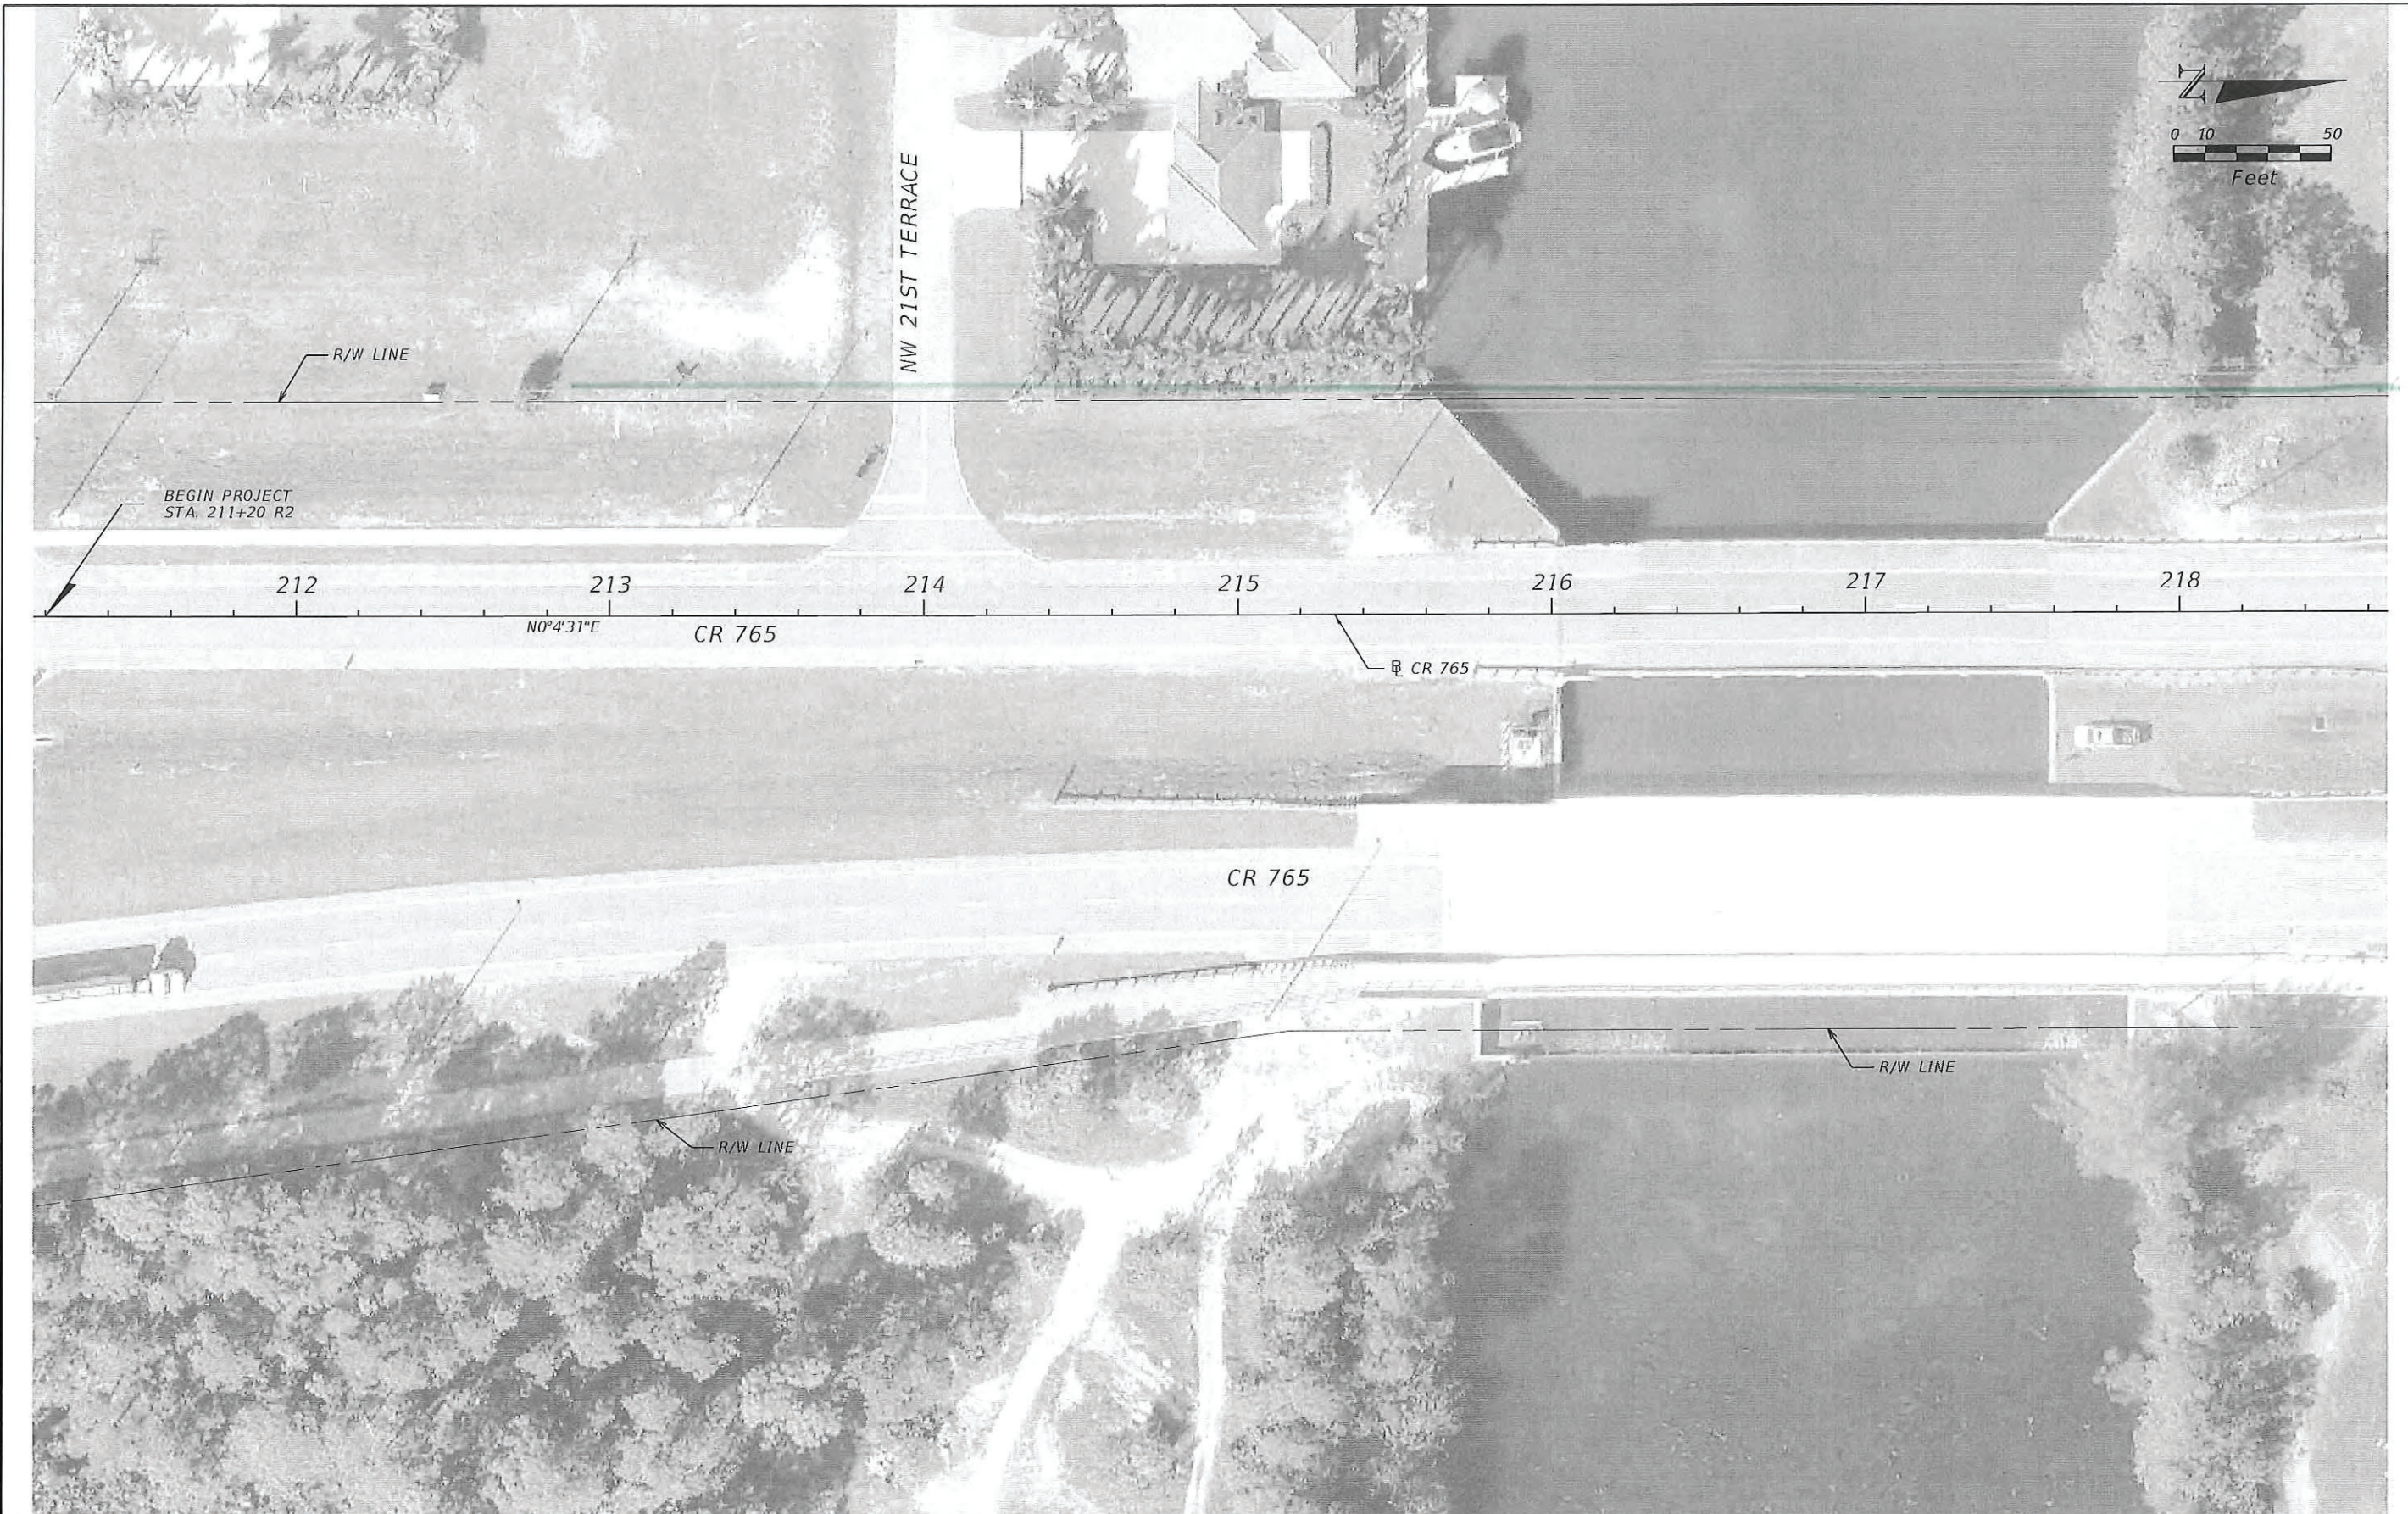

9/10/2020 4:37:59 PM Guest1
 C:\workspaces\FDOT\43692812201\roadway\Plan_1.dgn

THE OFFICIAL RECORD OF THIS SHEET IS THE ELECTRONIC FILE DIGITALLY SIGNED AND SEALED UNDER RULE 61G15-23.004, F.A.C.



REVISIONS				ENGINEER OF RECORD	STATE OF FLORIDA DEPARTMENT OF TRANSPORTATION			ROADWAY PLAN (1)	SHEET NO.
DATE	DESCRIPTION	DATE	DESCRIPTION		ROAD NO.	COUNTY	FINANCIAL PROJECT ID		
				JAMES M. WINTER, JR., P.E. LICENSE NUMBER 55514 SCALAR CONSULTING GROUP INC. 13337 N. 56TH STREET TAMPA, FLORIDA 33617	CR 765	LEE	436928-1-22-01		2



9/10/2020 4:36:09 PM Guest1
 C:\worksets\FDOT\43692812201\roadway\Plan 2.dgn

THE OFFICIAL RECORD OF THIS SHEET IS THE ELECTRONIC FILE DIGITALLY SIGNED AND SEALED UNDER RULE 61G15-23.004, F.A.C.

REVISIONS				ENGINEER OF RECORD		STATE OF FLORIDA DEPARTMENT OF TRANSPORTATION			ROADWAY PLAN (2)	SHEET NO.
DATE	DESCRIPTION	DATE	DESCRIPTION	JAMES M. WINTER, JR., P.E. LICENSE NUMBER 55514 SCALAR CONSULTING GROUP INC. 13337 N. 56TH STREET TAMPA, FLORIDA 33617		ROAD NO.	COUNTY	FINANCIAL PROJECT ID		
						CR 765	LEE	436928-1-22-01		3

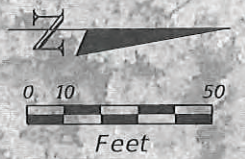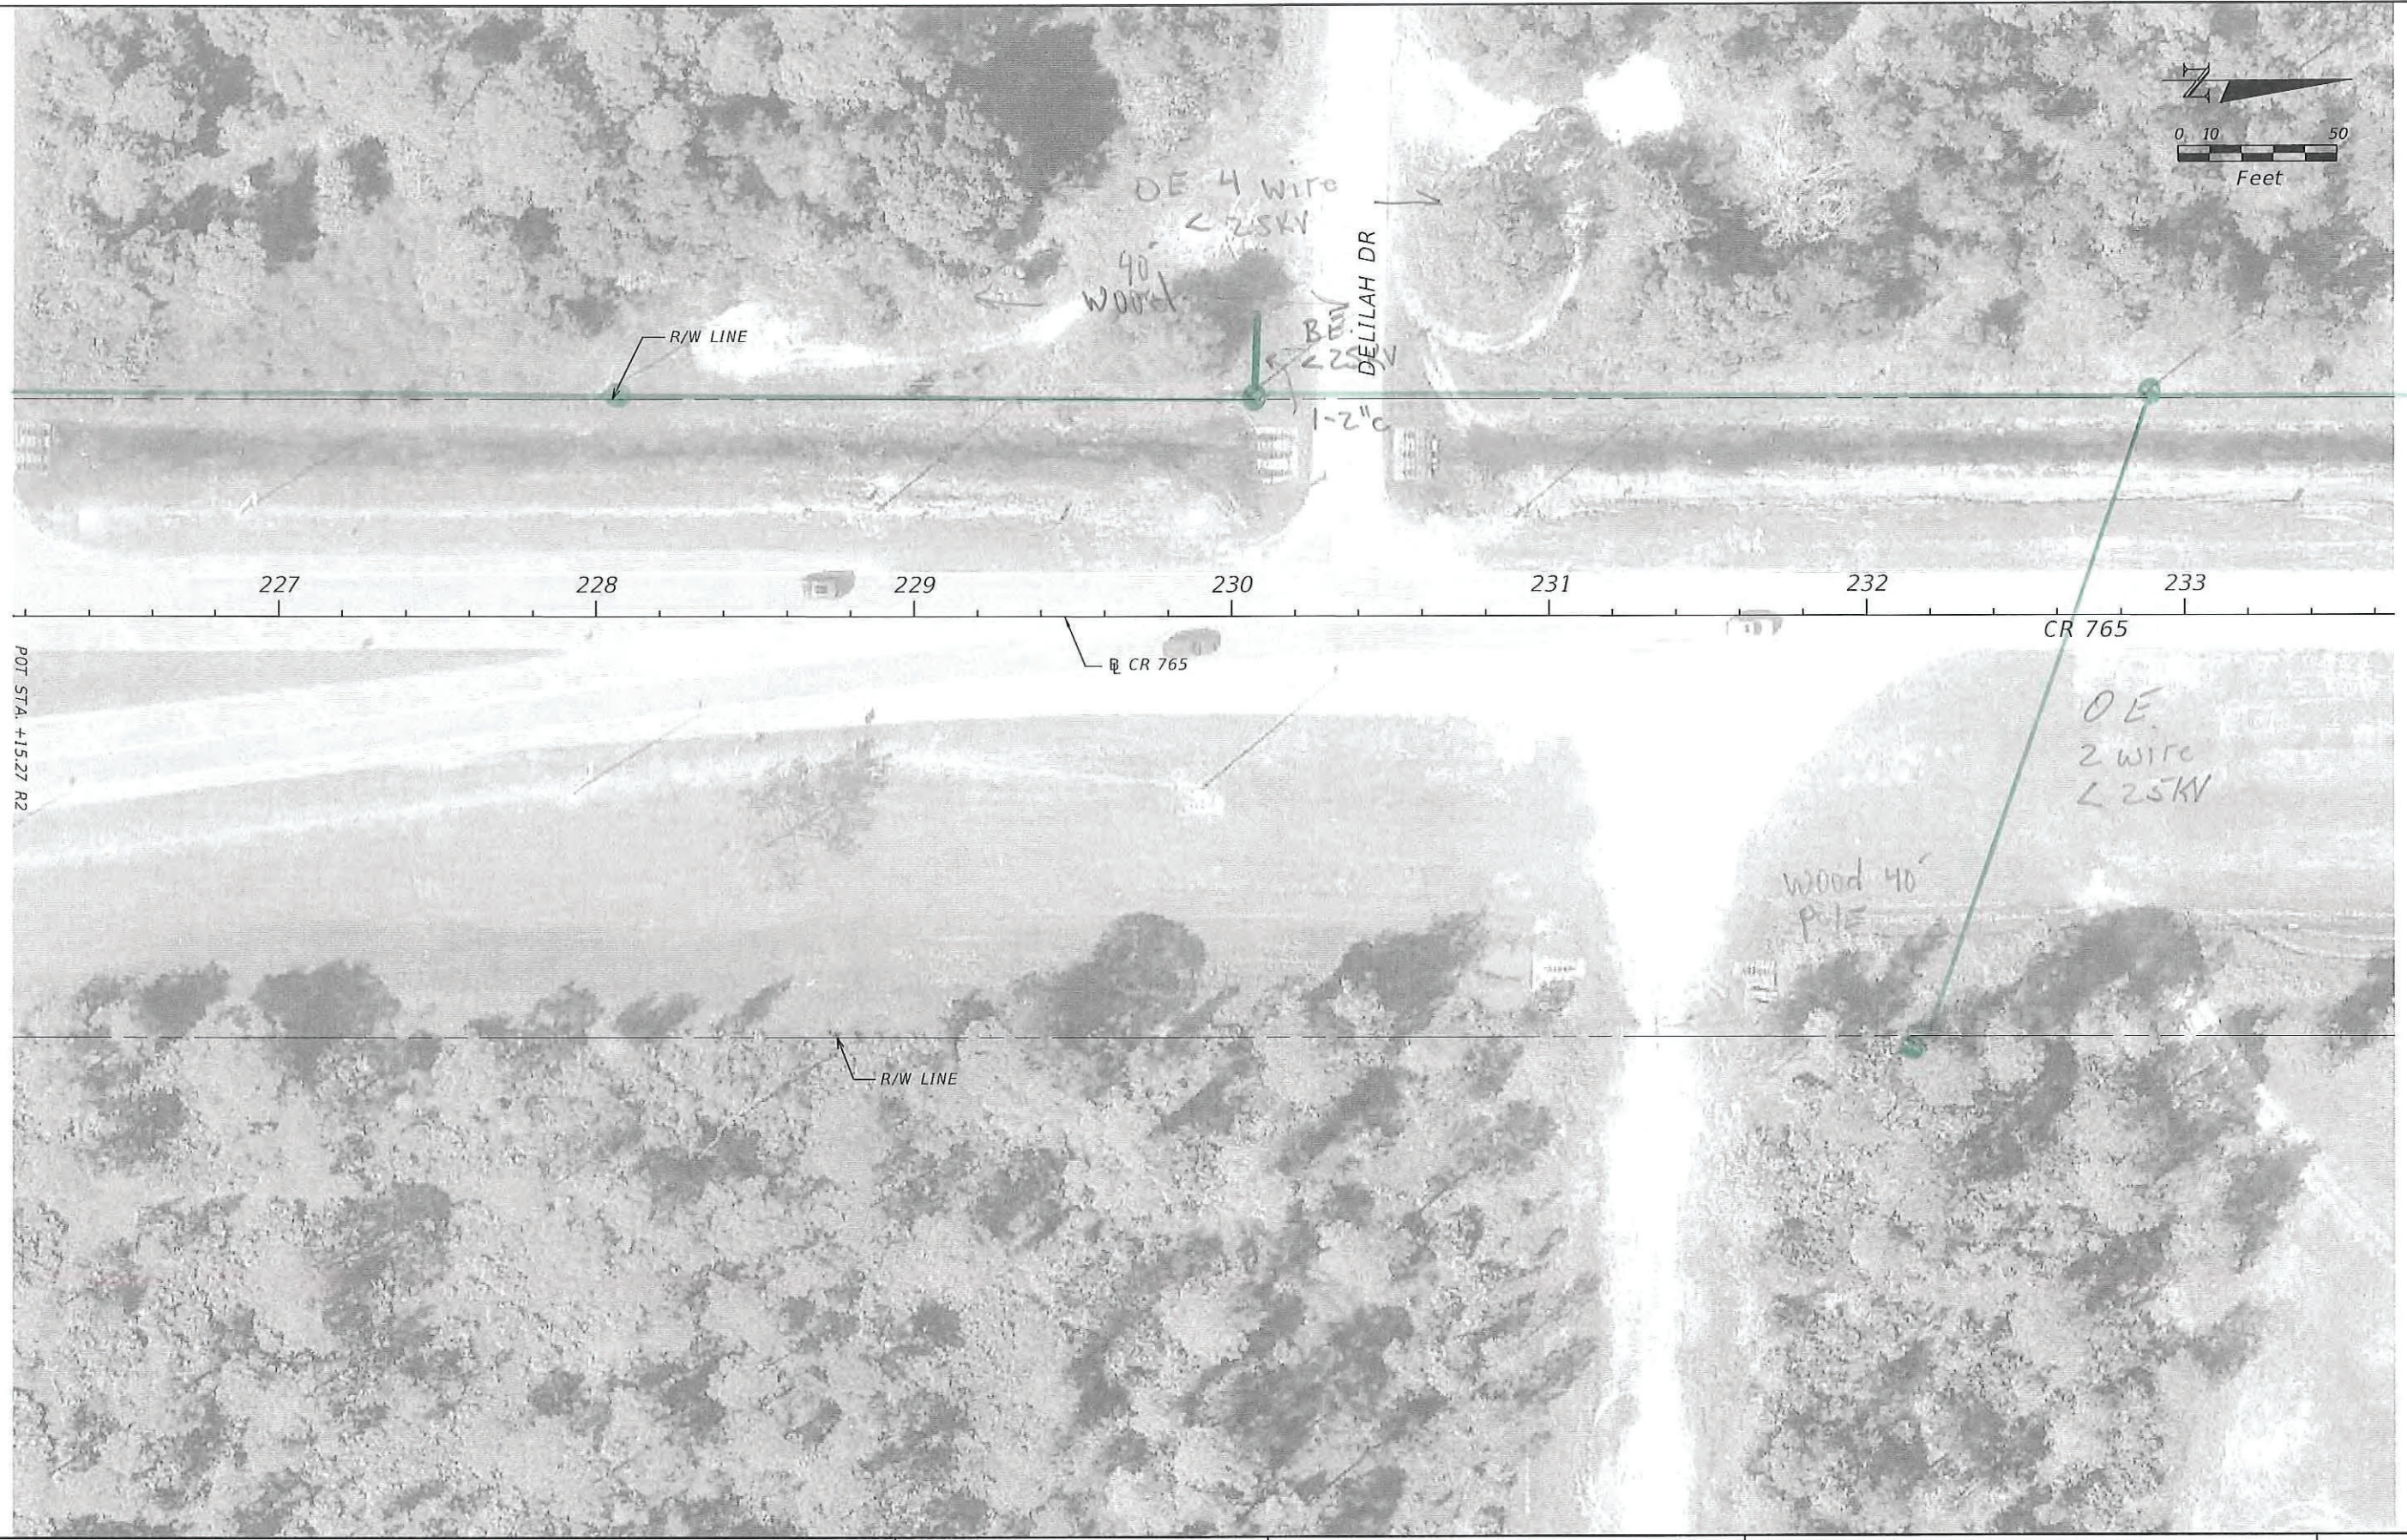


POT STA. +15.27 R2

9/10/2020 4:38:19 PM Guest1
 C:\work\seis\DOT\43692812201\rcadway\Plan 3.dgn

THE OFFICIAL RECORD OF THIS SHEET IS THE ELECTRONIC FILE DIGITALLY SIGNED AND SEALED UNDER RULE 61G15-23.004, F.A.C.



REVISIONS				ENGINEER OF RECORD		STATE OF FLORIDA DEPARTMENT OF TRANSPORTATION			ROADWAY PLAN (3)	SHEET NO.
DATE	DESCRIPTION	DATE	DESCRIPTION	JAMES M. WINTER, JR., P.E. LICENSE NUMBER 55514 SCALAR CONSULTING GROUP INC. 13337 N. 56TH STREET TAMPA, FLORIDA 33617		ROAD NO.	COUNTY	FINANCIAL PROJECT ID		
						CR 765	LEE	436928-1-22-01		4

9/10/2020 4:36:30 PM Guest1
 C:\Worksets\FDOT\436928\12201\Roadway\Plan 4.dgn

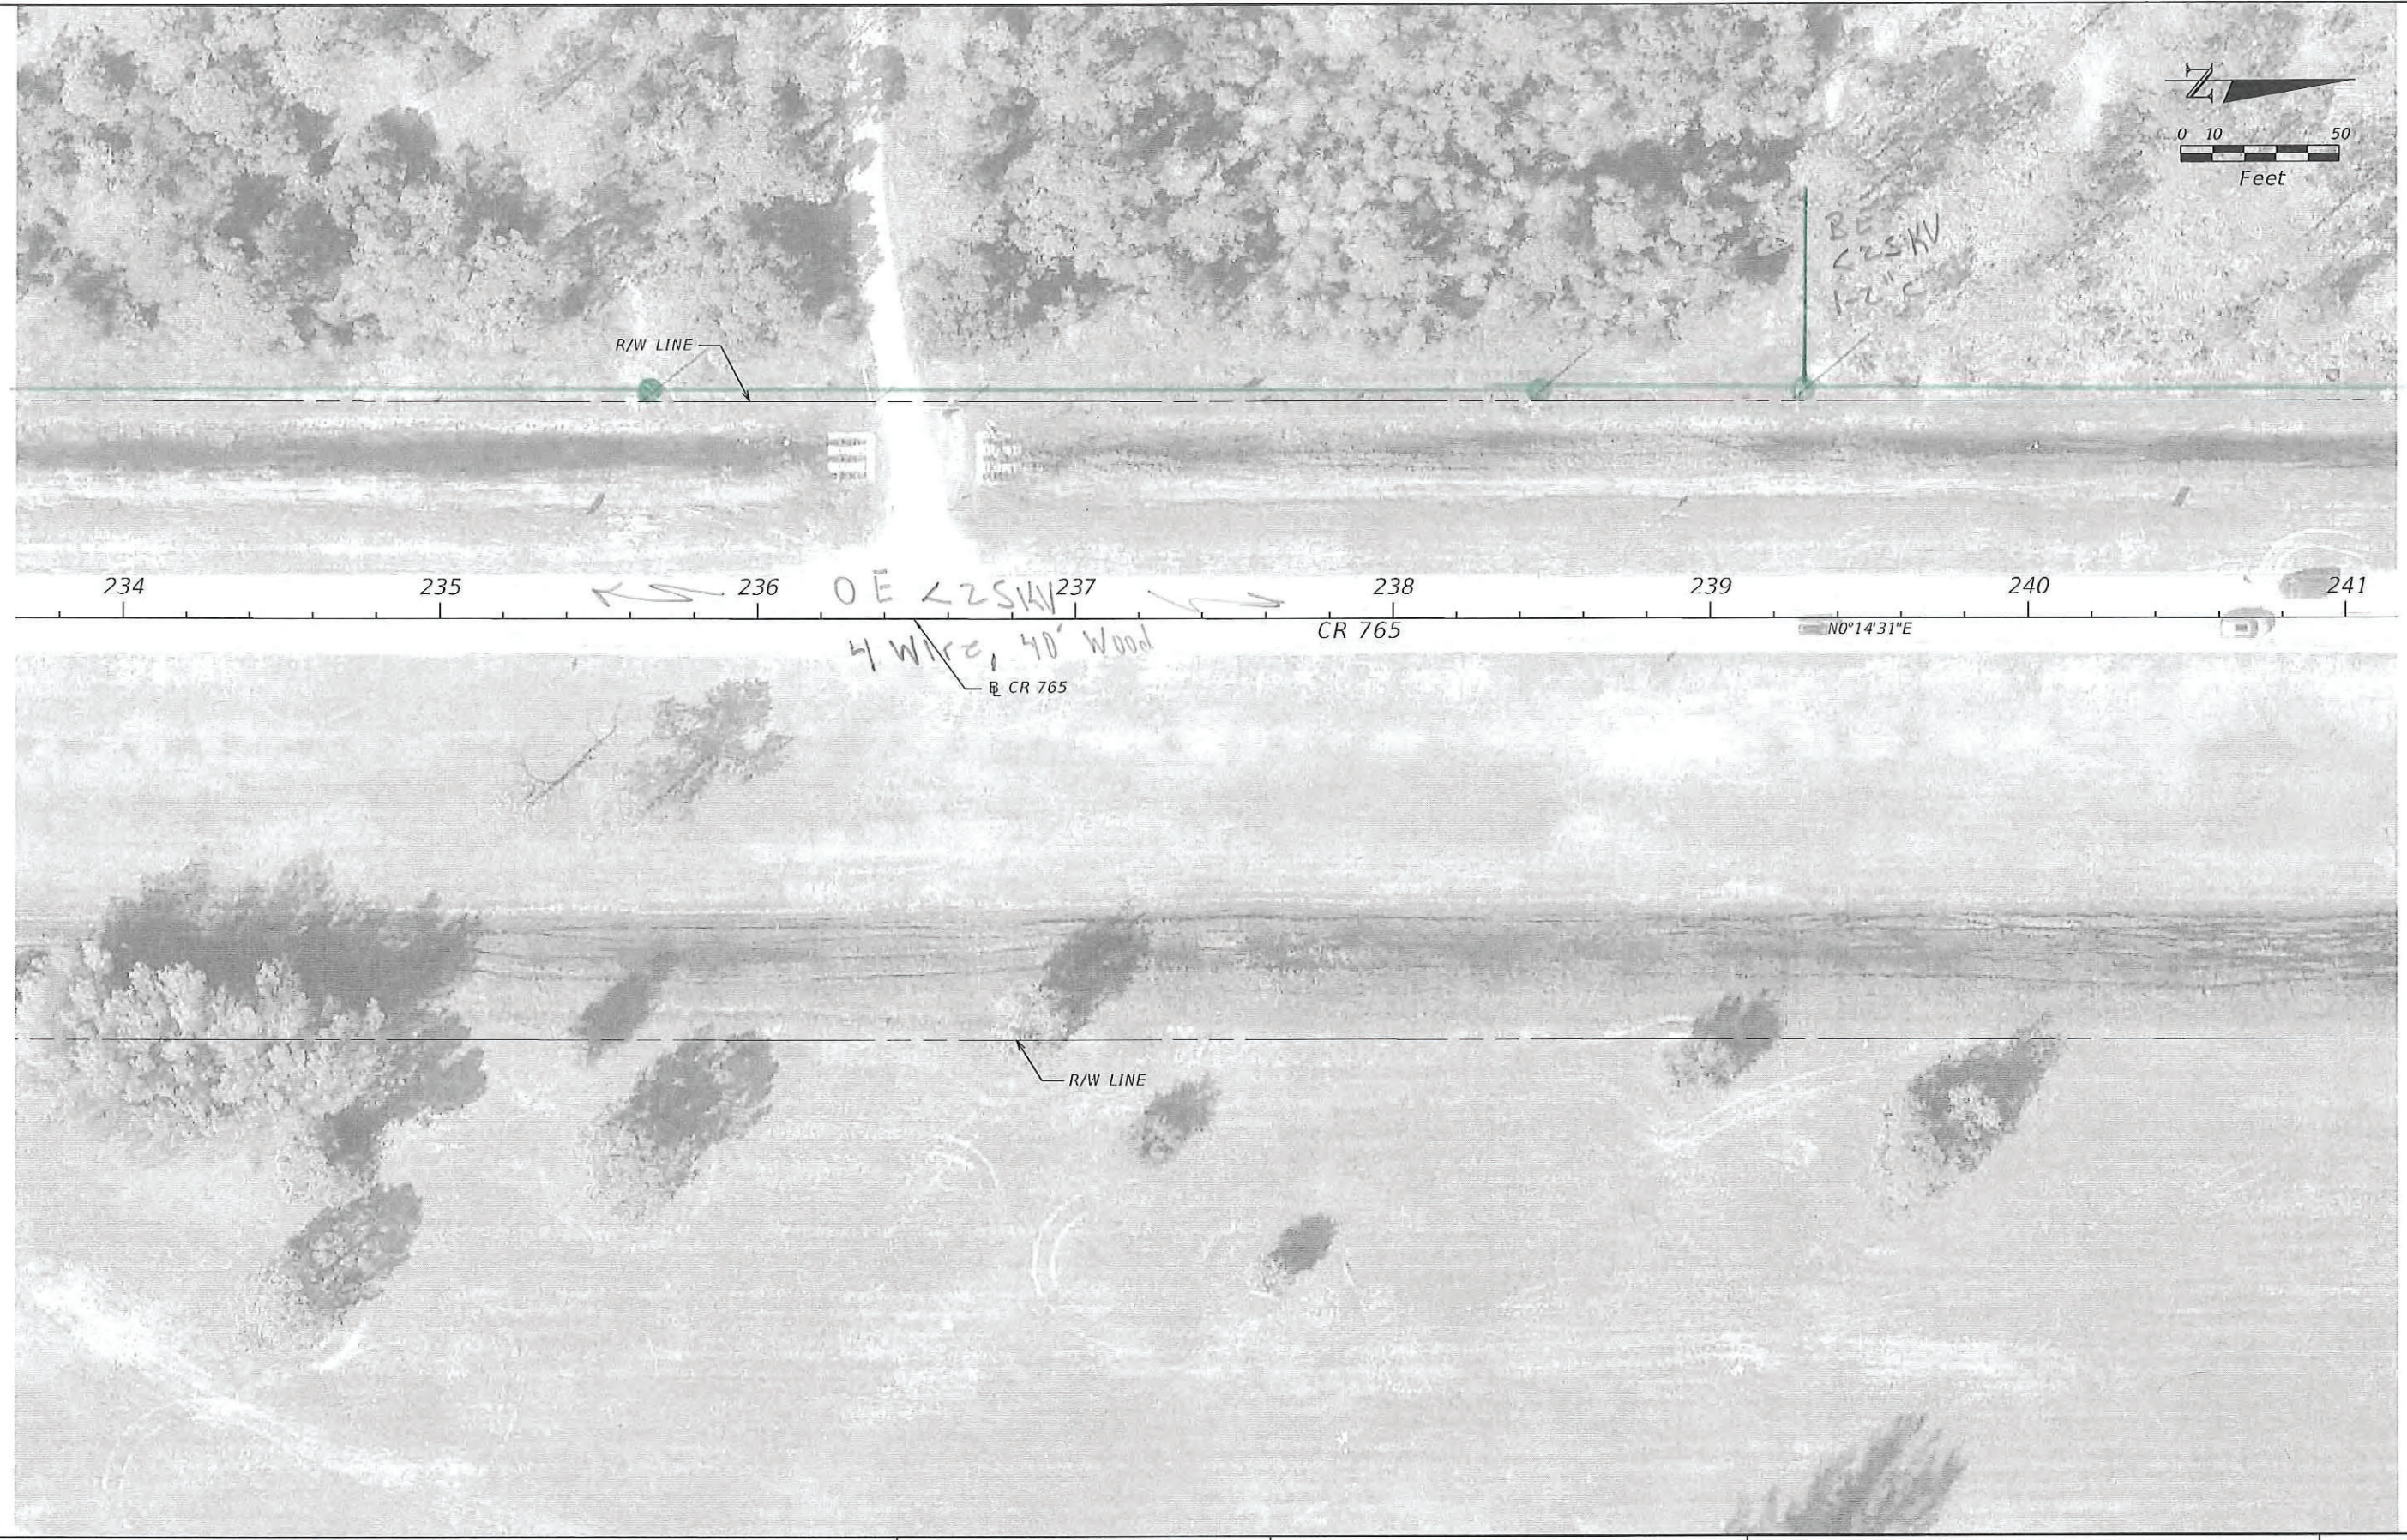

REVISIONS				ENGINEER OF RECORD		STATE OF FLORIDA DEPARTMENT OF TRANSPORTATION			ROADWAY PLAN (4)	SHEET NO.
DATE	DESCRIPTION	DATE	DESCRIPTION	JAMES M. WINTER, JR., P.E. LICENSE NUMBER 55514 SCALAR CONSULTING GROUP INC. 13337 N. 56TH STREET TAMPA, FLORIDA 33617		ROAD NO.	COUNTY	FINANCIAL PROJECT ID		
						CR 765	LEE	436928-1-22-01		5


THE OFFICIAL RECORD OF THIS SHEET IS THE ELECTRONIC FILE DIGITALLY SIGNED AND SEALED UNDER RULE 61G15-23.004, F.A.C.

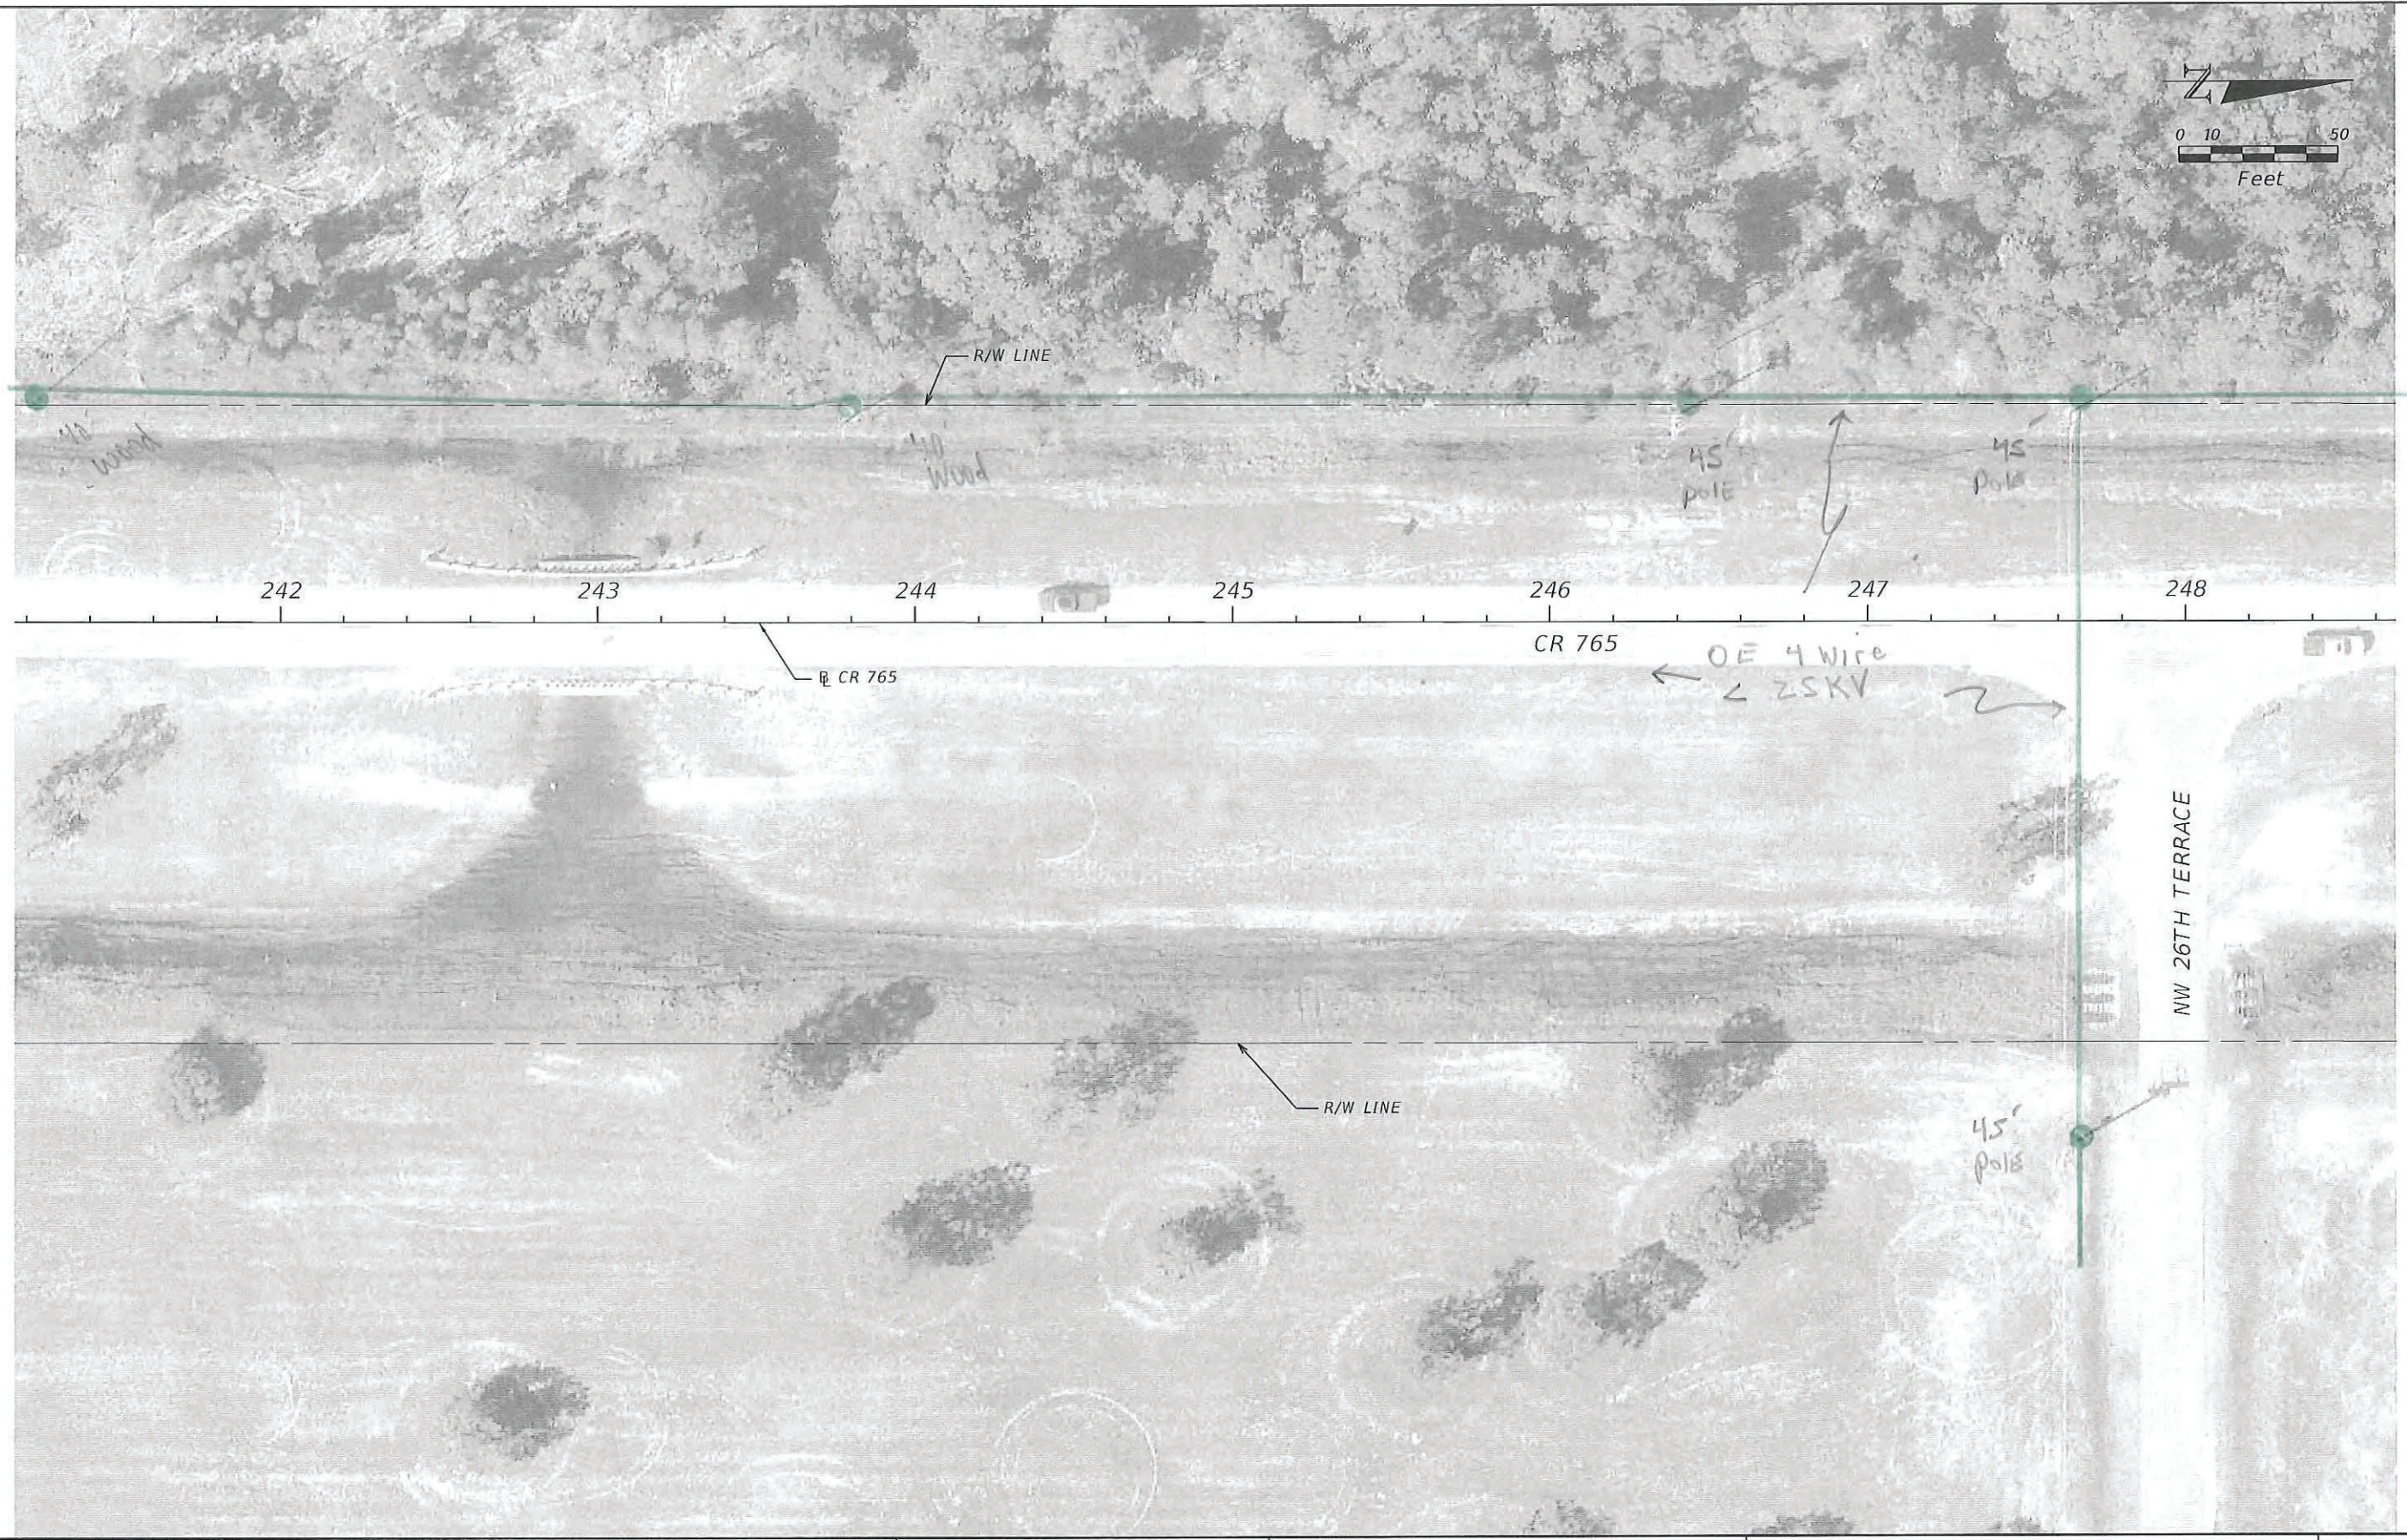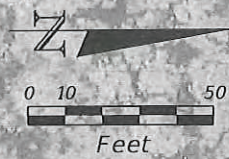

9/10/2020 4:38:39 PM Guest1
 C:\worksets\FDOT\43692812201\roadway\Plan 5.dgn

REVISIONS				ENGINEER OF RECORD		STATE OF FLORIDA DEPARTMENT OF TRANSPORTATION			ROADWAY PLAN (5)	SHEET NO. 6
DATE	DESCRIPTION	DATE	DESCRIPTION	JAMES M. WINTER, JR., P.E. LICENSE NUMBER 55514 SCALAR CONSULTING GROUP INC. 13337 N. 56TH STREET TAMPA, FLORIDA 33617		ROAD NO.	COUNTY	FINANCIAL PROJECT ID		
				CR 765	LEE	436928-1-22-01				


THE OFFICIAL RECORD OF THIS SHEET IS THE ELECTRONIC FILE DIGITALLY SIGNED AND SEALED UNDER RULE 61G15-23.004, F.A.C.

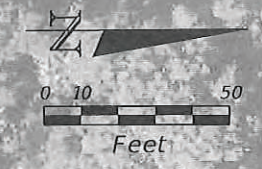

9/10/2020 4:36:48 PM Guest1
 C:\worksets\FDOT\43692812201\roadway\Plan 6.dgn

REVISIONS				ENGINEER OF RECORD		STATE OF FLORIDA DEPARTMENT OF TRANSPORTATION			ROADWAY PLAN (6)	SHEET NO.
DATE	DESCRIPTION	DATE	DESCRIPTION	ROAD NO. COUNTY FINANCIAL PROJECT ID						
				JAMES M. WINTER, JR., P.E. LICENSE NUMBER 55514 SCALAR CONSULTING GROUP INC. 13337 N. 56TH STREET TAMPA, FLORIDA 33617		CR 765	LEE	436928-1-22-01		7

THE OFFICIAL RECORD OF THIS SHEET IS THE ELECTRONIC FILE DIGITALLY SIGNED AND SEALED UNDER RULE 61G15-23.004, F.A.C.

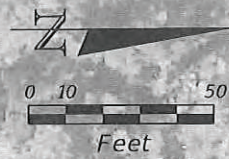

9/10/2020 4:36:58 PM Guest1
 C:\Worksets\FDOT\43692812201\Roadway\Plan 7.dgn

THE OFFICIAL RECORD OF THIS SHEET IS THE ELECTRONIC FILE DIGITALLY SIGNED AND SEALED UNDER RULE 61G15-23.004, F.A.C.


REVISIONS				ENGINEER OF RECORD		STATE OF FLORIDA DEPARTMENT OF TRANSPORTATION			ROADWAY PLAN (7)	SHEET NO.
DATE	DESCRIPTION	DATE	DESCRIPTION	JAMES M. WINTER, JR., P.E. LICENSE NUMBER 55514 SCALAR CONSULTING GROUP INC. 13337 N. 56TH STREET TAMPA, FLORIDA 33617		ROAD NO.	COUNTY	FINANCIAL PROJECT ID		
						CR 765	LEE	436928-1-22-01		8



9/10/2020 4:46:32 PM Guest1
 C:\Worksets\FDOT\4369281220\Roadway\Plan 8.dgn

THE OFFICIAL RECORD OF THIS SHEET IS THE ELECTRONIC FILE DIGITALLY SIGNED AND SEALED UNDER RULE 61G15-23.004, F.A.C.

REVISIONS				ENGINEER OF RECORD	STATE OF FLORIDA DEPARTMENT OF TRANSPORTATION			ROADWAY PLAN (8)	SHEET NO.
DATE	DESCRIPTION	DATE	DESCRIPTION		ROAD NO.	COUNTY	FINANCIAL PROJECT ID		
				JAMES M. WINTER, JR., P.E. LICENSE NUMBER 55514 SCALAR CONSULTING GROUP INC. 13337 N. 56TH STREET TAMPA, FLORIDA 33617	CR 765	LEE	436928-1-22-01		9

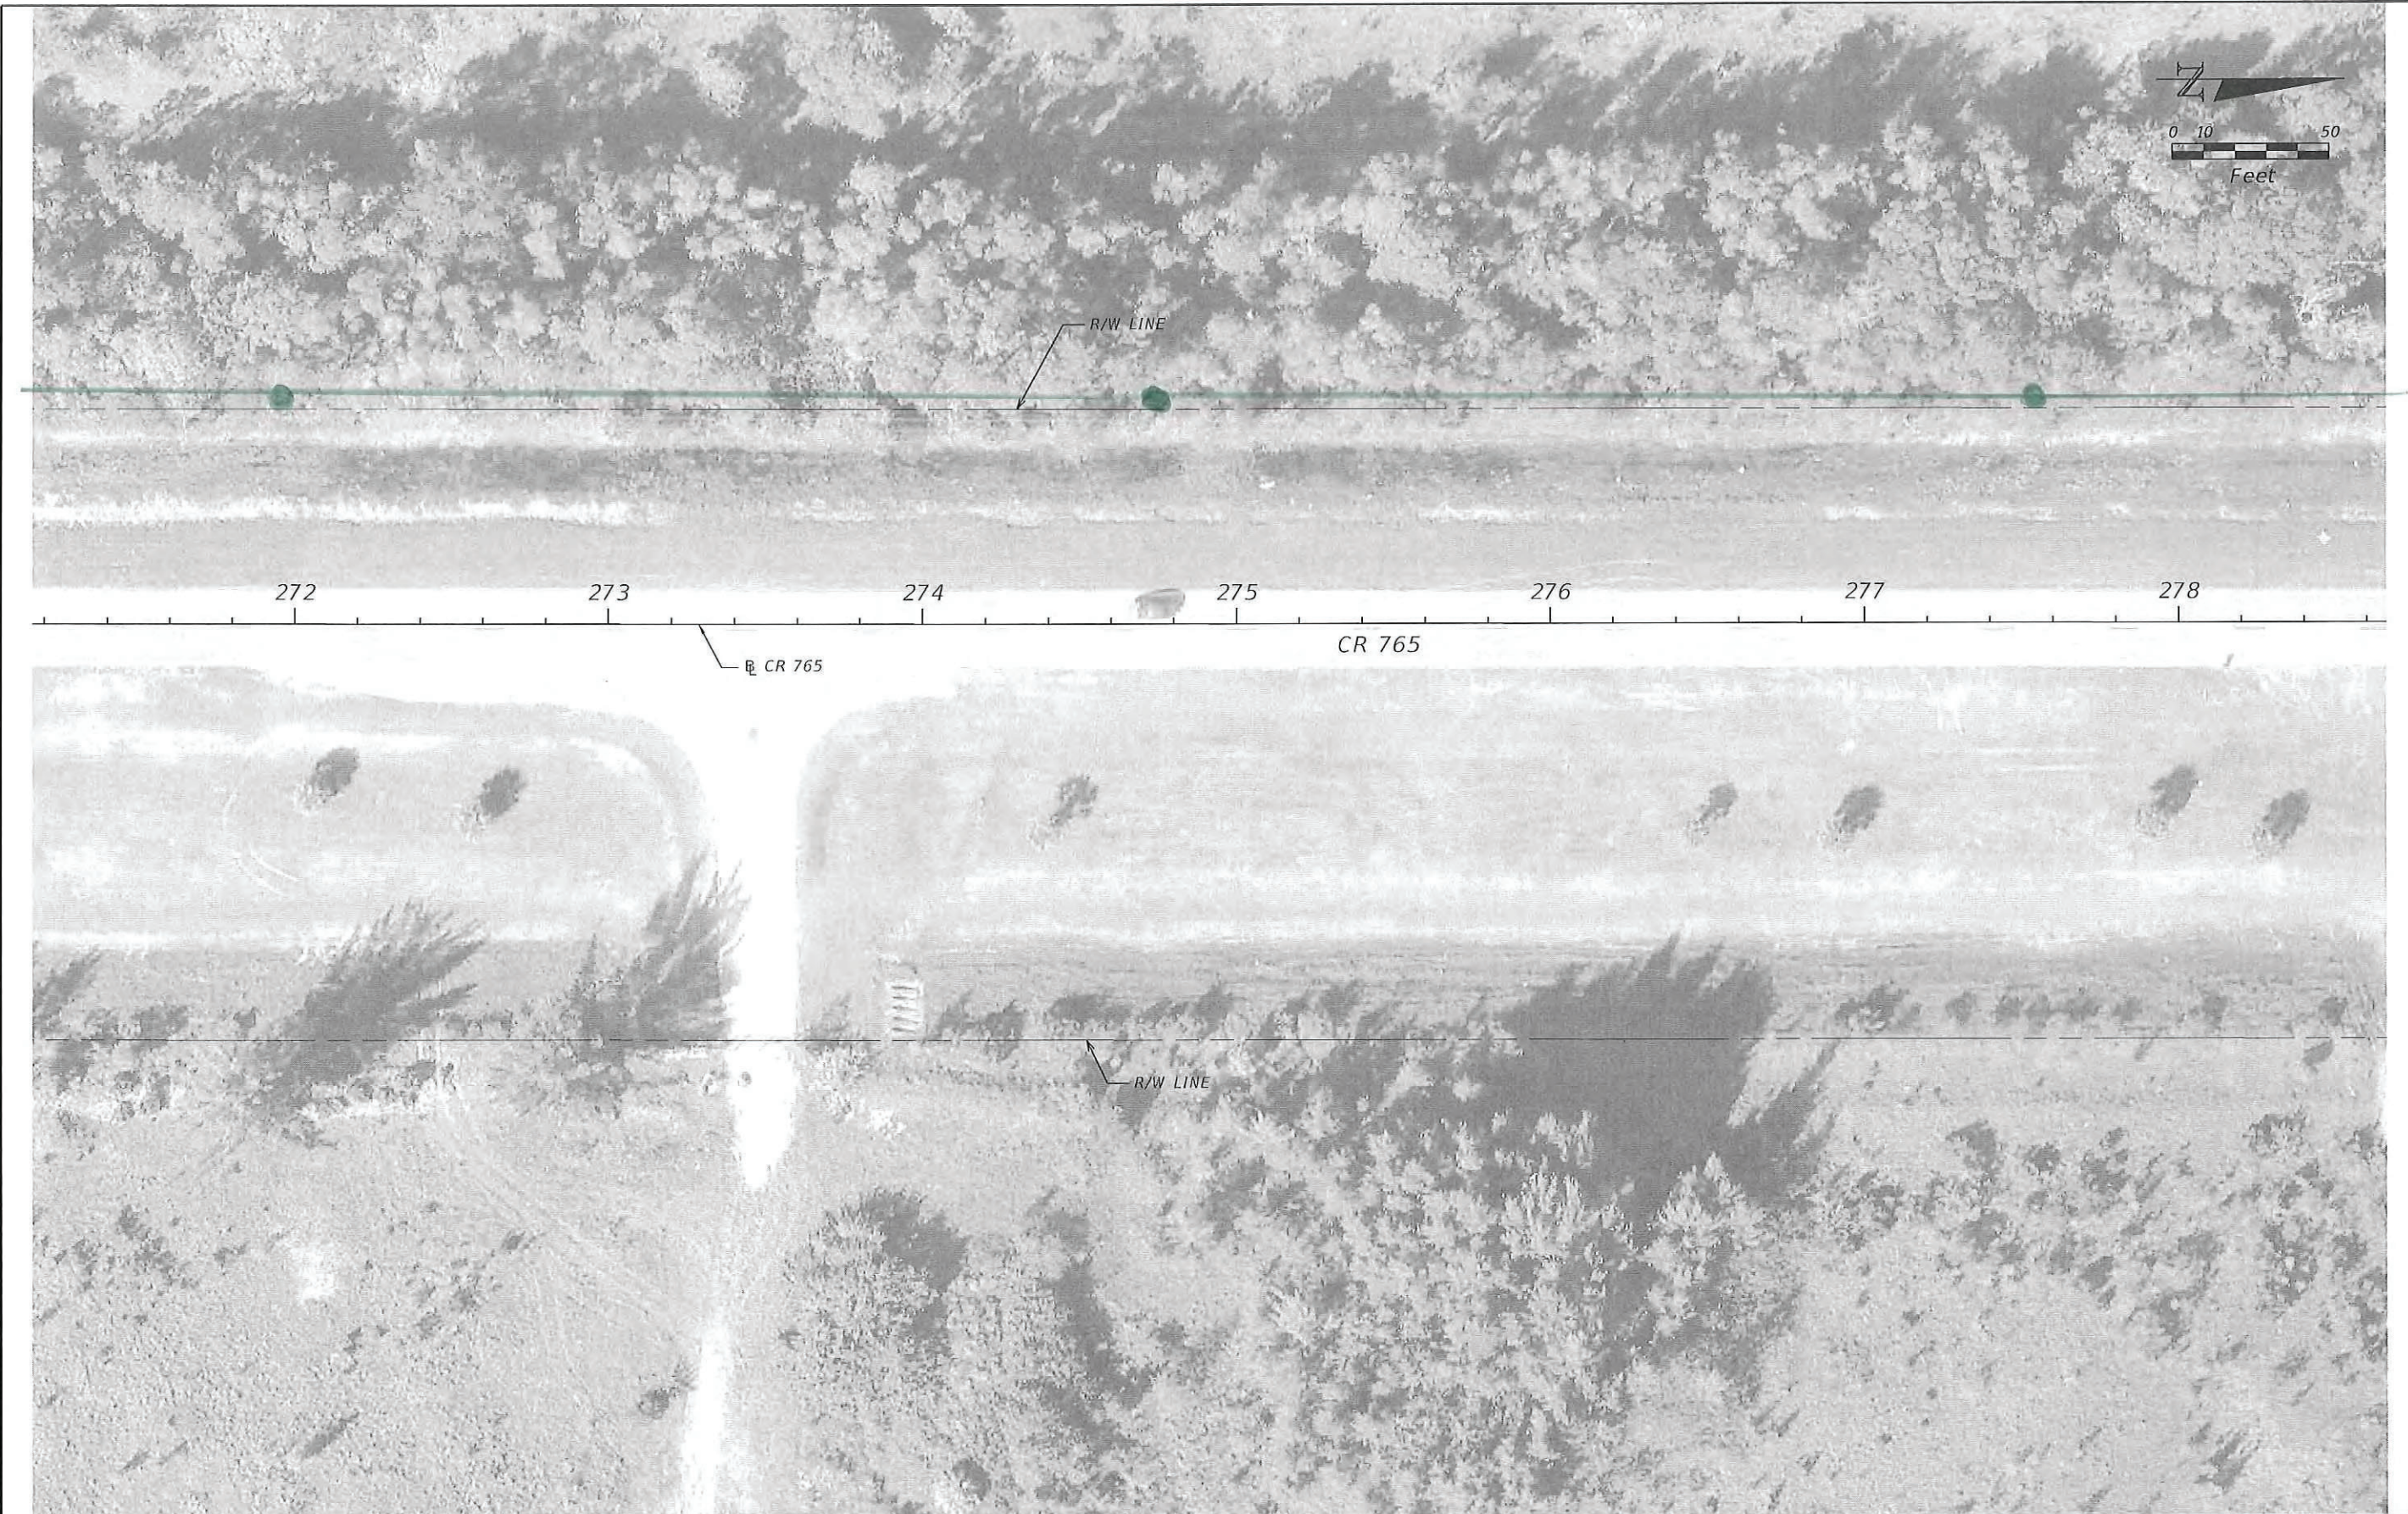

9/10/2020 4:39:18 PM Guest1
 C:\workspaces\FDOT\43692812201\roadway\Plan_9.dgn

THE OFFICIAL RECORD OF THIS SHEET IS THE ELECTRONIC FILE DIGITALLY SIGNED AND SEALED UNDER RULE 61G15-23.004, F.A.C.

REVISIONS				ENGINEER OF RECORD	STATE OF FLORIDA DEPARTMENT OF TRANSPORTATION			ROADWAY PLAN (9)	SHEET NO.
DATE	DESCRIPTION	DATE	DESCRIPTION	JAMES M. WINTER, JR., P.E. LICENSE NUMBER 55514 SCALAR CONSULTING GROUP INC. 13337 N. 56TH STREET TAMPA, FLORIDA 33617	ROAD NO.	COUNTY	FINANCIAL PROJECT ID		10
						CR 765	LEE		




JANIS RD

9/10/2020 4:39:27 PM C:\cstj
 C:\Worksets\FDOT\436928\12201\Roadway\Plan 10.dgn

REVISIONS				ENGINEER OF RECORD		STATE OF FLORIDA DEPARTMENT OF TRANSPORTATION			ROADWAY PLAN (10)	SHEET NO. 11
DATE	DESCRIPTION	DATE	DESCRIPTION	JAMES M. WINTER, JR., P.E. LICENSE NUMBER 55514 SCALAR CONSULTING GROUP INC. 13337 N. 56TH STREET TAMPA, FLORIDA 33617		ROAD NO.	COUNTY	FINANCIAL PROJECT ID		
				CR 765	LEE	436928-1-22-01				

THE OFFICIAL RECORD OF THIS SHEET IS THE ELECTRONIC FILE DIGITALLY SIGNED AND SEALED UNDER RULE 61G15-23.004, F.A.C.

9/10/2020 4:30:36 PM Guest1
 C:\Work\665\FDOT\436928\212201\roadway\Plan 11.dgn

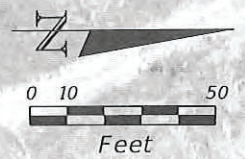

REVISIONS				ENGINEER OF RECORD		STATE OF FLORIDA DEPARTMENT OF TRANSPORTATION			ROADWAY PLAN (11)	SHEET NO. 12
DATE	DESCRIPTION	DATE	DESCRIPTION	JAMES M. WINTER, JR., P.E. LICENSE NUMBER 55514 SCALAR CONSULTING GROUP INC. 13337 N. 56TH STREET TAMPA, FLORIDA 33617		ROAD NO.	COUNTY	FINANCIAL PROJECT ID		
				CR 765	LEE	436928-1-22-01				

THE OFFICIAL RECORD OF THIS SHEET IS THE ELECTRONIC FILE DIGITALLY SIGNED AND SEALED UNDER RULE 61G15-23.004, F.A.C.



9/10/2020 4:35:45 PM Guest1
 C:\worksets\FDOT\43692812201\Roadway\Plan 12.dgn



THE OFFICIAL RECORD OF THIS SHEET IS THE ELECTRONIC FILE DIGITALLY SIGNED AND SEALED UNDER RULE 61G15-23.004, F.A.C.

REVISIONS				ENGINEER OF RECORD		STATE OF FLORIDA DEPARTMENT OF TRANSPORTATION			ROADWAY PLAN (12)	SHEET NO. 13
DATE	DESCRIPTION	DATE	DESCRIPTION	JAMES M. WINTER, JR., P.E. LICENSE NUMBER 55514 SCALAR CONSULTING GROUP INC. 13337 N. 56TH STREET TAMPA, FLORIDA 33617		ROAD NO.	COUNTY	FINANCIAL PROJECT ID		
				CR 765	LEE	436928-1-22-01				

DE 4 wire 25KV

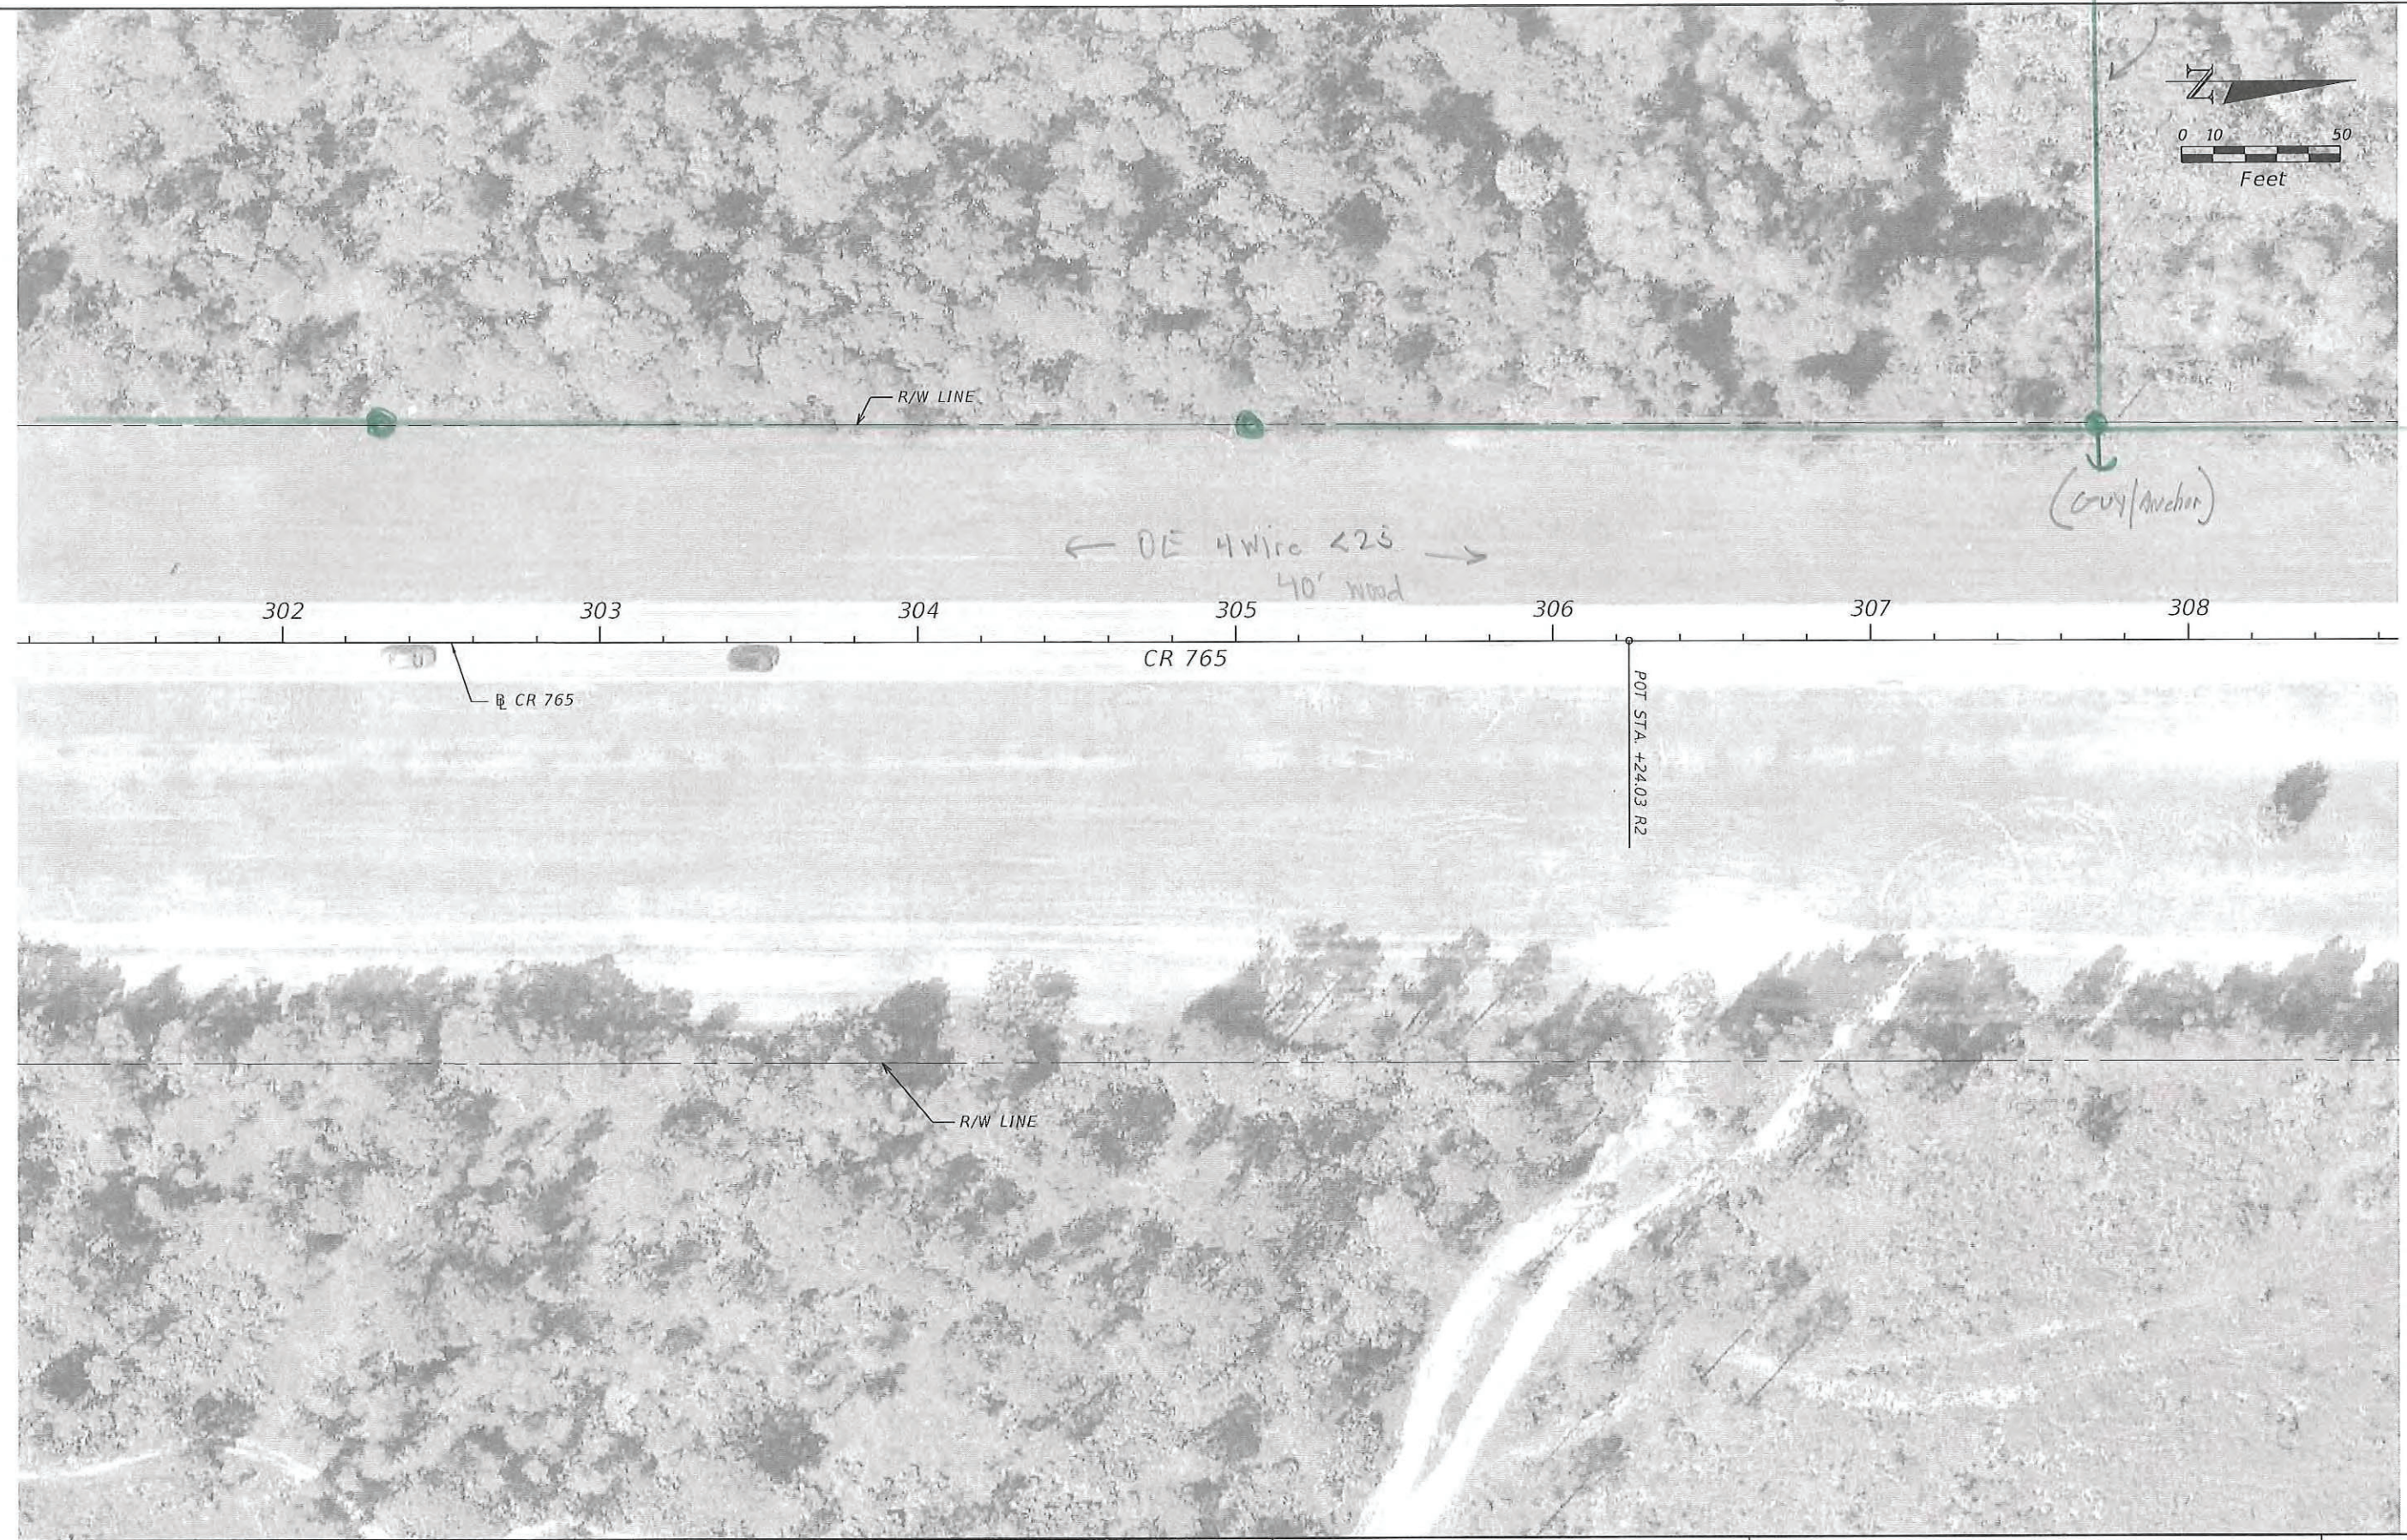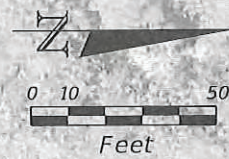


9/10/2020 4:39:55 PM Guest1 C:\Worksets\FDOT\43692812201\roadway\Plan 13.dgn

THE OFFICIAL RECORD OF THIS SHEET IS THE ELECTRONIC FILE DIGITALLY SIGNED AND SEALED UNDER RULE 61G15-23.004, F.A.C.

REVISIONS		ENGINEER OF RECORD		STATE OF FLORIDA DEPARTMENT OF TRANSPORTATION			ROADWAY PLAN (13)	SHEET NO.
DATE	DESCRIPTION	DATE	DESCRIPTION	ROAD NO.	COUNTY	FINANCIAL PROJECT ID		
				CR 765	LEE	436928-1-22-01		14




JAMES M. WINTER, JR., P.E.
 LICENSE NUMBER 55514
 SCALAR CONSULTING GROUP INC.
 13337 N. 56TH STREET
 TAMPA, FLORIDA 33617

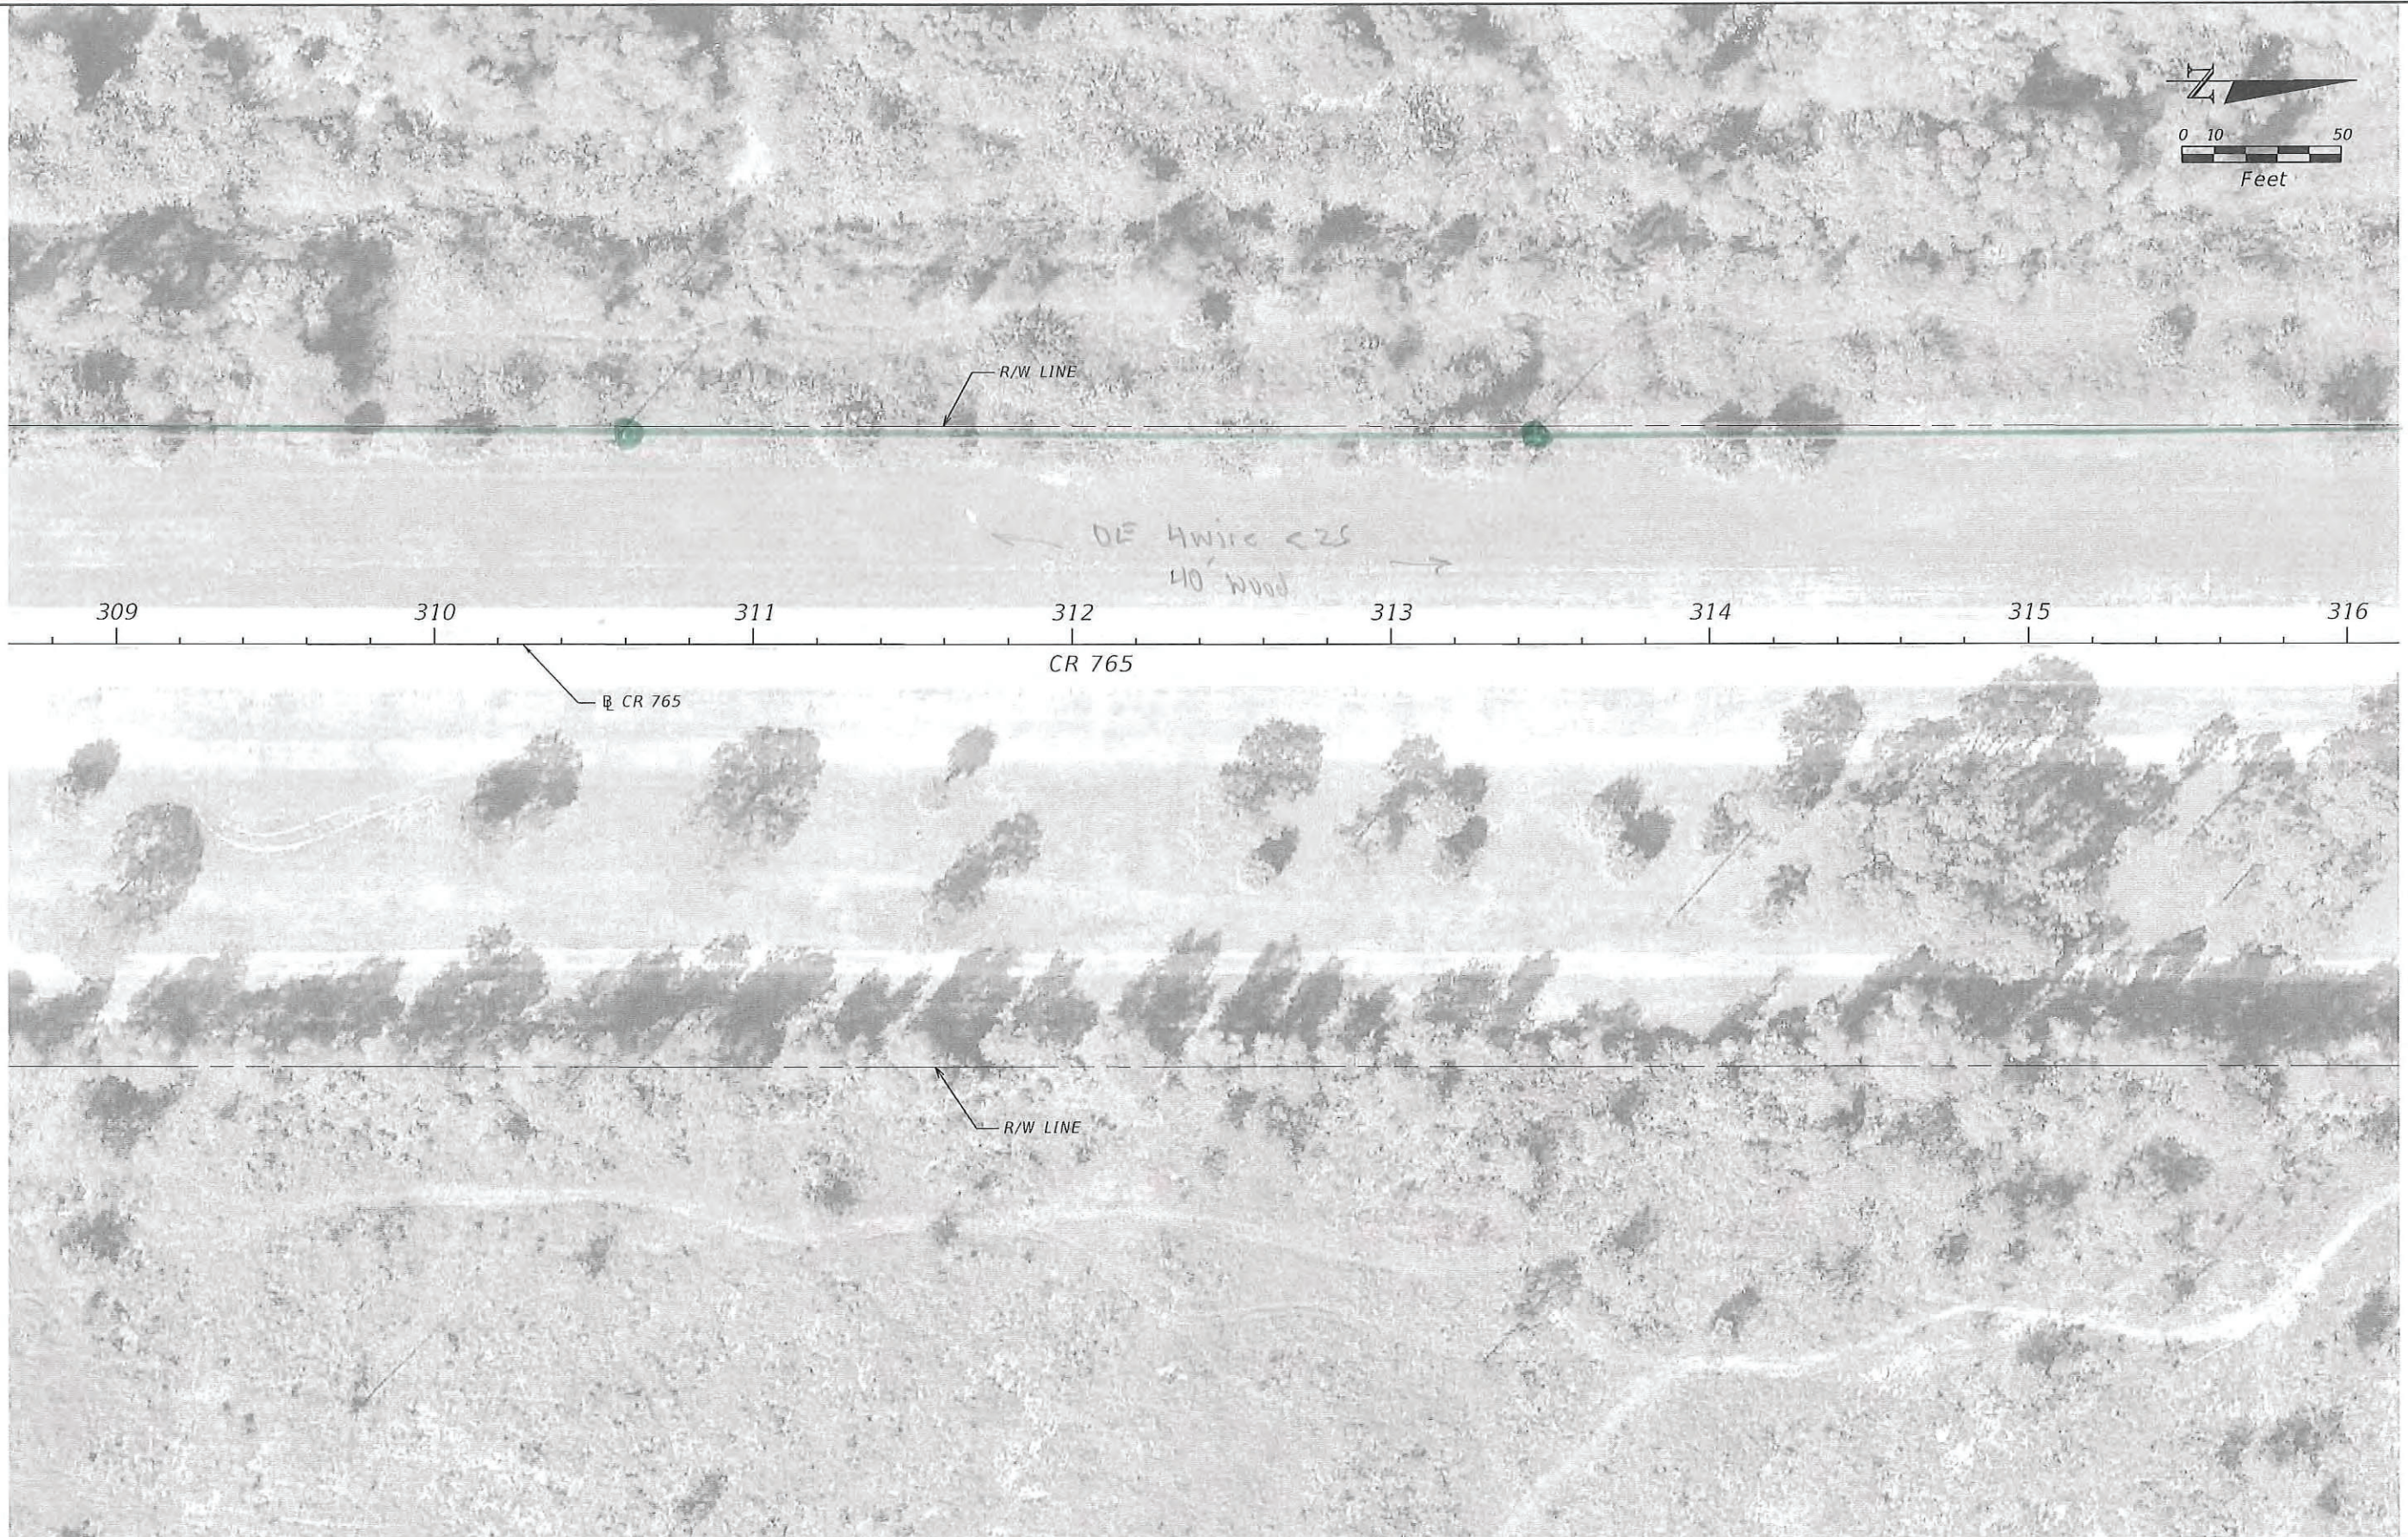

9/10/2020 4:40:05 PM Guest1
 C:\work\scs\FDOT\43692812201\roadway\Plan_14.dgn

THE OFFICIAL RECORD OF THIS SHEET IS THE ELECTRONIC FILE DIGITALLY SIGNED AND SEALED UNDER RULE 61G15-23.004, F.A.C.




REVISIONS				ENGINEER OF RECORD	STATE OF FLORIDA DEPARTMENT OF TRANSPORTATION			ROADWAY PLAN (14)	SHEET NO.
DATE	DESCRIPTION	DATE	DESCRIPTION		ROAD NO.	COUNTY	FINANCIAL PROJECT ID		
				JAMES M. WINTER, JR., P.E. LICENSE NUMBER 55514 SCALAR CONSULTING GROUP INC. 13337 N. 56TH STREET TAMPA, FLORIDA 33617	CR 765	LEE	436928-1-22-01	15	

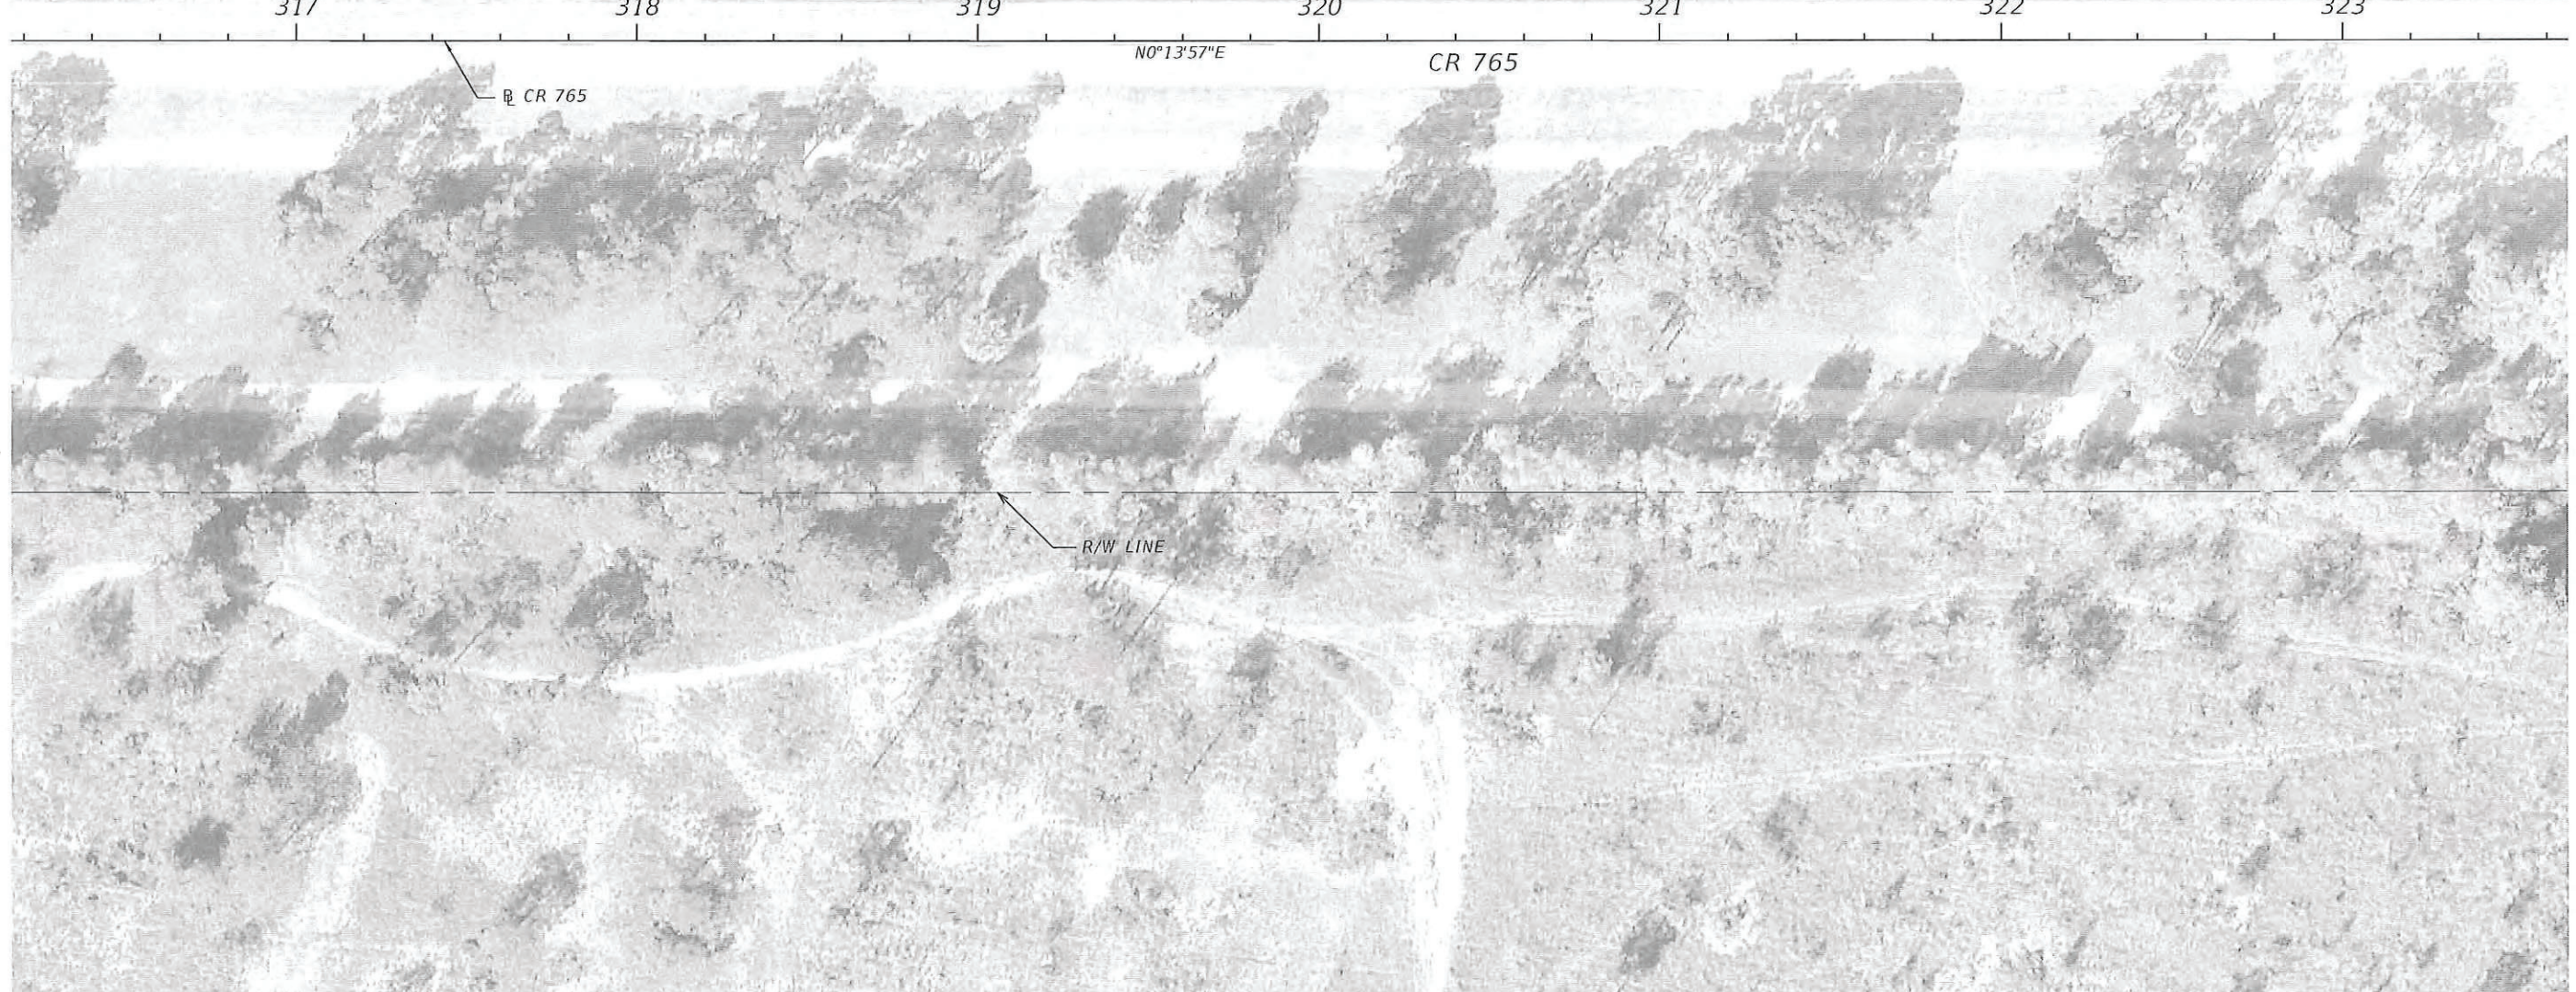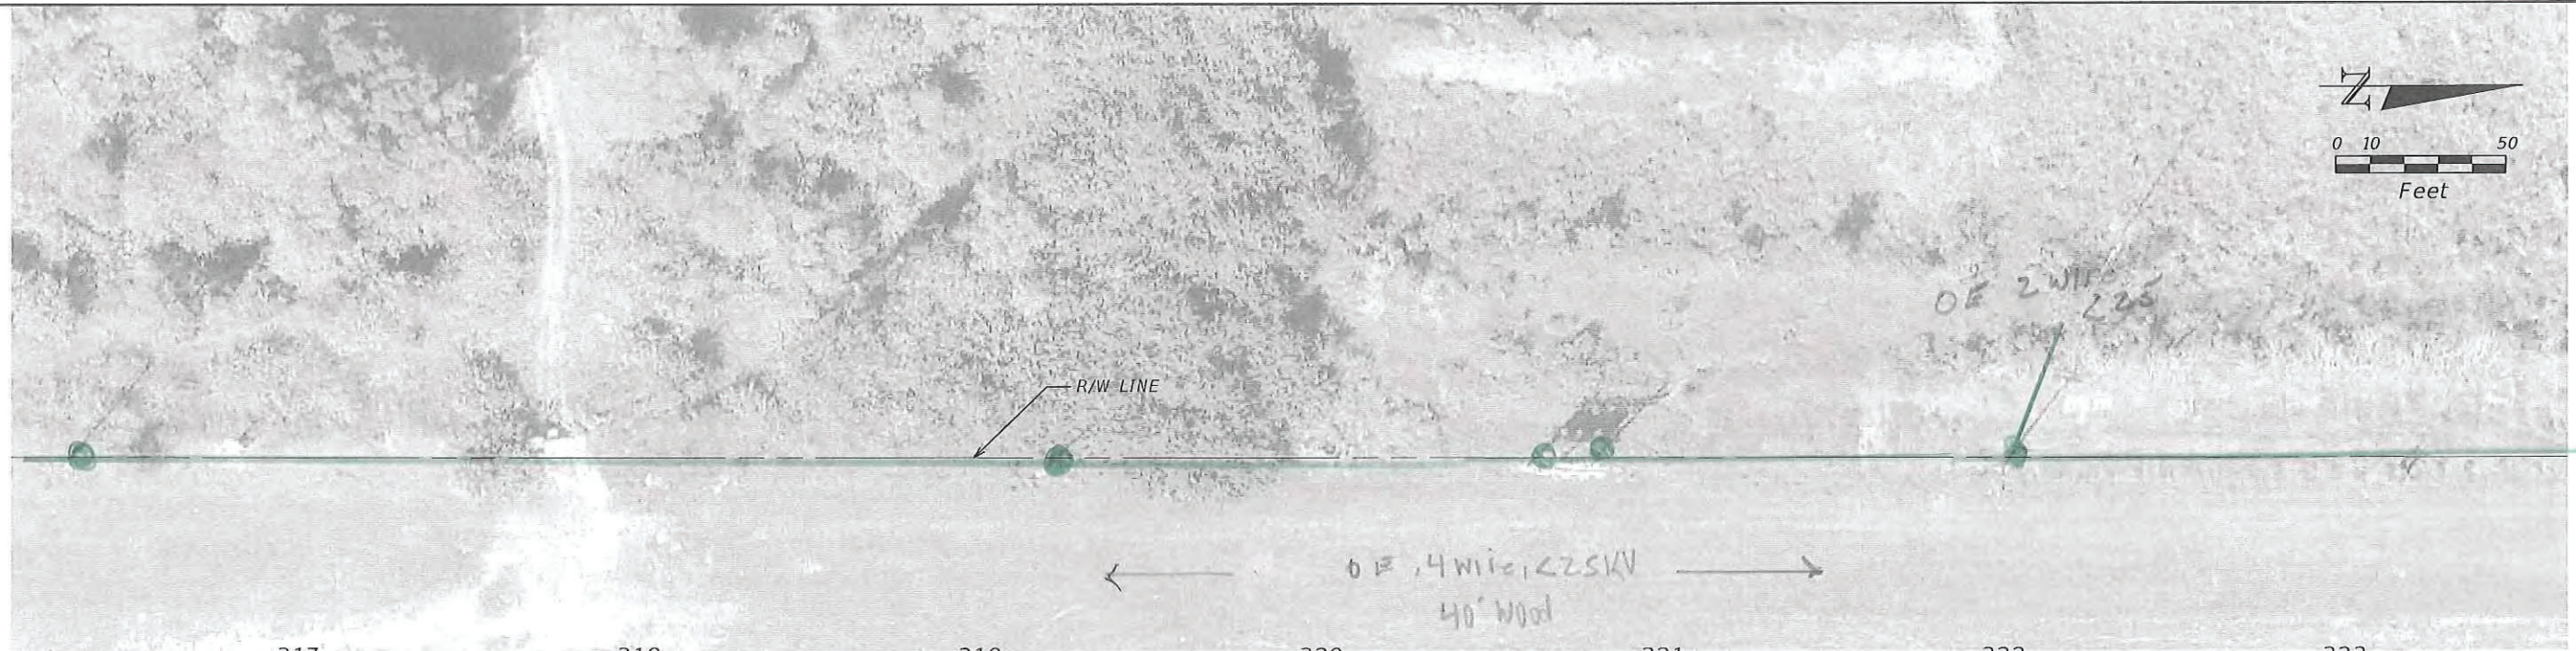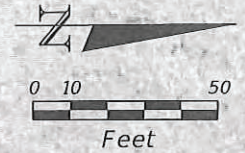

9/10/2020 4:40:16 PM Guest1
 C:\w\p\es\DOT\43692812201\roadway\Plan 15.dgn

THE OFFICIAL RECORD OF THIS SHEET IS THE ELECTRONIC FILE DIGITALLY SIGNED AND SEALED UNDER RULE 61G15-23.004, F.A.C.


REVISIONS				ENGINEER OF RECORD		STATE OF FLORIDA DEPARTMENT OF TRANSPORTATION			ROADWAY PLAN (15)	SHEET NO. 16
DATE	DESCRIPTION	DATE	DESCRIPTION							
				JAMES M. WINTER, JR., P.E. LICENSE NUMBER 55514 SCALAR CONSULTING GROUP INC. 13337 N. 56TH STREET TAMPA, FLORIDA 33617		ROAD NO.	COUNTY	FINANCIAL PROJECT ID		
						CR 765	LEE	436928-1-22-01		

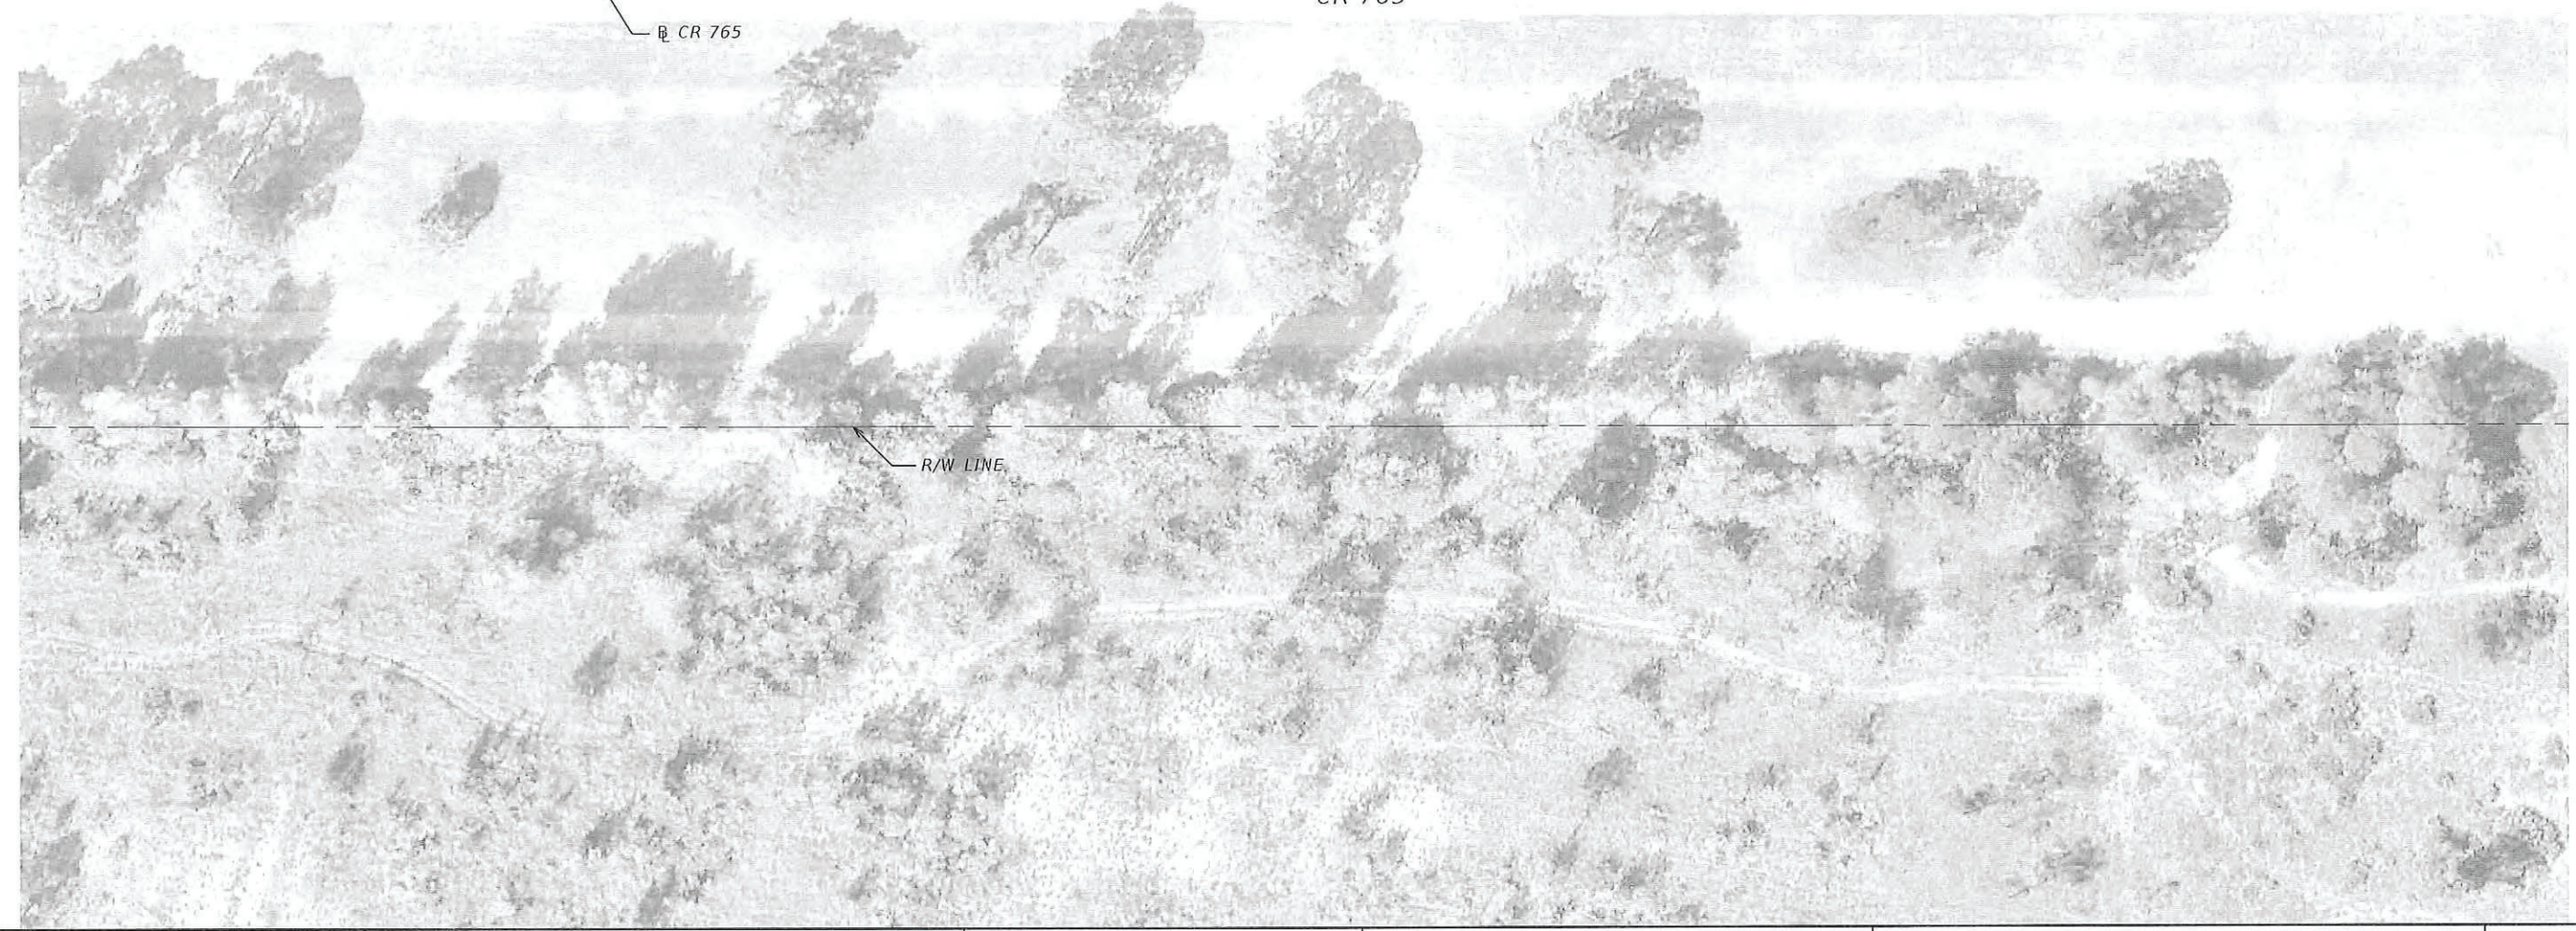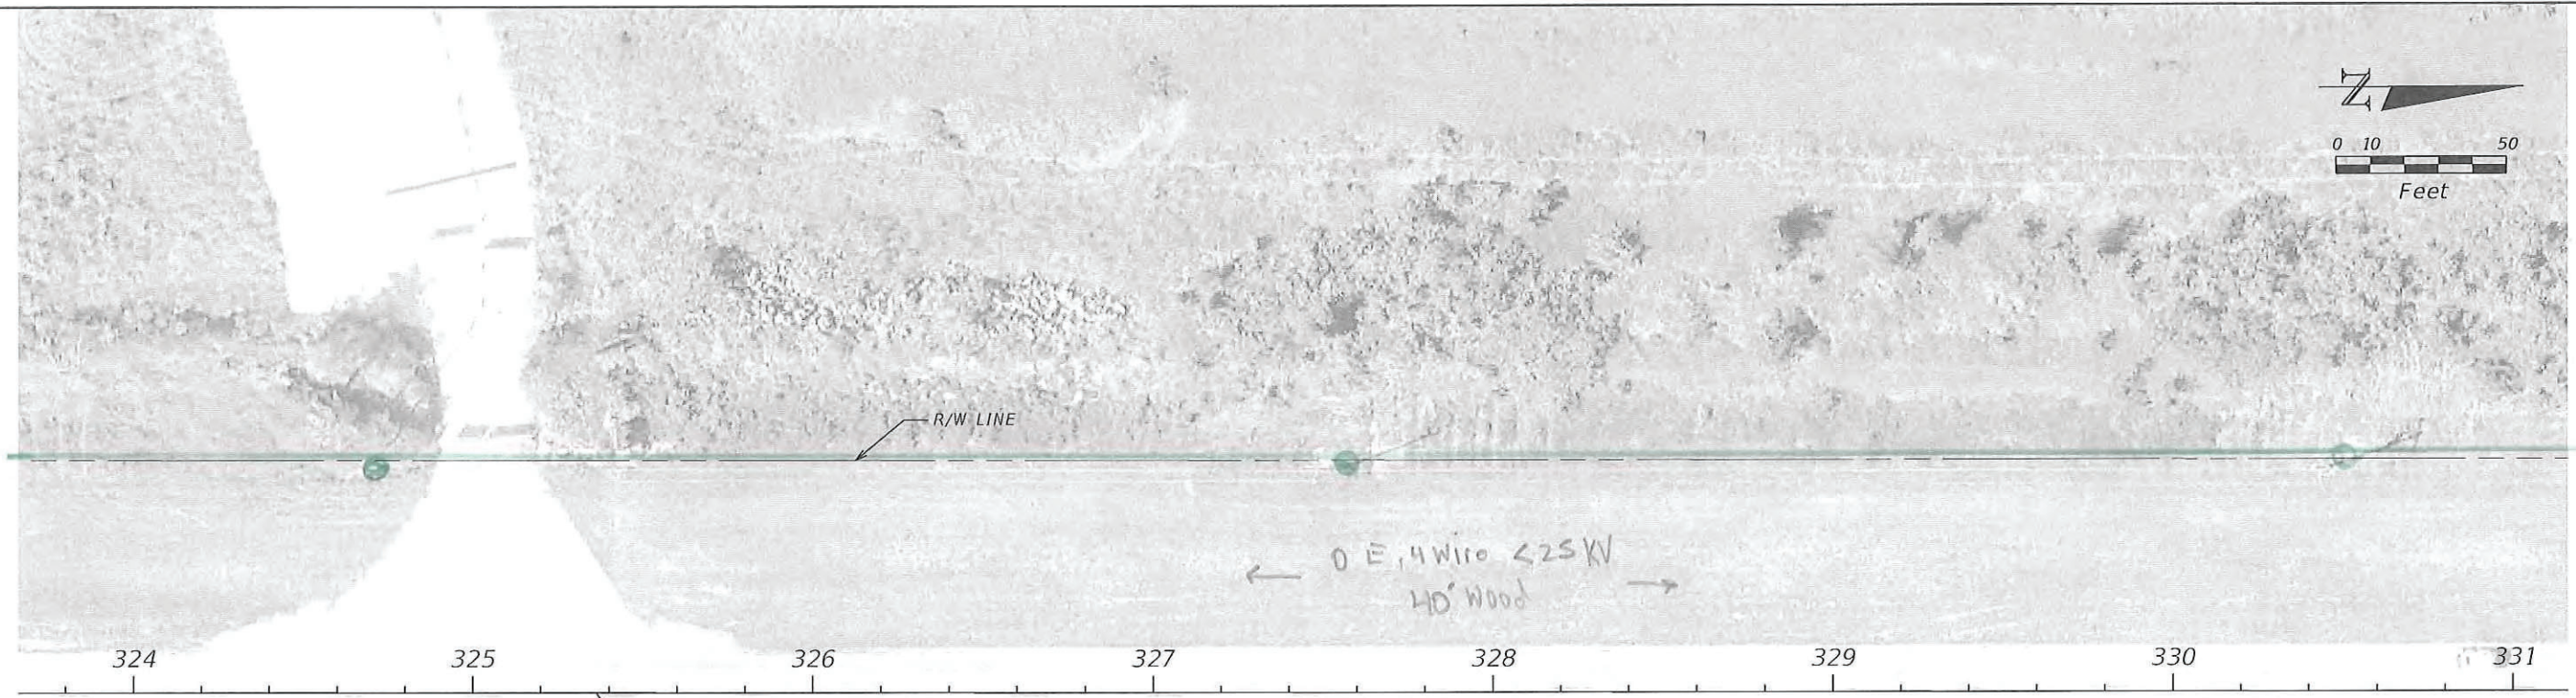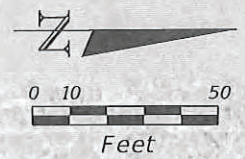

9/10/2020 4:40:26 PM Guest C:\Worksets\FDOT\436928\1220\Roadway\Plan 16.dgn

THE OFFICIAL RECORD OF THIS SHEET IS THE ELECTRONIC FILE DIGITALLY SIGNED AND SEALED UNDER RULE 61G15-23.004, F.A.C.



REVISIONS				ENGINEER OF RECORD	STATE OF FLORIDA DEPARTMENT OF TRANSPORTATION			ROADWAY PLAN (16)	SHEET NO.
DATE	DESCRIPTION	DATE	DESCRIPTION		ROAD NO.	COUNTY	FINANCIAL PROJECT ID		
				JAMES M. WINTER, JR., P.E. LICENSE NUMBER 55514 SCALAR CONSULTING GROUP INC. 13337 N. 56TH STREET TAMPA, FLORIDA 33617	CR 765	LEE	436928-1-22-01		17

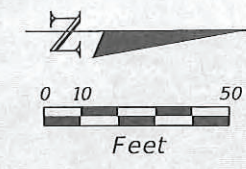

9/10/2020 4:40:36 PM Guest1
 C:\Worksets\FDOT\43692812201\Roadway\Plan_17.dgn

THE OFFICIAL RECORD OF THIS SHEET IS THE ELECTRONIC FILE DIGITALLY SIGNED AND SEALED UNDER RULE 61G15-23.004, F.A.C.


REVISIONS				ENGINEER OF RECORD		STATE OF FLORIDA DEPARTMENT OF TRANSPORTATION			ROADWAY PLAN (17)	SHEET NO.
DATE	DESCRIPTION	DATE	DESCRIPTION	JAMES M. WINTER, JR., P.E. LICENSE NUMBER 55514 SCALAR CONSULTING GROUP INC. 13337 N. 56TH STREET TAMPA, FLORIDA 33617		ROAD NO.	COUNTY	FINANCIAL PROJECT ID		
						CR 765	LEE	436928-1-22-01		18

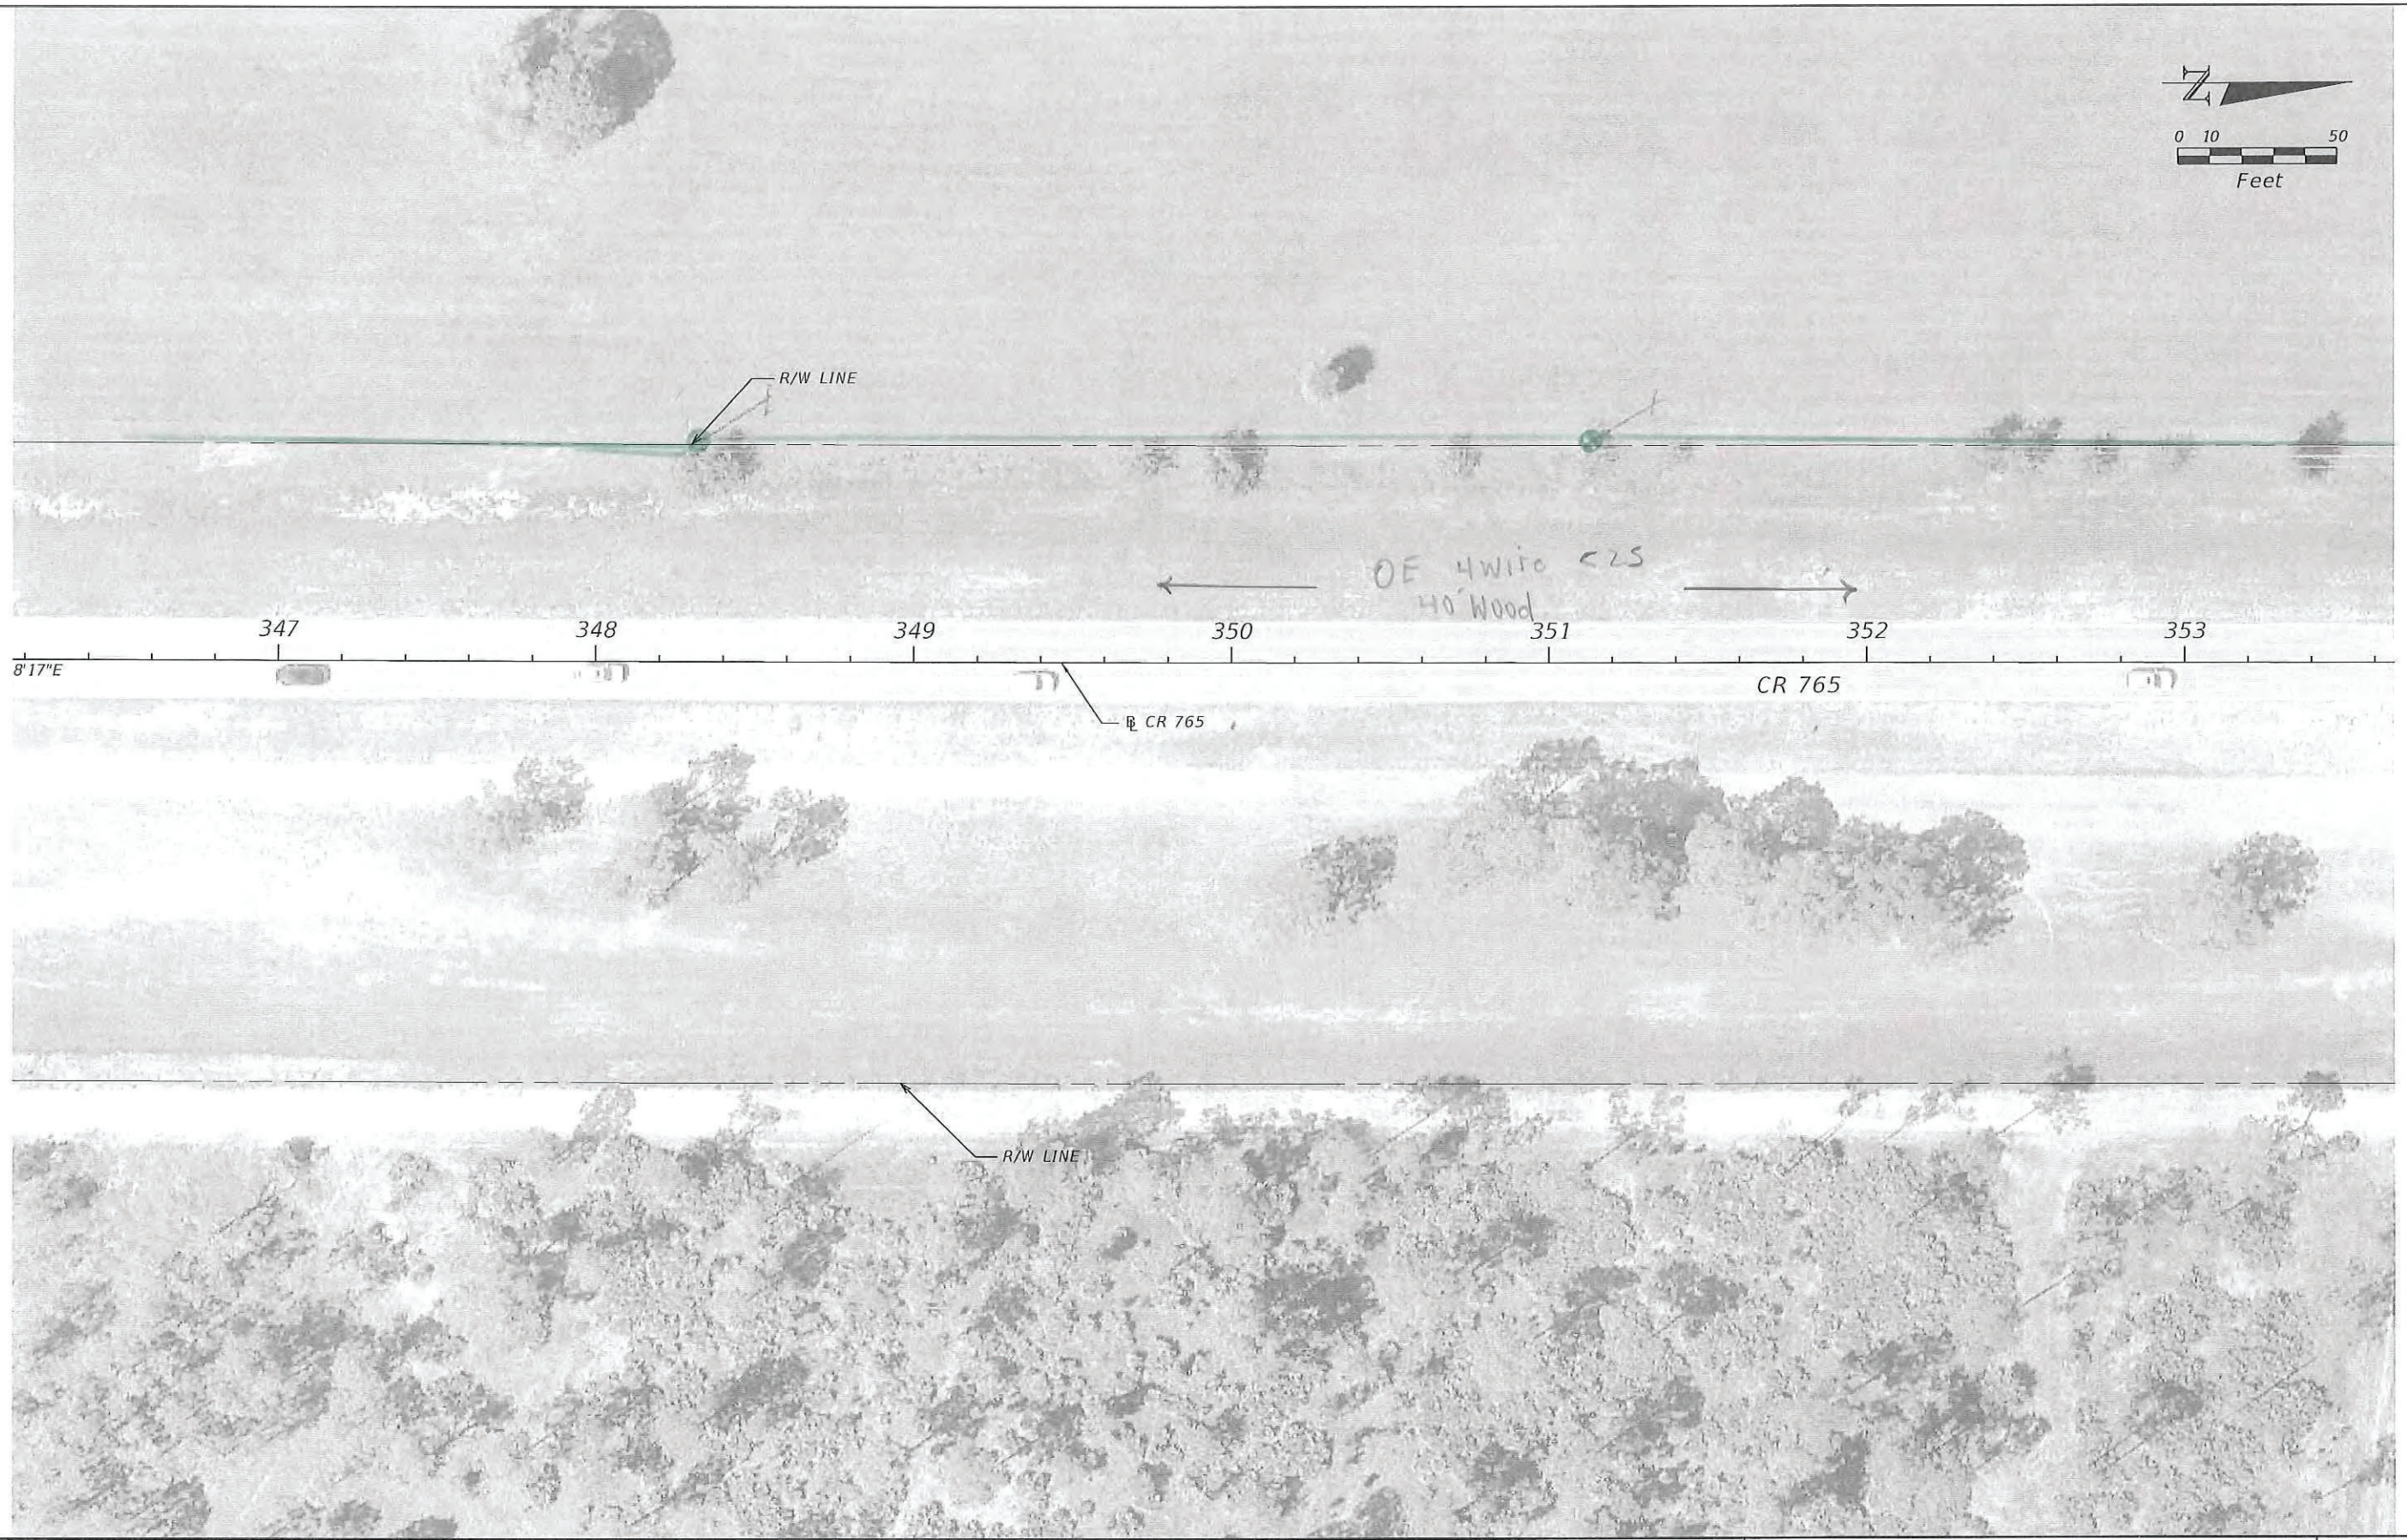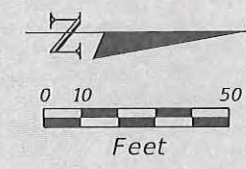

9/10/2020 4:40:57 PM Guest1
 C:\work\sets\FDOT\43692812201\roadway\Plan 19.dgn

THE OFFICIAL RECORD OF THIS SHEET IS THE ELECTRONIC FILE DIGITALLY SIGNED AND SEALED UNDER RULE 61G15-23.004, F.A.C.

REVISIONS				ENGINEER OF RECORD	STATE OF FLORIDA DEPARTMENT OF TRANSPORTATION			ROADWAY PLAN (19)	SHEET NO.
DATE	DESCRIPTION	DATE	DESCRIPTION		ROAD NO.	COUNTY	FINANCIAL PROJECT ID		
				JAMES M. WINTER, JR., P.E. LICENSE NUMBER 55514 SCALAR CONSULTING GROUP INC. 13337 N. 56TH STREET TAMPA, FLORIDA 33617	CR 765	LEE	436928-1-22-01	20	

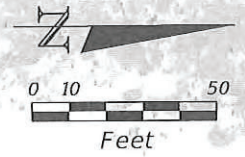

CAPE CORAL FIRE
DEPARTMENT STATION 7

NW 40TH LN

R/W LINE

B.E.
25KV

← OE 4wire 25KV
410' WIND →

354

355

356

357

358

359

360

361

CR 765

CR 765

POT STA. 4+26.0 R2



YUCCA PENS PRESERVE

R/W LINE

9/10/2020 4:41:06 PM Guest1
C:\worksheets\DOT\43692812201\Roadway\Plan 20.dgn

THE OFFICIAL RECORD OF THIS SHEET IS THE ELECTRONIC FILE DIGITALLY SIGNED AND SEALED UNDER RULE 61G15-23.004, F.A.C.



REVISIONS				ENGINEER OF RECORD	STATE OF FLORIDA DEPARTMENT OF TRANSPORTATION			ROADWAY PLAN (20)	SHEET NO.
DATE	DESCRIPTION	DATE	DESCRIPTION		ROAD NO.	COUNTY	FINANCIAL PROJECT ID		
				JAMES M. WINTER, JR., P.E. LICENSE NUMBER 55514 SCALAR CONSULTING GROUP INC. 13337 N. 56TH STREET TAMPA, FLORIDA 33617	CR 765	LEE	436928-1-22-01	21	

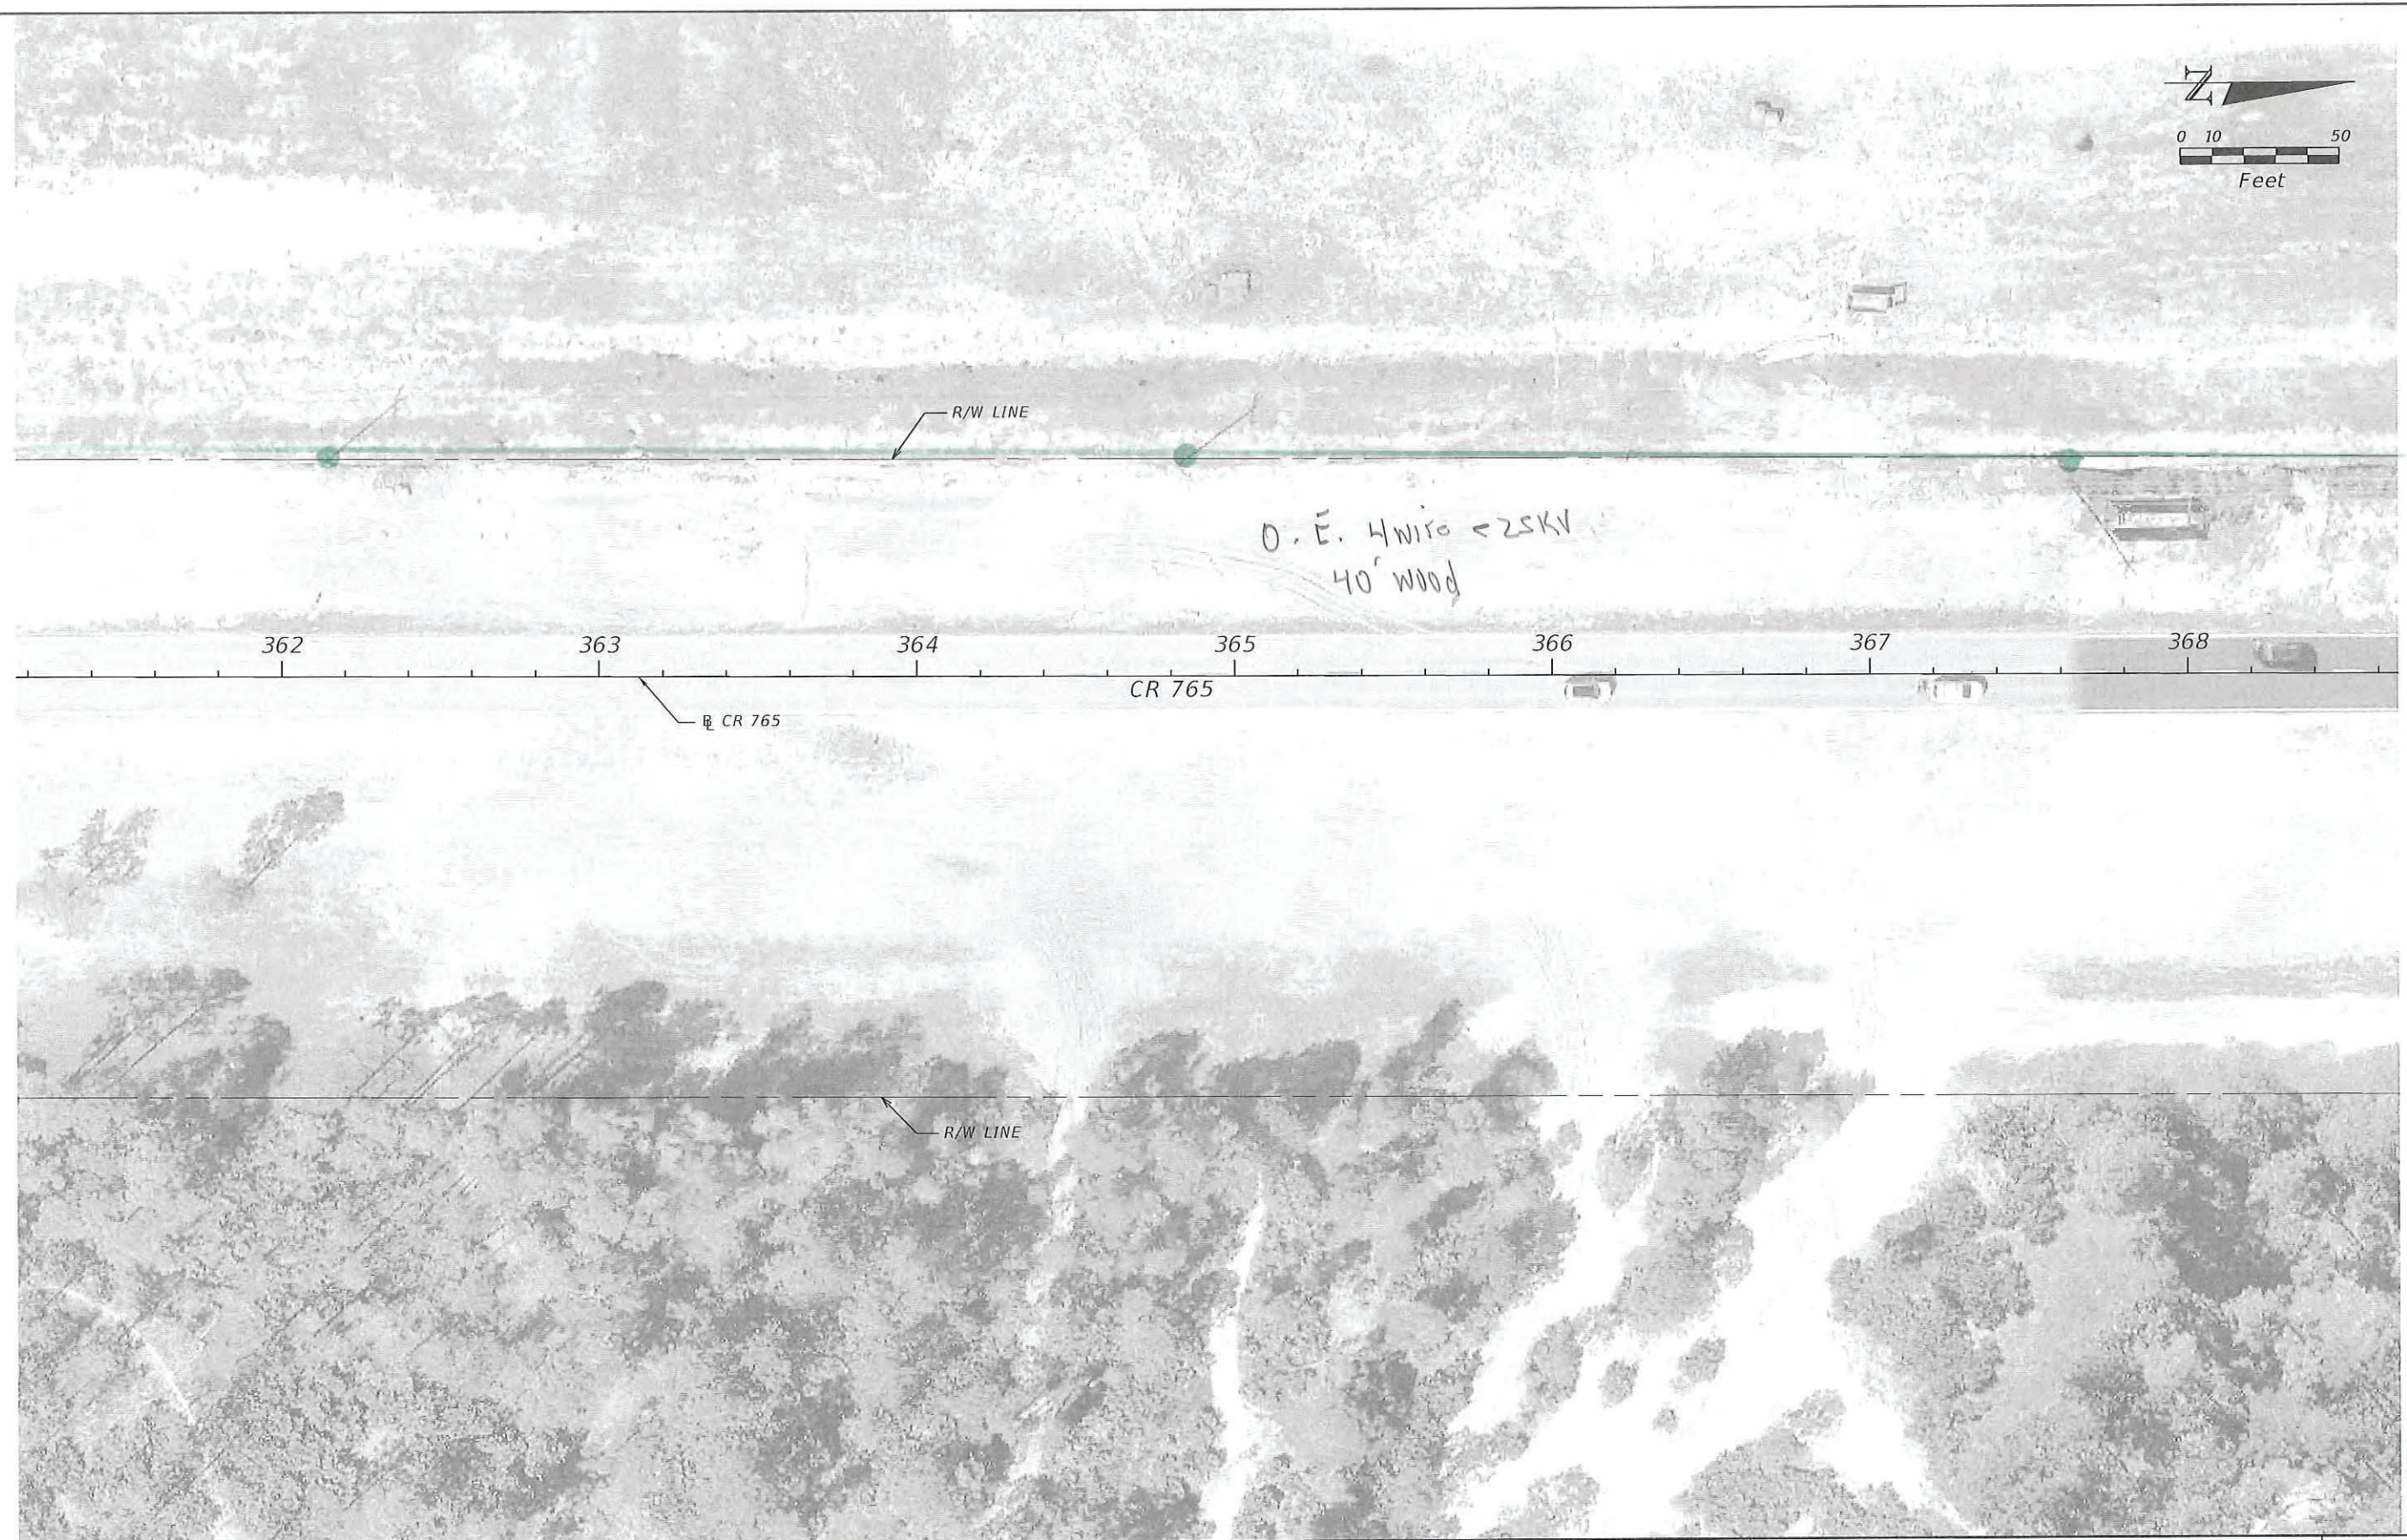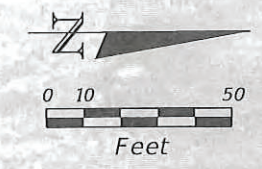

9/10/2020 4:41:14 PM Guest
 C:\worksets\VDOT\36692812201\Roadway\Plan 21.dgn

THE OFFICIAL RECORD OF THIS SHEET IS THE ELECTRONIC FILE DIGITALLY SIGNED AND SEALED UNDER RULE 61G15-23.004, F.A.C.


REVISIONS				ENGINEER OF RECORD	STATE OF FLORIDA DEPARTMENT OF TRANSPORTATION			ROADWAY PLAN (21)	SHEET NO.
DATE	DESCRIPTION	DATE	DESCRIPTION		ROAD NO.	COUNTY	FINANCIAL PROJECT ID		
				JAMES M. WINTER, JR., P.E. LICENSE NUMBER 55514 SCALAR CONSULTING GROUP INC. 13337 N. 56TH STREET TAMPA, FLORIDA 33617	CR 765	LEE	436928-1-22-01	22	

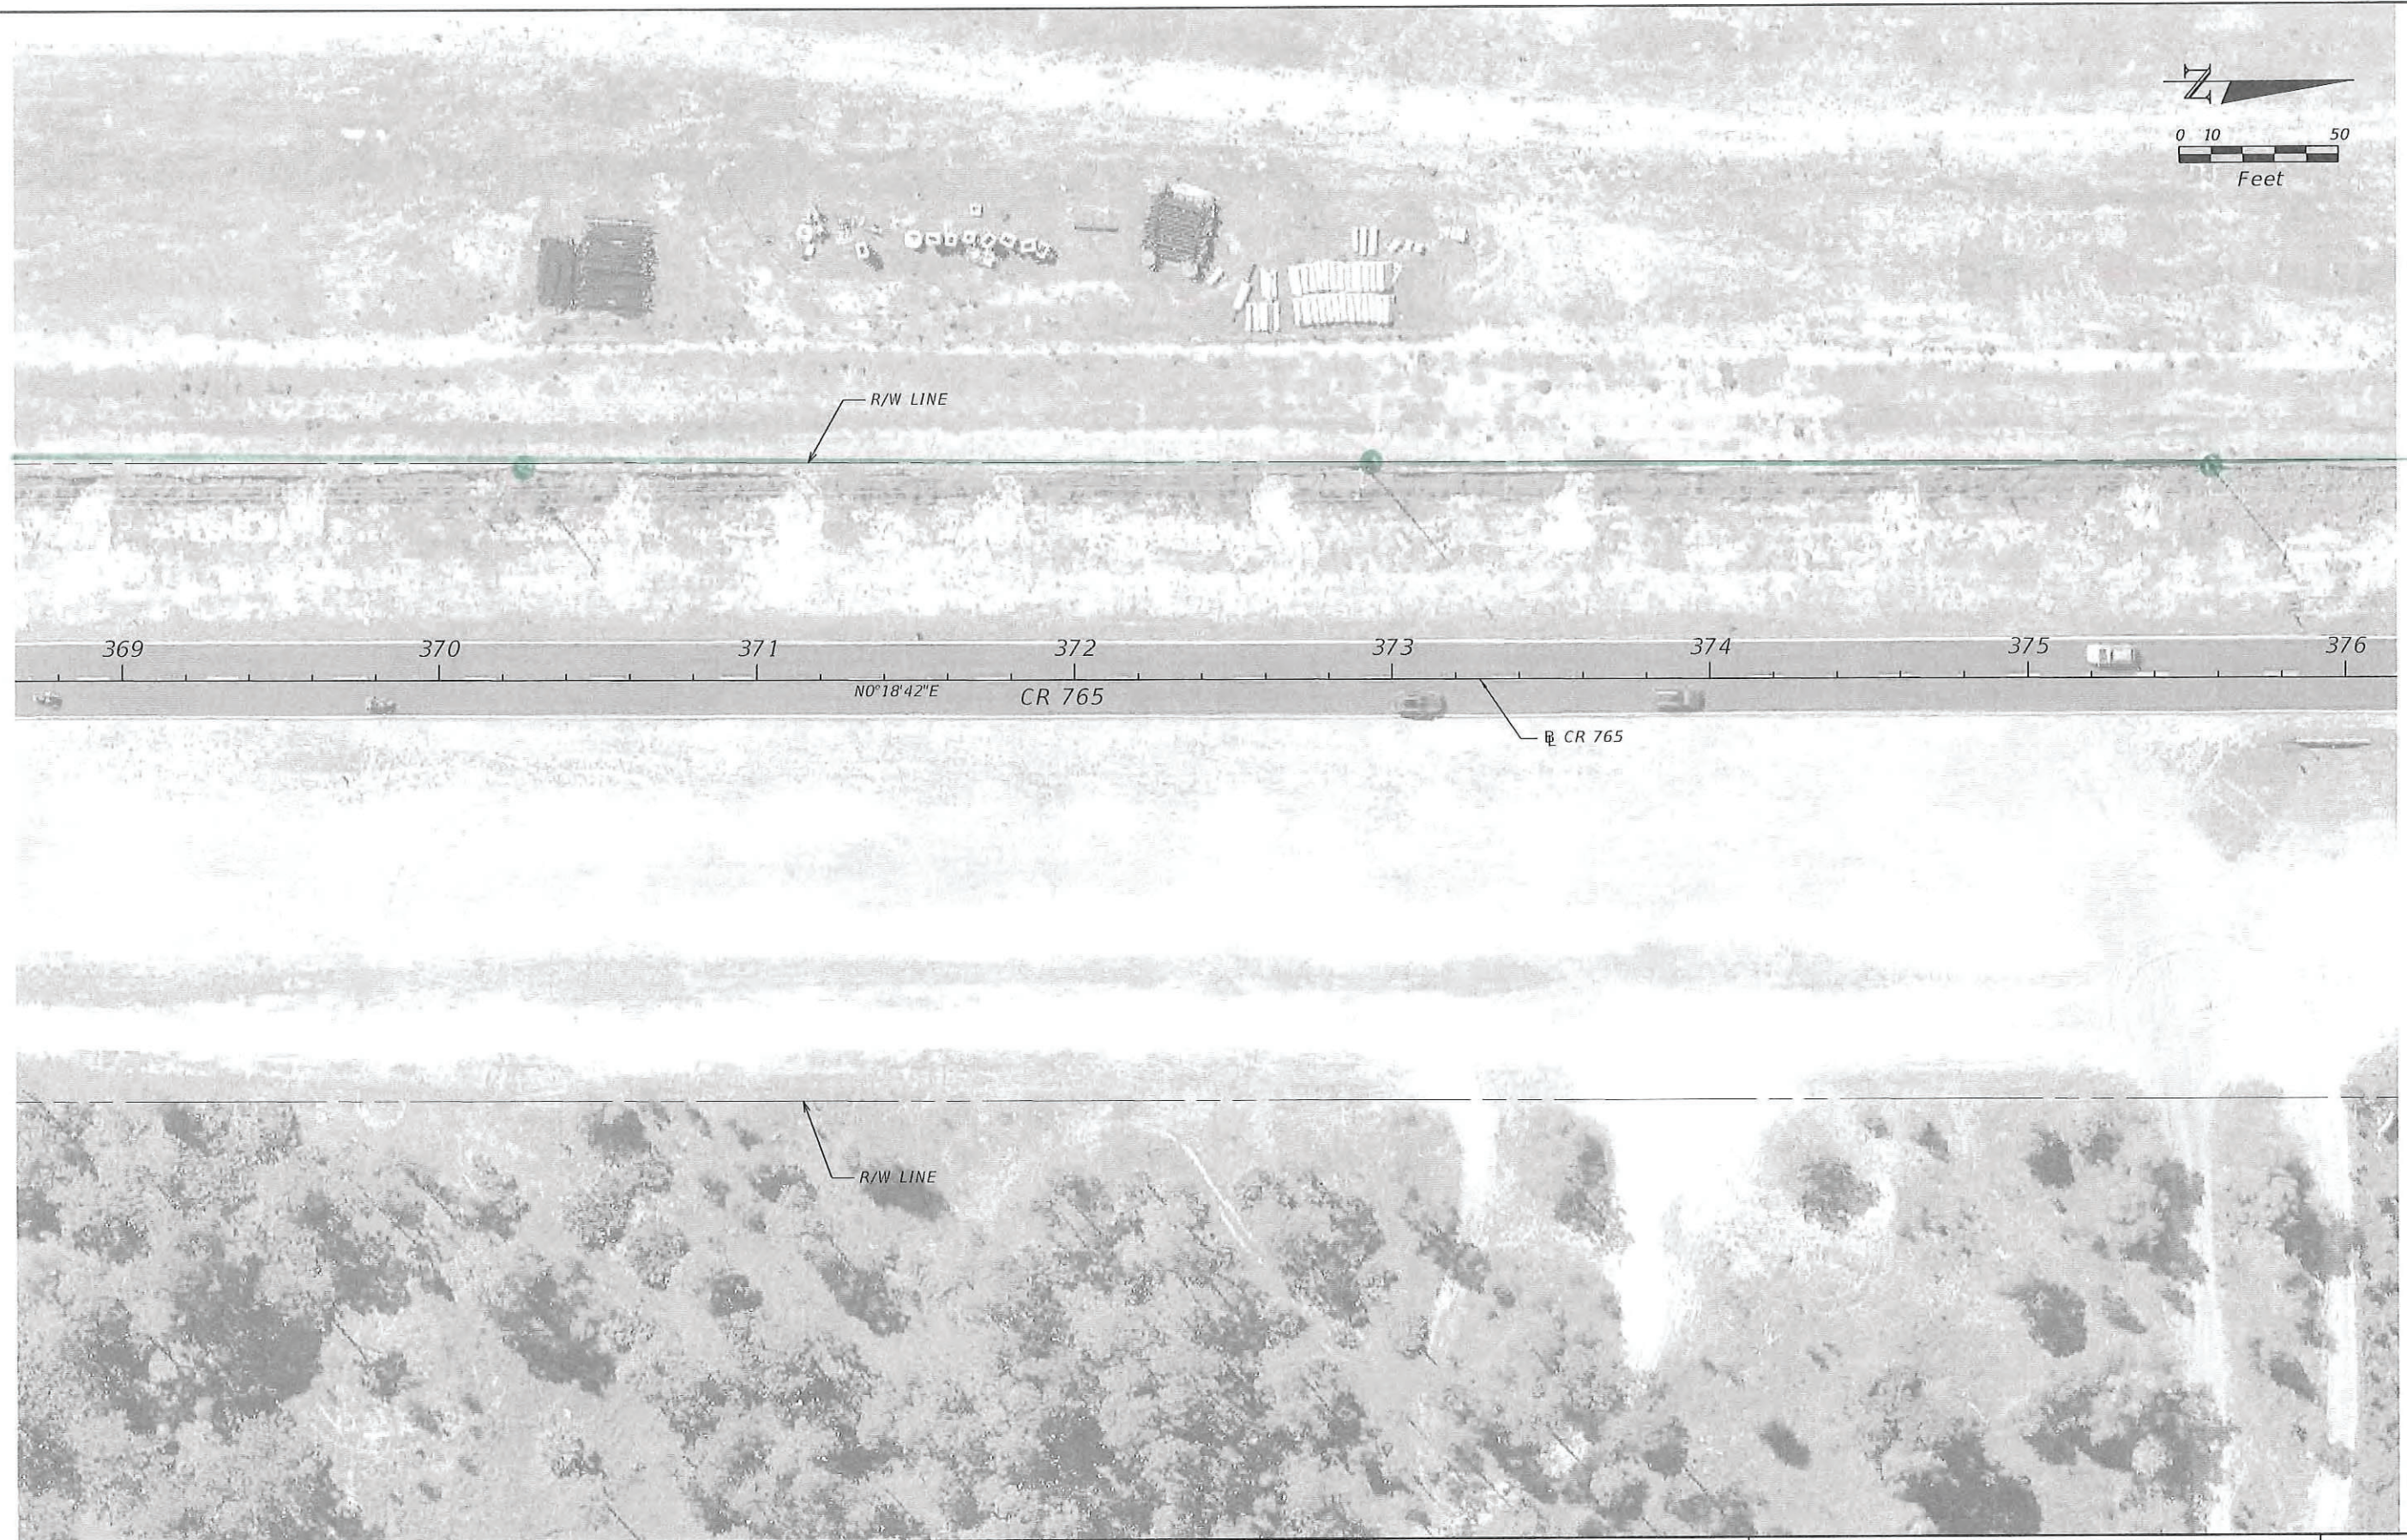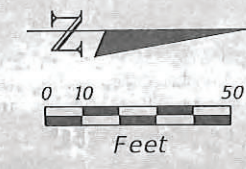

9/10/2020 4:47:24 PM Guest1
 C:\Worksets\FDOT\436928\2201\Roadway\Plan 22.dgn

THE OFFICIAL RECORD OF THIS SHEET IS THE ELECTRONIC FILE DIGITALLY SIGNED AND SEALED UNDER RULE 61G15-23.004, F.A.C.

REVISIONS				ENGINEER OF RECORD	STATE OF FLORIDA DEPARTMENT OF TRANSPORTATION			ROADWAY PLAN (22)	SHEET NO.
DATE	DESCRIPTION	DATE	DESCRIPTION		ROAD NO.	COUNTY	FINANCIAL PROJECT ID		
				JAMES M. WINTER, JR., P.E. LICENSE NUMBER 55514 SCALAR CONSULTING GROUP INC. 13337 N. 56TH STREET TAMPA, FLORIDA 33617	CR 765	LEE	436928-1-22-01	23	


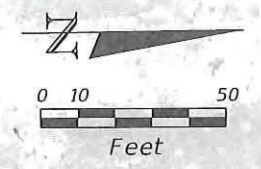


9/10/2020 4:41:33 PM Guest
 C:\workssets\F007_436928\2201\roadway\Plan 23.dgn

THE OFFICIAL RECORD OF THIS SHEET IS THE ELECTRONIC FILE DIGITALLY SIGNED AND SEALED UNDER RULE 61G15-23.004, F.A.C.

REVISIONS				ENGINEER OF RECORD	STATE OF FLORIDA DEPARTMENT OF TRANSPORTATION			ROADWAY PLAN (23)	SHEET NO.
DATE	DESCRIPTION	DATE	DESCRIPTION		ROAD NO.	COUNTY	FINANCIAL PROJECT ID		
				JAMES M. WINTER, JR., P.E. LICENSE NUMBER 55514 SCALAR CONSULTING GROUP INC. 13337 N. 56TH STREET TAMPA, FLORIDA 33617	CR 765	LEE	436928-1-22-01	24	


9/10/2020 4:47:41 PM Guest
 C:\Worksets\FDOT\336928\1220\Roadway\Plan 24.dgn

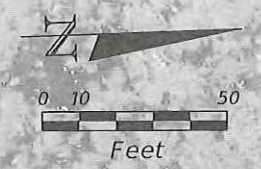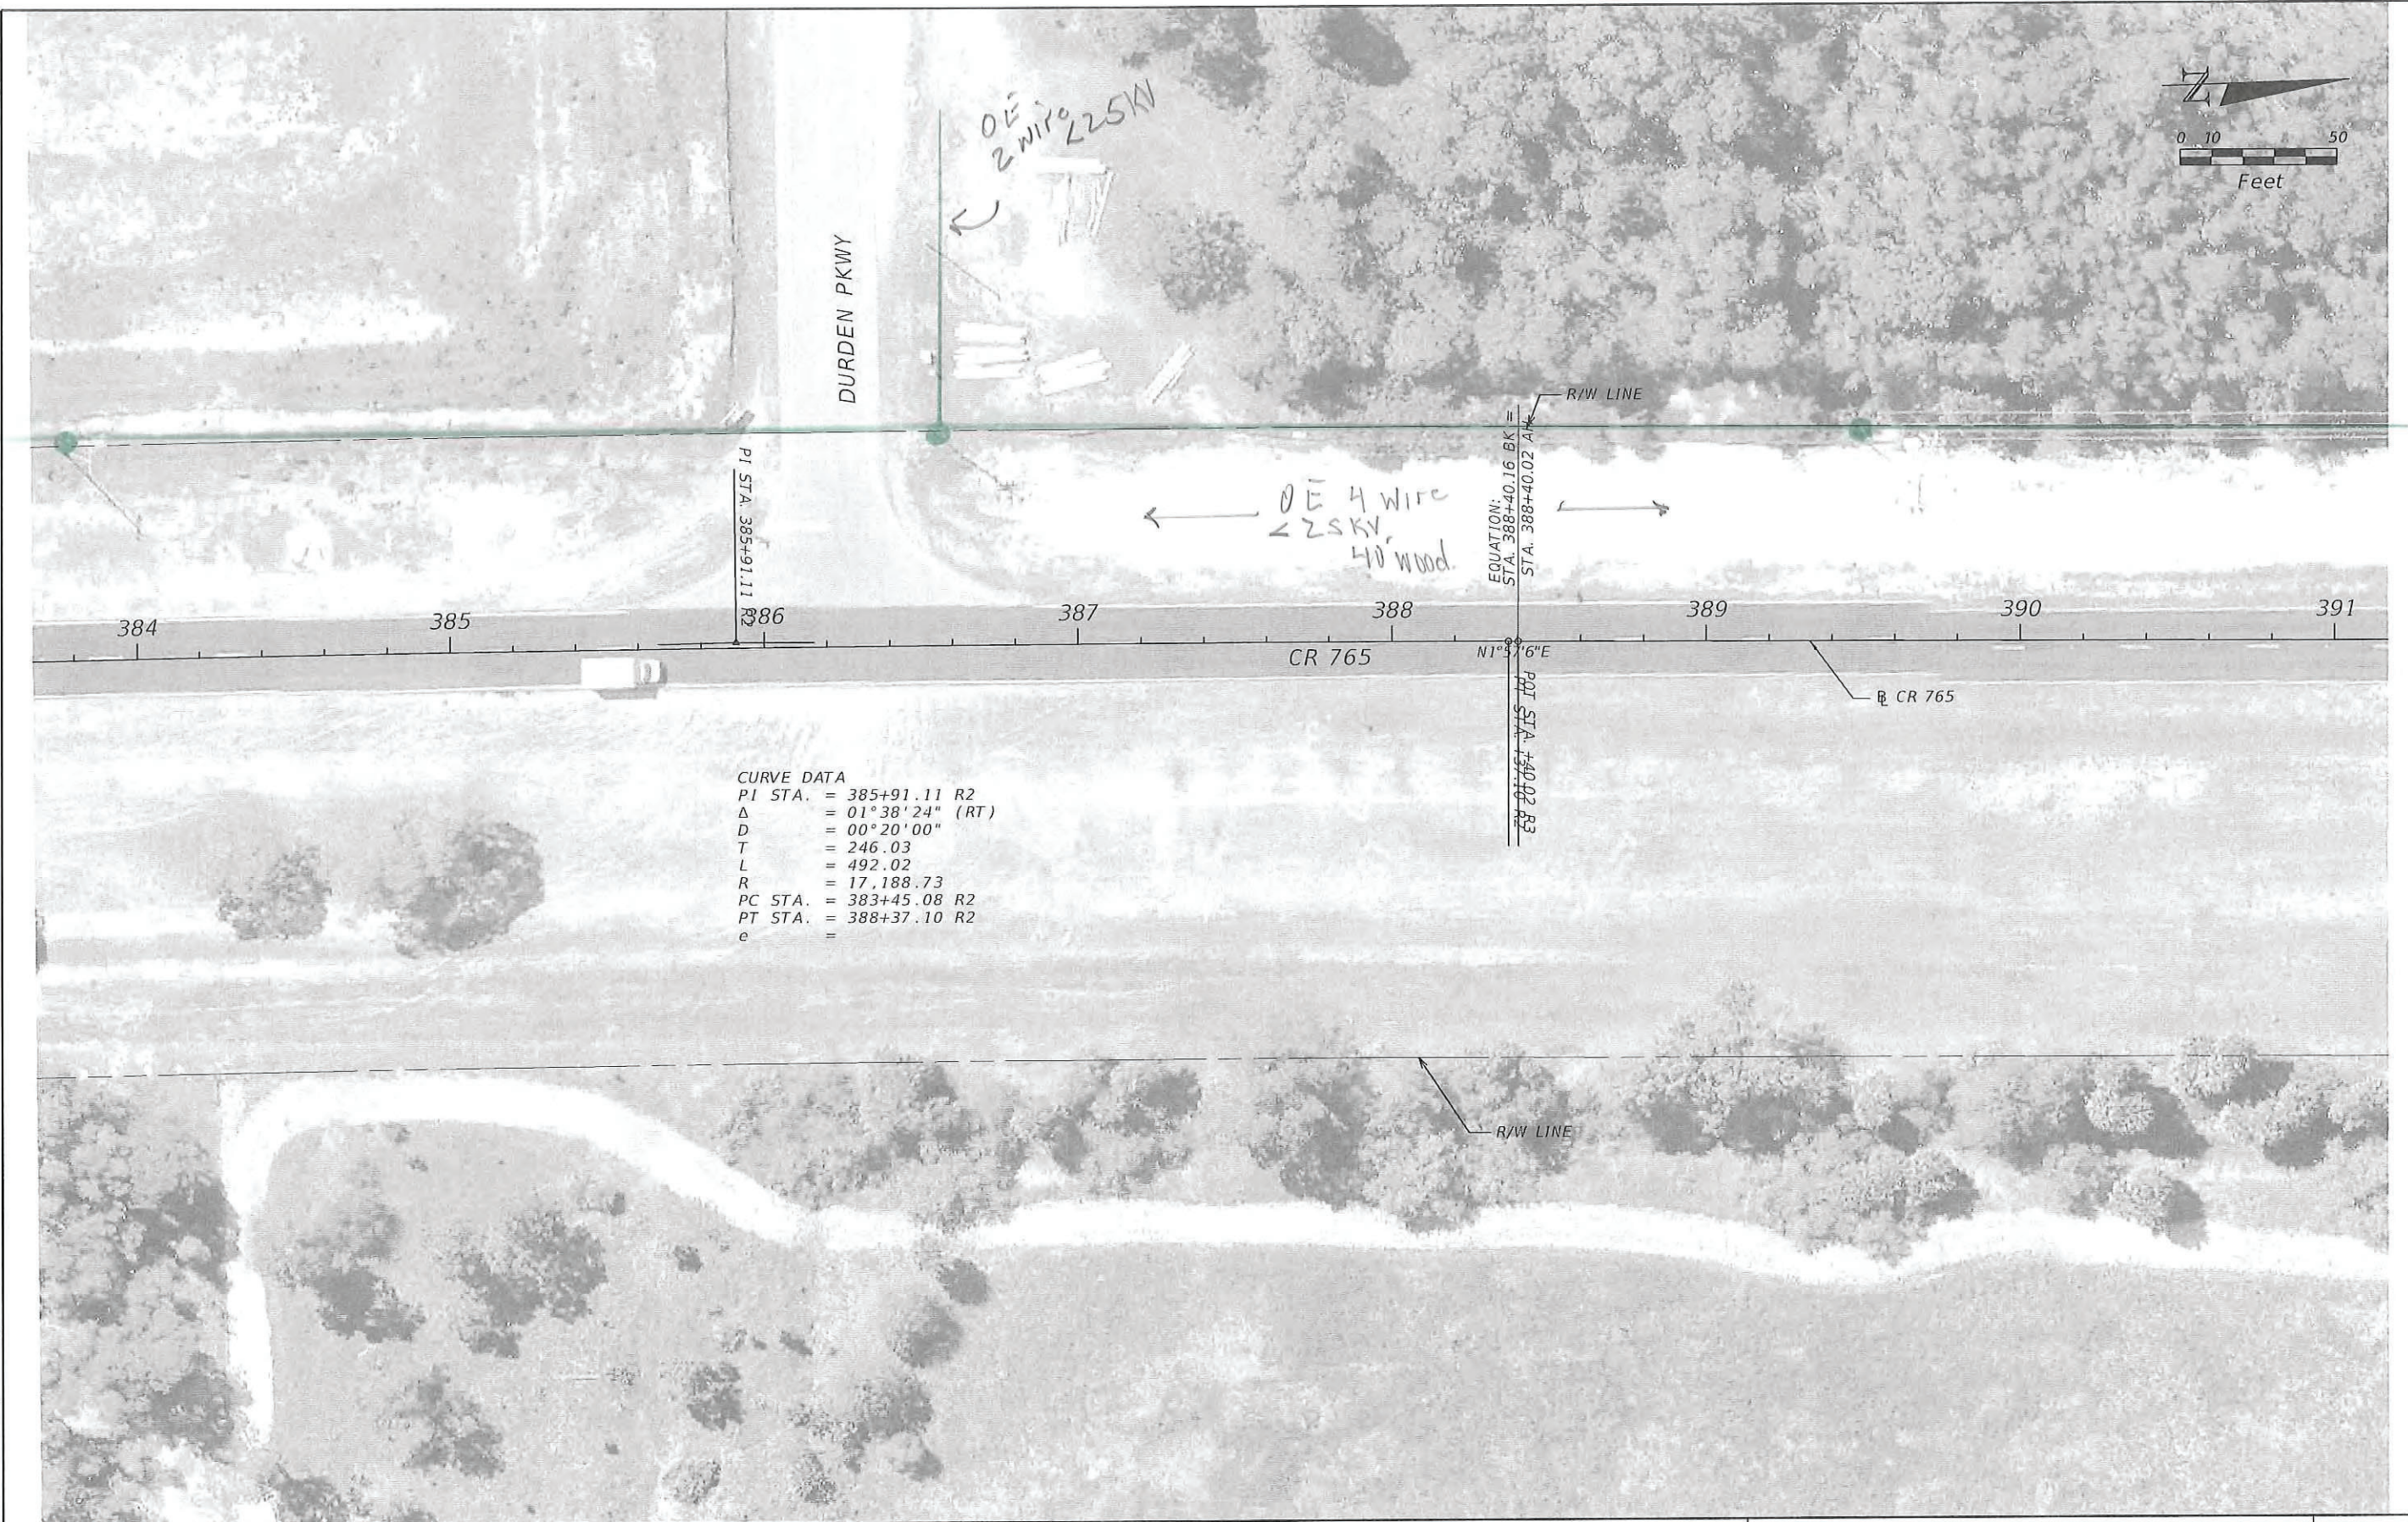

CURVE DATA
 PI STA. = 385+91.11 R2
 Δ = 01°38'24" (RT)
 D = 00°20'00"
 T = 246.03
 L = 492.02
 R = 17,188.73
 PC STA. = 383+45.08 R2
 PT STA. = 388+37.10 R2
 e =

REVISIONS				ENGINEER OF RECORD	STATE OF FLORIDA DEPARTMENT OF TRANSPORTATION			ROADWAY PLAN (24)	SHEET NO.
DATE	DESCRIPTION	DATE	DESCRIPTION		ROAD NO.	COUNTY	FINANCIAL PROJECT ID		
				JAMES M. WINTER, JR., P.E. LICENSE NUMBER 55514 SCALAR CONSULTING GROUP INC. 13337 N. 56TH STREET TAMPA, FLORIDA 33617	CR 765	LEE	436928-1-22-01	25	


THE OFFICIAL RECORD OF THIS SHEET IS THE ELECTRONIC FILE DIGITALLY SIGNED AND SEALED UNDER RULE 61G15-23.004, F.A.C.

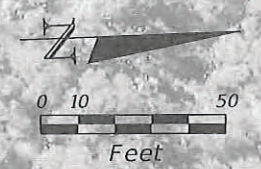

9/10/2020 4:41:50 PM Guest1
 C:\Works\VF007\43692812201\Roadway\Plan 25.dgn

THE OFFICIAL RECORD OF THIS SHEET IS THE ELECTRONIC FILE DIGITALLY SIGNED AND SEALED UNDER RULE 61G15-23.004, F.A.C.

REVISIONS				ENGINEER OF RECORD		STATE OF FLORIDA DEPARTMENT OF TRANSPORTATION			ROADWAY PLAN (25)	SHEET NO. 26
DATE	DESCRIPTION	DATE	DESCRIPTION							
				JAMES M. WINTER, JR., P.E. LICENSE NUMBER 55514 SCALAR CONSULTING GROUP INC. 13337 N. 56TH STREET TAMPA, FLORIDA 33617		ROAD NO.	COUNTY	FINANCIAL PROJECT ID		
						CR 765	LEE	436928-1-22-01		

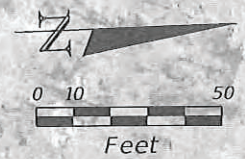

9/10/2020 4:42:00 PM Guest1
 C:\Worksets\FDOT\36692812201\Gateway\Plan_26.dgn

THE OFFICIAL RECORD OF THIS SHEET IS THE ELECTRONIC FILE DIGITALLY SIGNED AND SEALED UNDER RULE 61G15-23.004, F.A.C.


REVISIONS				ENGINEER OF RECORD	STATE OF FLORIDA DEPARTMENT OF TRANSPORTATION			ROADWAY PLAN (26)	SHEET NO.
DATE	DESCRIPTION	DATE	DESCRIPTION		ROAD NO.	COUNTY	FINANCIAL PROJECT ID		
				JAMES M. WINTER, JR., P.E. LICENSE NUMBER 55514 SCALAR CONSULTING GROUP INC. 13337 N. 56TH STREET TAMPA, FLORIDA 33617	CR 765	LEE	436928-1-22-01	27	

9/10/2020 4:42:10 PM Guest1
 C:\Worksets\FDOT\43692812201\Roadway\Plan 27.dgn



REVISIONS				ENGINEER OF RECORD	STATE OF FLORIDA DEPARTMENT OF TRANSPORTATION			ROADWAY PLAN (27)	SHEET NO.
DATE	DESCRIPTION	DATE	DESCRIPTION		ROAD NO.	COUNTY	FINANCIAL PROJECT ID		
				JAMES M. WINTER, JR., P.E. LICENSE NUMBER 55514 SCALAR CONSULTING GROUP INC. 13337 N. 56TH STREET TAMPA, FLORIDA 33617	CR 765	LEE	436928-1-22-01	28	


THE OFFICIAL RECORD OF THIS SHEET IS THE ELECTRONIC FILE DIGITALLY SIGNED AND SEALED UNDER RULE 61G15-23.004, F.A.C.

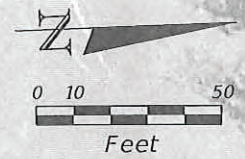

9/10/2020 4:42:19 PM Guest
C:\Worksets\FDOT\13692812201\roadway\Plan_28.dgn

THE OFFICIAL RECORD OF THIS SHEET IS THE ELECTRONIC FILE DIGITALLY SIGNED AND SEALED UNDER RULE 61G15-23.004, F.A.C.


REVISIONS				ENGINEER OF RECORD	STATE OF FLORIDA DEPARTMENT OF TRANSPORTATION			ROADWAY PLAN (28)	SHEET NO.
DATE	DESCRIPTION	DATE	DESCRIPTION		ROAD NO.	COUNTY	FINANCIAL PROJECT ID		
				JAMES M. WINTER, JR., P.E. LICENSE NUMBER 55514 SCALAR CONSULTING GROUP INC. 13337 N. 56TH STREET TAMPA, FLORIDA 33617	CR 765	LEE	436928-1-22-01	29	

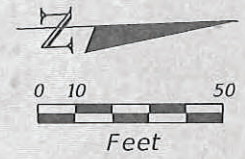

9/10/2020 4:42:28 PM Guest
 C:\Workspaces\FDOT\43692812201\roadway\Plan_29.dgn

THE OFFICIAL RECORD OF THIS SHEET IS THE ELECTRONIC FILE DIGITALLY SIGNED AND SEALED UNDER RULE 61G15-23.004, F.A.C.

REVISIONS				ENGINEER OF RECORD	STATE OF FLORIDA DEPARTMENT OF TRANSPORTATION			ROADWAY PLAN (29)	SHEET NO.
DATE	DESCRIPTION	DATE	DESCRIPTION	JAMES M. WINTER, JR., P.E. LICENSE NUMBER 55514 SCALAR CONSULTING GROUP INC. 13337 N. 56TH STREET TAMPA, FLORIDA 33617	ROAD NO.	COUNTY	FINANCIAL PROJECT ID		30
					CR 765	LEE	436928-1-22-01		

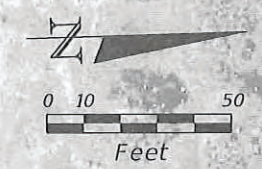

9/11/2020 9:24:36 AM Guest1
 C:\worksets\FDOT\43692812201\roadway\Plan_30.dgn

REVISIONS				ENGINEER OF RECORD	STATE OF FLORIDA DEPARTMENT OF TRANSPORTATION			ROADWAY PLAN (30)	SHEET NO.
DATE	DESCRIPTION	DATE	DESCRIPTION		ROAD NO.	COUNTY	FINANCIAL PROJECT ID		
				JAMES M. WINTER, JR., P.E. LICENSE NUMBER 55514 SCALAR CONSULTING GROUP INC. 13337 N. 56TH STREET TAMPA, FLORIDA 33617	CR 765	LEE	436928-1-22-01		31

THE OFFICIAL RECORD OF THIS SHEET IS THE ELECTRONIC FILE DIGITALLY SIGNED AND SEALED UNDER RULE 61G15-23.004, F.A.C.



9/11/2020 9:24:48 AM Guest
 C:\w\projects\FDOT\436928\2201\roadway\Plan_31.dgn

THE OFFICIAL RECORD OF THIS SHEET IS THE ELECTRONIC FILE DIGITALLY SIGNED AND SEALED UNDER RULE 61G15-23.004, F.A.C.



REVISIONS				ENGINEER OF RECORD	STATE OF FLORIDA DEPARTMENT OF TRANSPORTATION			ROADWAY PLAN (31)	SHEET NO.
DATE	DESCRIPTION	DATE	DESCRIPTION		ROAD NO.	COUNTY	FINANCIAL PROJECT ID		
				JAMES M. WINTER, JR., P.E. LICENSE NUMBER 55514 SCALAR CONSULTING GROUP INC. 13337 N. 56TH STREET TAMPA, FLORIDA 33617	CR 765	LEE	436928-1-22-01		32



9/11/2020 9:24:58 AM Guest1
 C:\work\scs\FDOT\43692812201\Roadway\Plan_32.dgn

THE OFFICIAL RECORD OF THIS SHEET IS THE ELECTRONIC FILE DIGITALLY SIGNED AND SEALED UNDER RULE 61G15-23.004, F.A.C.



REVISIONS				ENGINEER OF RECORD		STATE OF FLORIDA DEPARTMENT OF TRANSPORTATION			ROADWAY PLAN (32)	SHEET NO.
DATE	DESCRIPTION	DATE	DESCRIPTION	JAMES M. WINTER, JR., P.E. LICENSE NUMBER 55514 SCALAR CONSULTING GROUP INC. 13337 N. 56TH STREET TAMPA, FLORIDA 33617		ROAD NO.	COUNTY	FINANCIAL PROJECT ID		
						CR 765	LEE	436928-1-22-01		33

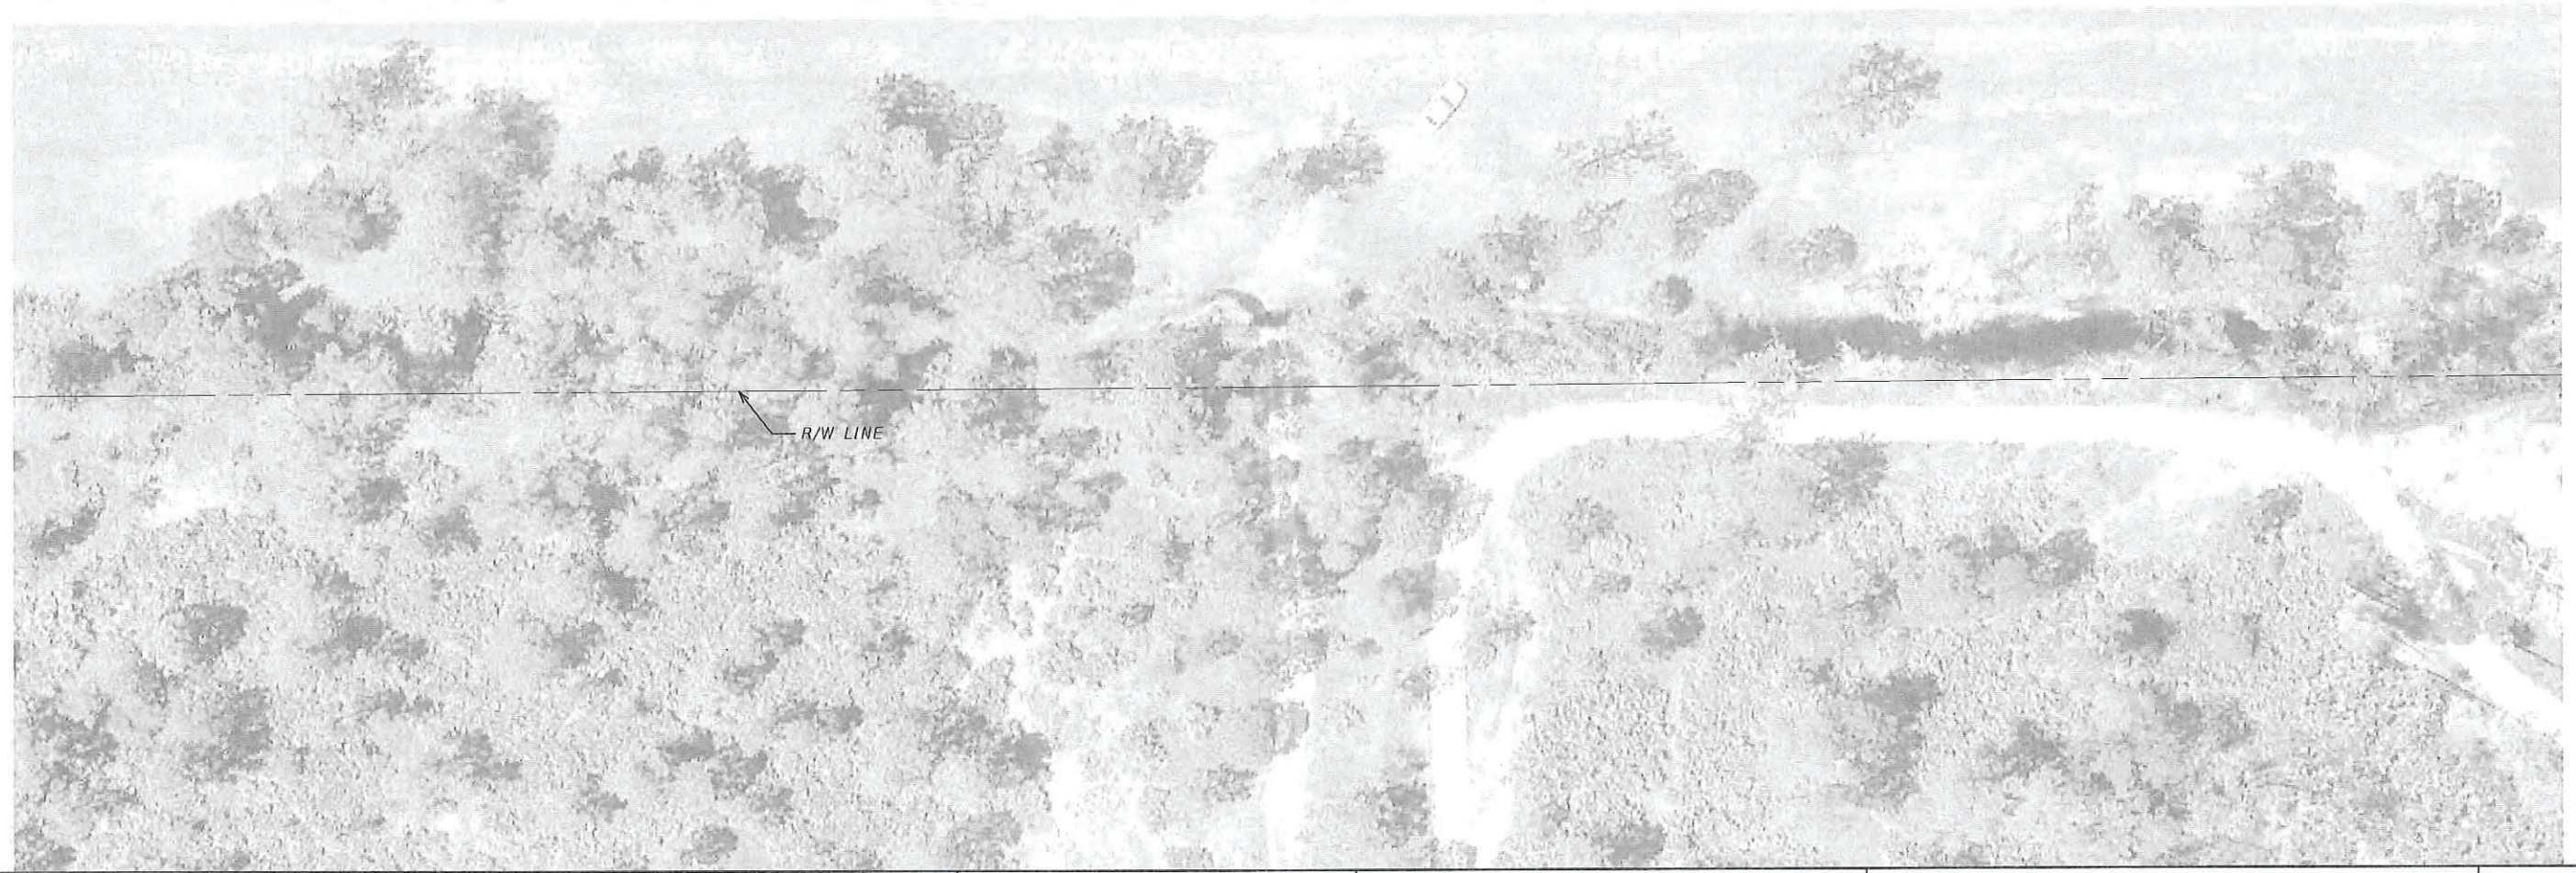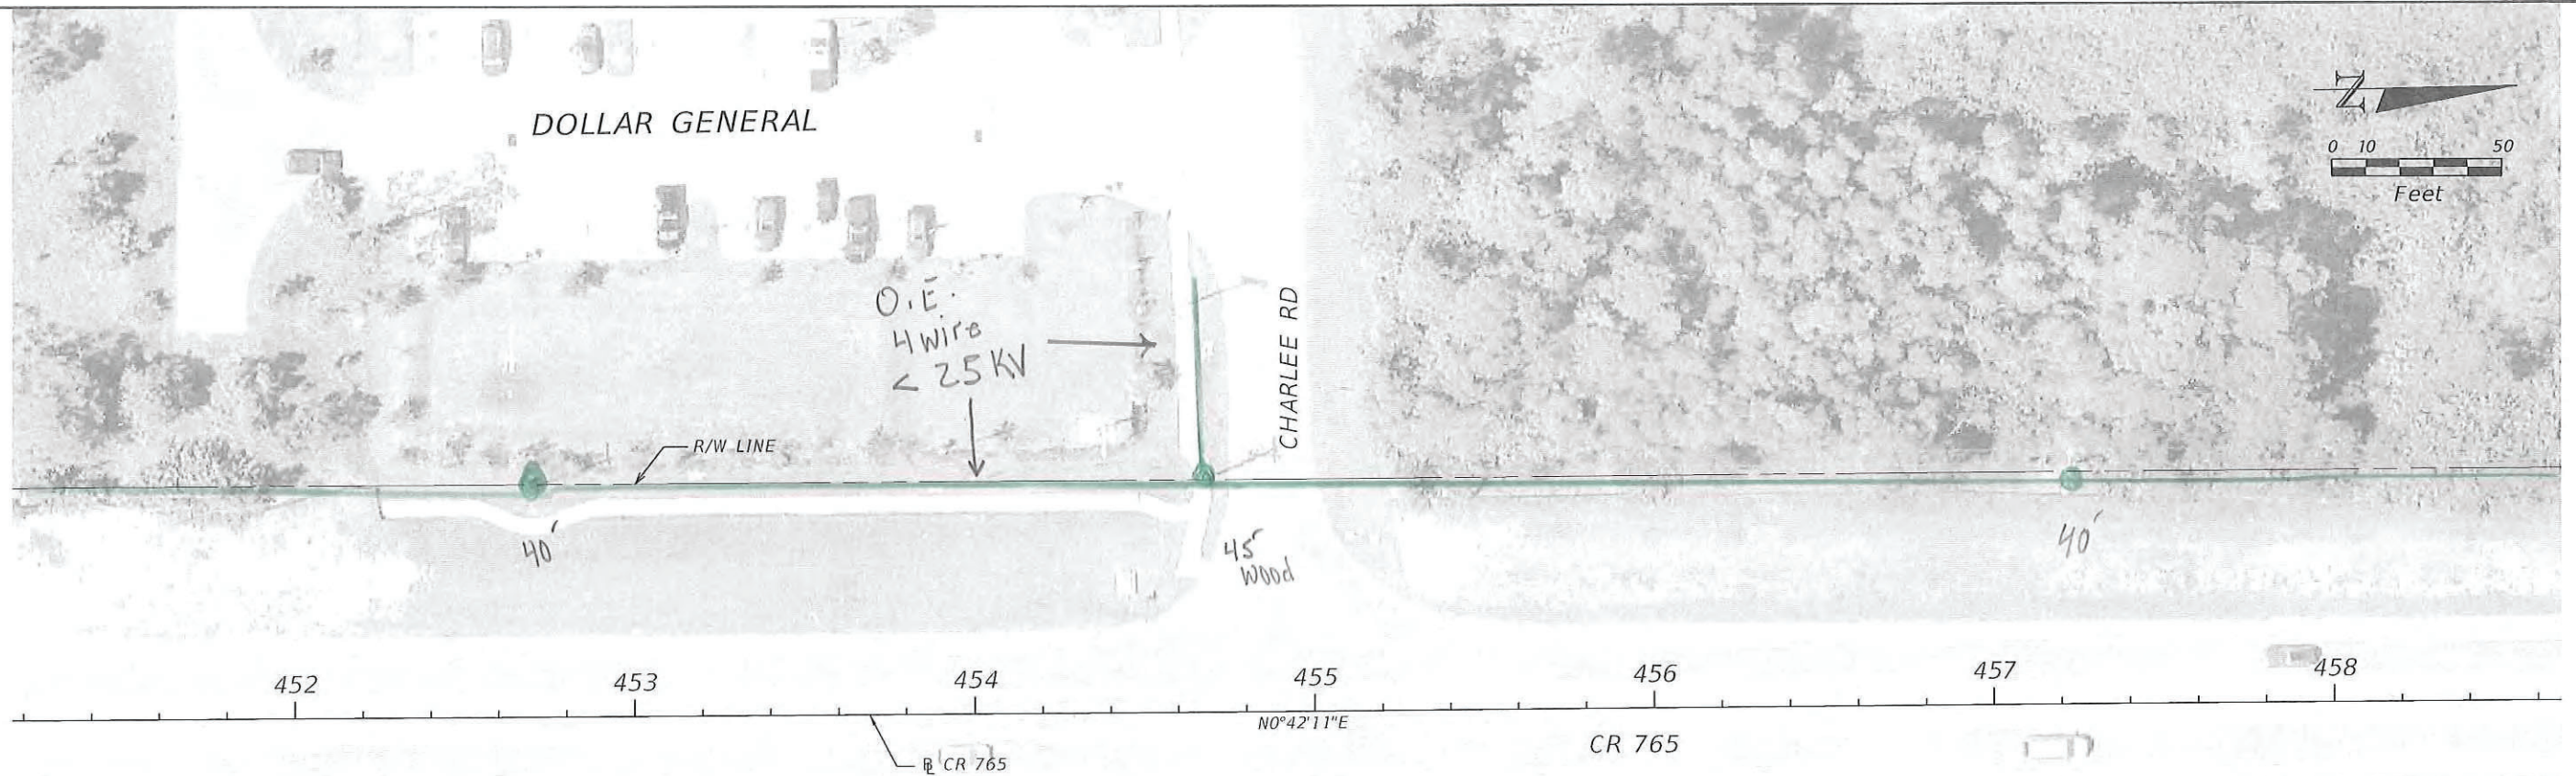

9/11/2020 9:25:07 AM Guest1
 C:\Worksets\FDOT\43692812201\roadway\Plan_33.dgn

THE OFFICIAL RECORD OF THIS SHEET IS THE ELECTRONIC FILE DIGITALLY SIGNED AND SEALED UNDER RULE 61G15-23.004, F.A.C.

REVISIONS				ENGINEER OF RECORD		STATE OF FLORIDA DEPARTMENT OF TRANSPORTATION			ROADWAY PLAN (33)	SHEET NO.
DATE	DESCRIPTION	DATE	DESCRIPTION	JAMES M. WINTER, JR., P.E. LICENSE NUMBER 55514 SCALAR CONSULTING GROUP INC. 13337 N. 56TH STREET TAMPA, FLORIDA 33617		ROAD NO.	COUNTY	FINANCIAL PROJECT ID		
						CR 765	LEE	436928-1-22-01		34

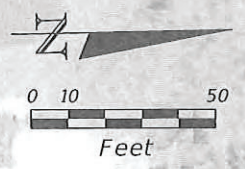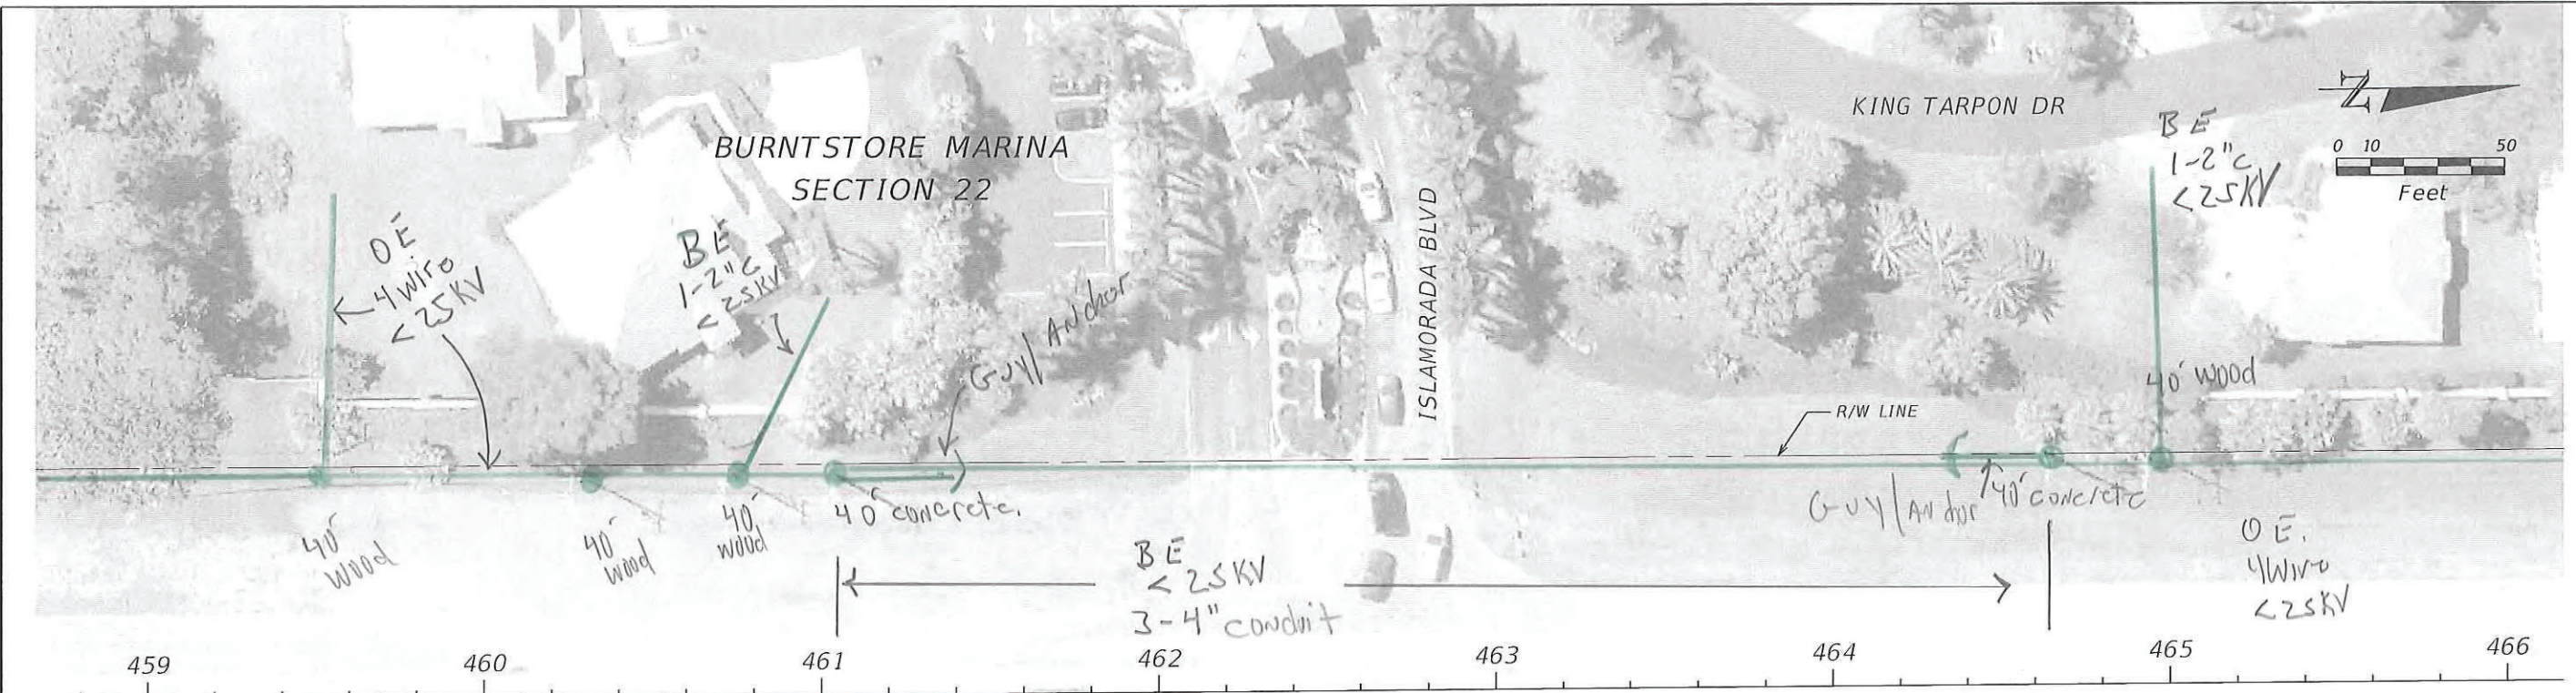

9/11/2020 9:25:16 AM Guest1
 C:\Worksets\FDOT\43692812201\roadway\Plan_34.dgn

THE OFFICIAL RECORD OF THIS SHEET IS THE ELECTRONIC FILE DIGITALLY SIGNED AND SEALED UNDER RULE 61G15-23.004, F.A.C.

REVISIONS				ENGINEER OF RECORD		STATE OF FLORIDA DEPARTMENT OF TRANSPORTATION			ROADWAY PLAN (34)	SHEET NO. 35
DATE	DESCRIPTION	DATE	DESCRIPTION	JAMES M. WINTER, JR., P.E. LICENSE NUMBER 55514 SCALAR CONSULTING GROUP INC. 13337 N. 56TH STREET TAMPA, FLORIDA 33617		ROAD NO.	COUNTY	FINANCIAL PROJECT ID		
						CR 765	LEE	436928-1-22-01		

9/11/2020 9:25:25 AM Guest1
 C:\Worksets\FDOT\43692812201\Roadway\Plan_35.dgn



THE OFFICIAL RECORD OF THIS SHEET IS THE ELECTRONIC FILE DIGITALLY SIGNED AND SEALED UNDER RULE 61G15-23.004, F.A.C.

REVISIONS		ENGINEER OF RECORD		STATE OF FLORIDA DEPARTMENT OF TRANSPORTATION			ROADWAY PLAN (35)	SHEET NO.
DATE	DESCRIPTION	DATE	DESCRIPTION	ROAD NO.	COUNTY	FINANCIAL PROJECT ID		
				CR 765	LEE	436928-1-22-01		36

JAMES M. WINTER, JR., P.E.
 LICENSE NUMBER 55514
 SCALAR CONSULTING GROUP INC.
 13337 N. 56TH STREET
 TAMPA, FLORIDA 33617



9/11/2020 9:25:35 AM Guest1
 C:\Worksets\FDOT\43692812201\roadway\Plan_36.dgn

THE OFFICIAL RECORD OF THIS SHEET IS THE ELECTRONIC FILE DIGITALLY SIGNED AND SEALED UNDER RULE 61G15-23.004, F.A.C.

REVISIONS				ENGINEER OF RECORD		STATE OF FLORIDA DEPARTMENT OF TRANSPORTATION			ROADWAY PLAN (36)	SHEET NO. 37
DATE	DESCRIPTION	DATE	DESCRIPTION	JAMES M. WINTER, JR., P.E. LICENSE NUMBER 55514 SCALAR CONSULTING GROUP INC. 13337 N. 56TH STREET TAMPA, FLORIDA 33617		ROAD NO.	COUNTY	FINANCIAL PROJECT ID		
						CR 765	LEE	436928-1-22-01		




CURVE DATA

PI STA.	= 488+51.18 R5
Δ	= 02°36'10" (LT)
D	= 00°20'00"
T	= 396.87
L	= 780.80
R	= 17,188.73
PC STA.	= 484+60.71 R5
PT STA.	= 492+41.46 R6
TA STA.	= 488+51.18 R5

9/11/2020 9:25:45 AM Guest
 C:\Users\rsr\Documents\43692812201\Roadway\Plan 37.dgn

THE OFFICIAL RECORD OF THIS SHEET IS THE ELECTRONIC FILE DIGITALLY SIGNED AND SEALED UNDER RULE 61G15-23.004, F.A.C.


REVISIONS				ENGINEER OF RECORD		STATE OF FLORIDA DEPARTMENT OF TRANSPORTATION			ROADWAY PLAN (37)	SHEET NO. 38
DATE	DESCRIPTION	DATE	DESCRIPTION	JAMES M. WINTER, JR., P.E. LICENSE NUMBER 55514 SCALAR CONSULTING GROUP INC. 13337 N. 56TH STREET TAMPA, FLORIDA 33617		ROAD NO.	COUNTY	FINANCIAL PROJECT ID		
								CR 765		

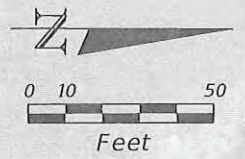

9/11/2020 9:25:55 AM Guest1
 C:\Work\6665\FDOT\436928\12201\Roadway\Plan_38.dgn

THE OFFICIAL RECORD OF THIS SHEET IS THE ELECTRONIC FILE DIGITALLY SIGNED AND SEALED UNDER RULE 61G15-23.004, F.A.C.





REVISIONS				ENGINEER OF RECORD		STATE OF FLORIDA DEPARTMENT OF TRANSPORTATION			ROADWAY PLAN (38)	SHEET NO. 39
DATE	DESCRIPTION	DATE	DESCRIPTION			ROAD NO.	COUNTY	FINANCIAL PROJECT ID		
				JAMES M. WINTER, JR., P.E. LICENSE NUMBER 55514 SCALAR CONSULTING GROUP INC. 13337 N. 56TH STREET TAMPA, FLORIDA 33617		CR 765	LEE	436928-1-22-01		

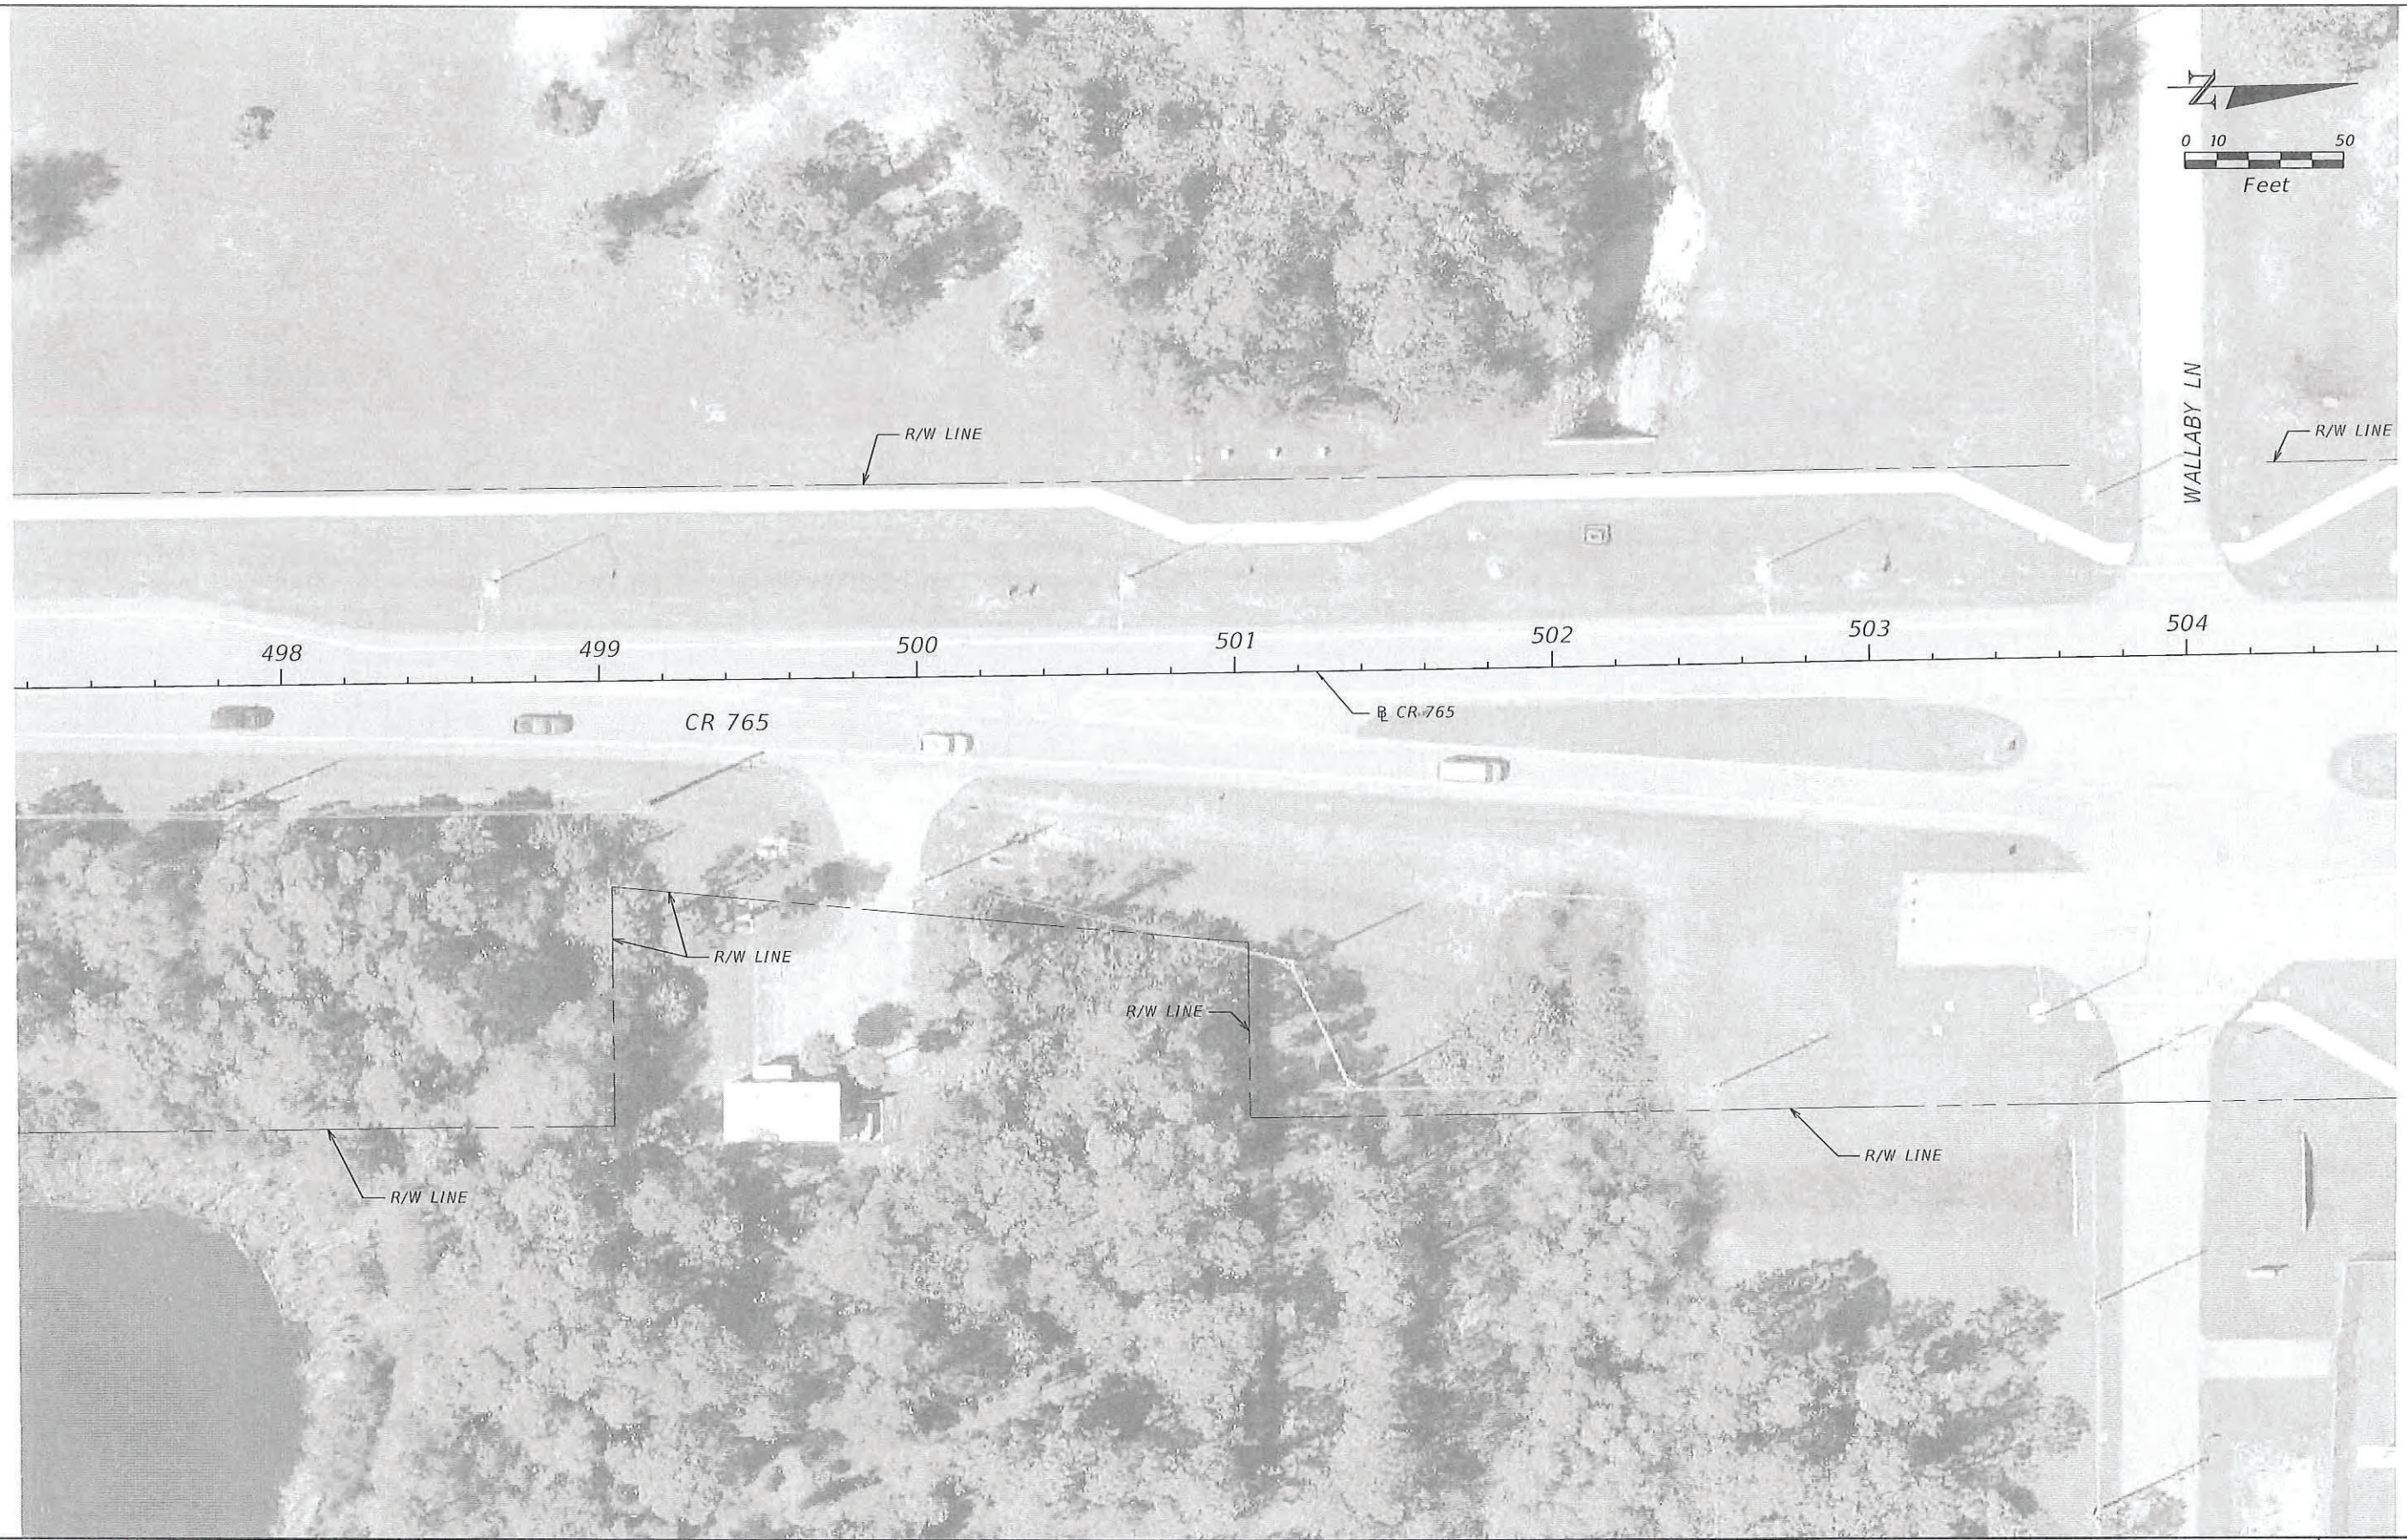

9/11/2020 9:26:05 AM Guest1
 C:\Worksets\FDOT\43692812201\Roadway\Plan 39.dgn

THE OFFICIAL RECORD OF THIS SHEET IS THE ELECTRONIC FILE DIGITALLY SIGNED AND SEALED UNDER RULE 61G15-23.004, F.A.C.

REVISIONS				ENGINEER OF RECORD	STATE OF FLORIDA DEPARTMENT OF TRANSPORTATION			ROADWAY PLAN (39)	SHEET NO.
DATE	DESCRIPTION	DATE	DESCRIPTION		ROAD NO.	COUNTY	FINANCIAL PROJECT ID		
				JAMES M. WINTER, JR., P.E. LICENSE NUMBER 55514 SCALAR CONSULTING GROUP INC. 13337 N. 56TH STREET TAMPA, FLORIDA 33617	CR 765	LEE	436928-1-22-01	40	

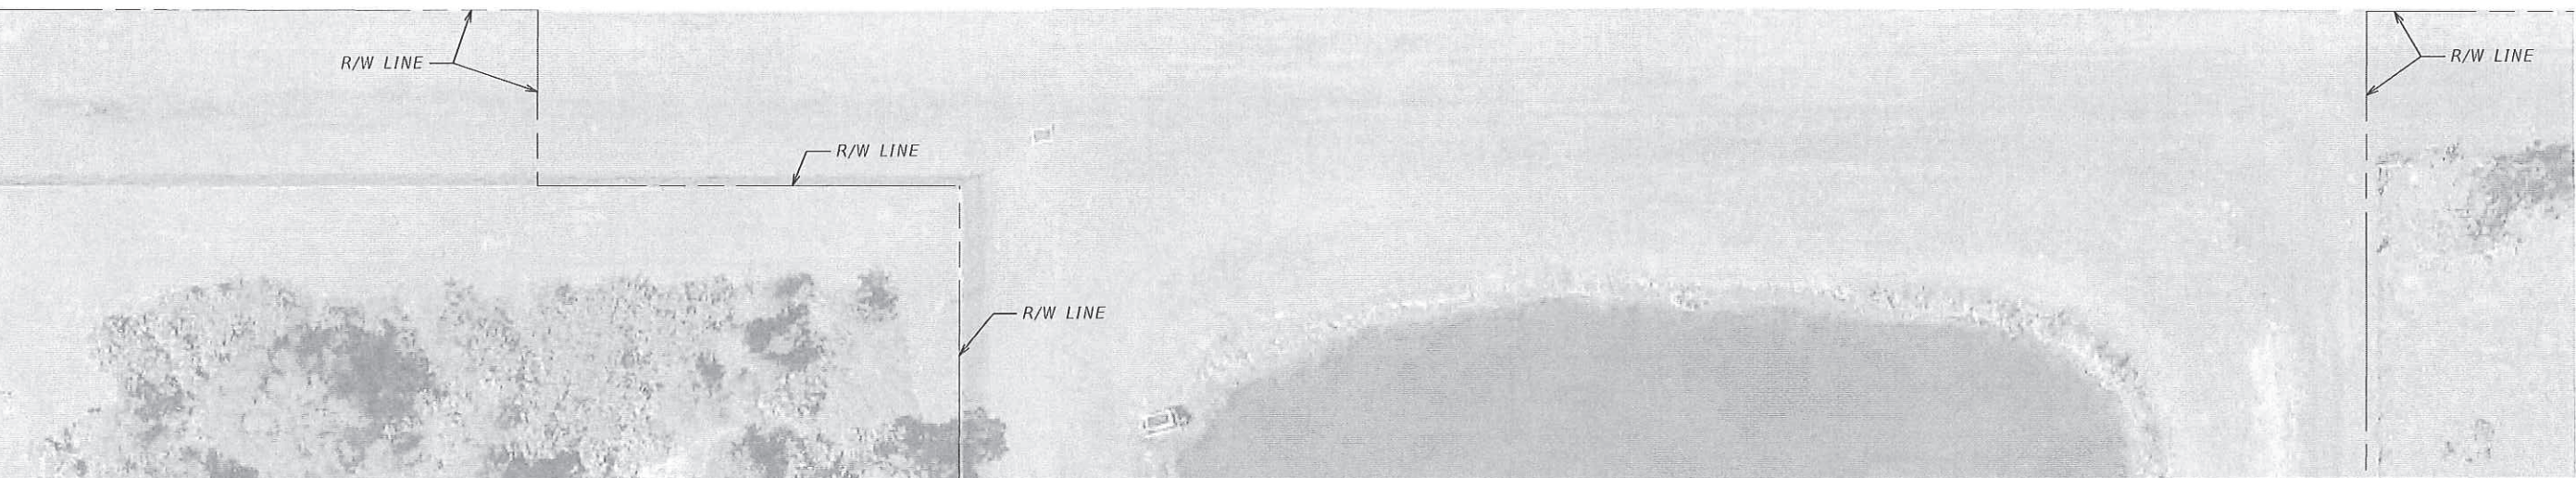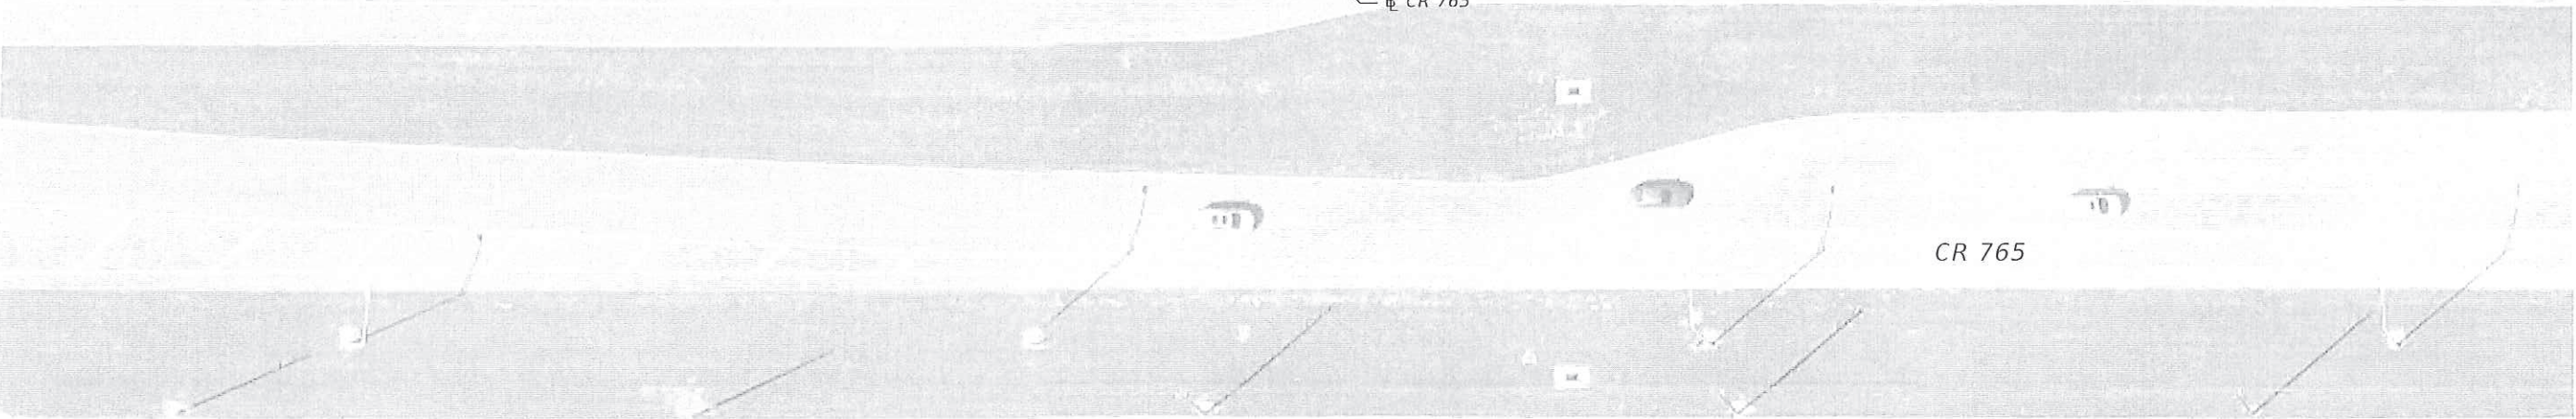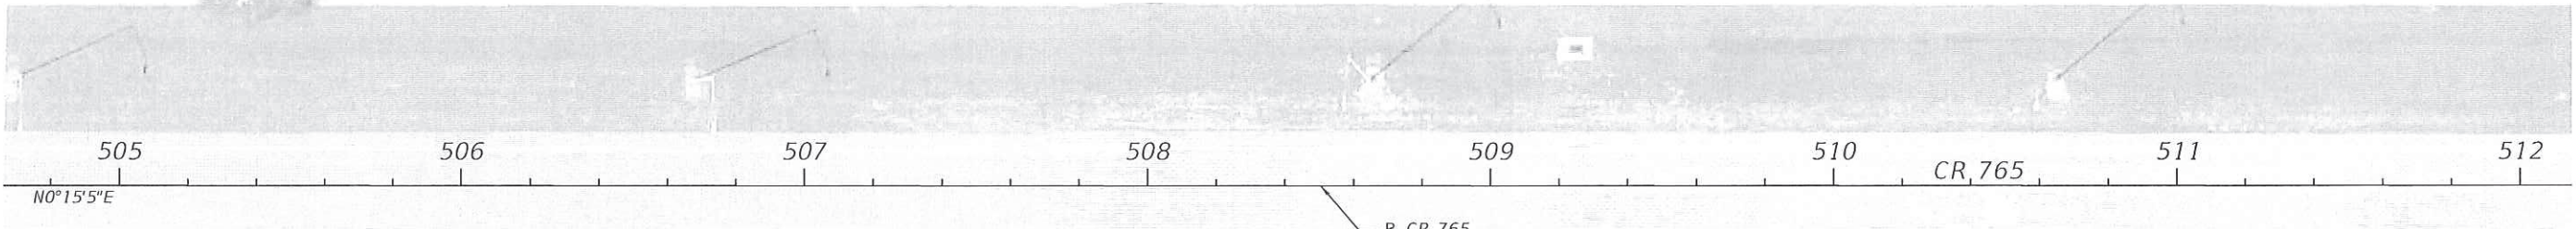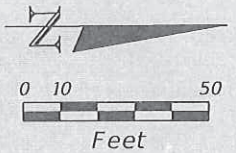

9/11/2020 9:26:14 AM Guest1
 C:\Worksets\FDOT\436928\1220\Roadway\Plan 40.dgn

REVISIONS				ENGINEER OF RECORD	STATE OF FLORIDA DEPARTMENT OF TRANSPORTATION			ROADWAY PLAN (40)	SHEET NO.
DATE	DESCRIPTION	DATE	DESCRIPTION		ROAD NO.	COUNTY	FINANCIAL PROJECT ID		
				JAMES M. WINTER, JR., P.E. LICENSE NUMBER 55514 SCALAR CONSULTING GROUP INC. 13337 N. 56TH STREET TAMPA, FLORIDA 33617	CR 765	LEE	436928-1-22-01	41	

THE OFFICIAL RECORD OF THIS SHEET IS THE ELECTRONIC FILE DIGITALLY SIGNED AND SEALED UNDER RULE 61G15-23.004, F.A.C.

LEE COUNTY SIGNAL DEPARTMENT

From: [Fencil, James](#)
To: [Winnie Kwong](#),
Cc: [Kirsch, Ryan](#); [Padgett, Michael](#)
Subject: 436928-1: Burnt Store Rd PD&E Study- Initial UAO coordination
Date: Thursday, September 24, 2020 10:19:06 AM
Attachments: [Pages from 436928-1 Greenlines red Lee County Traffic Grenlines 200924.pdf](#)

Winnie,
Lee County Traffic's Green lines for this UAO.

Thank you



[Get Counted Now!](#)

Please note: Florida has a very broad public records law. Most written communications to or from County Employees and officials regarding County business are public records available to the public and media upon request. Your email communication may be subject to public disclosure.

Under Florida law, email addresses are public records. If you do not want your email address released in response to a public records request, do not send electronic mail to this entity. Instead, contact this office by phone or in writing.

COMPONENTS OF CONTRACT PLANS SET

ROADWAY PLANS

STATE OF FLORIDA
DEPARTMENT OF TRANSPORTATION

CONTRACT PLANS


FINANCIAL PROJECT ID 436928-1-22-01

LEE COUNTY


COUNTY ROAD NO. CR 765

INDEX OF ROADWAY PLANS


SHEET NO.	SHEET DESCRIPTION
1	KEY SHEET
2 - 41	ROADWAY PLAN

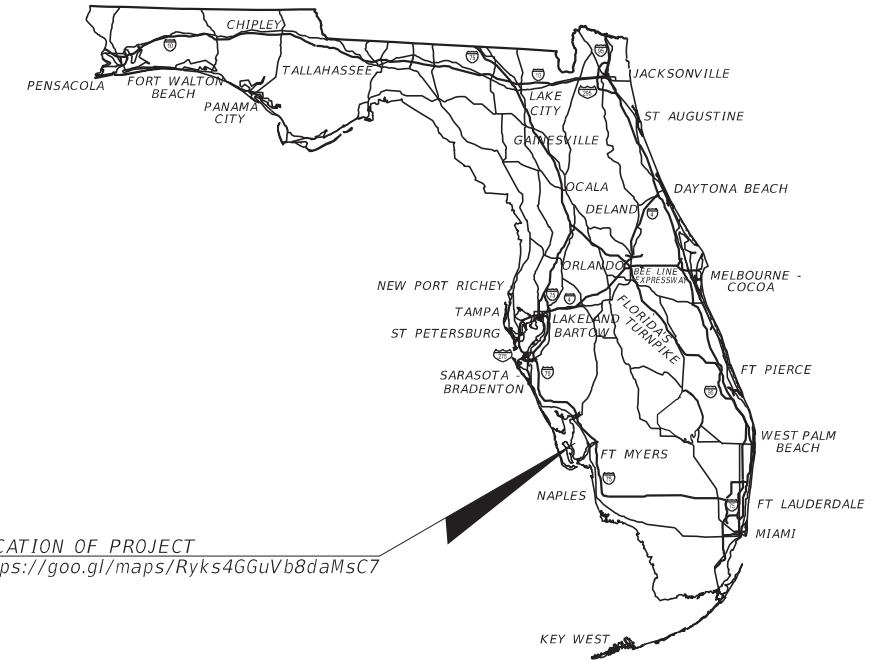

LOCATION OF PROJECT
<https://goo.gl/maps/Ryks4GGuVb8daMsC7>

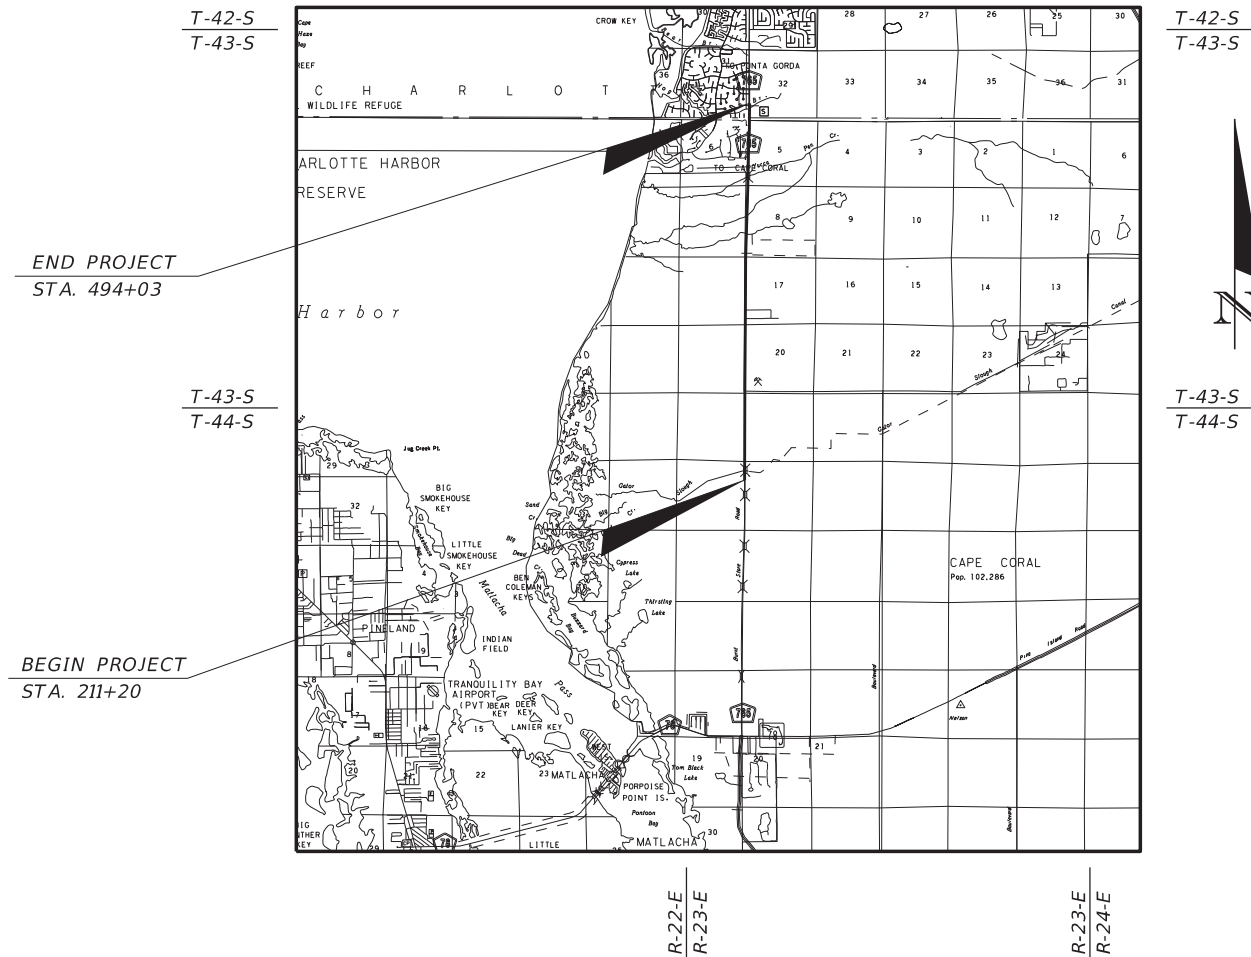

GREENLINES SUBMITTAL
SEPTEMBER 2020

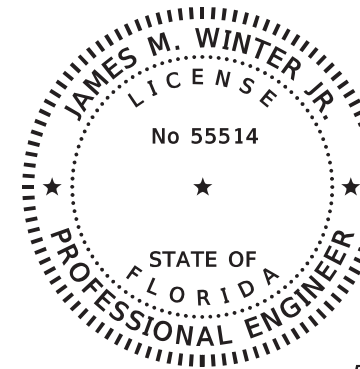

THIS ITEM HAS BEEN DIGITALLY
SIGNED AND SEALED BY

ON THE DATE ADJACENT TO THE SEAL
PRINTED COPIES OF THIS DOCUMENT ARE
NOT CONSIDERED SIGNED AND SEALED
AND THE SIGNATURE MUST BE VERIFIED
ON ANY ELECTRONIC COPIES.

ROADWAY PLANS
ENGINEER OF RECORD:

JAMES M. WINTER, JR., P.E.
P.E. LICENSE NUMBER 55514
SCALAR CONSULTING GROUP INC.
13337 N. 56TH STREET
TAMPA, FLORIDA 33617

FDOT PROJECT MANAGER:

STEVEN A. ANDREWS



CONSTRUCTION CONTRACT NO.	FISCAL YEAR	SHEET NO.
		1



9/10/2020 4:37:59 PM Guest1
 C:\worksets\FDOT\4369281\2201\Roadway\Plan 1.dgn

THE OFFICIAL RECORD OF THIS SHEET IS THE ELECTRONIC FILE DIGITALLY SIGNED AND SEALED UNDER RULE 61G15-23.004, F.A.C.

REVISIONS				ENGINEER OF RECORD		STATE OF FLORIDA DEPARTMENT OF TRANSPORTATION			SHEET NO.
DATE	DESCRIPTION	DATE	DESCRIPTION			ROAD NO.	COUNTY	FINANCIAL PROJECT ID	
				JAMES M. WINTER, JR., P.E. LICENSE NUMBER 55514 SCALAR CONSULTING GROUP INC. 13337 N. 56TH STREET TAMPA, FLORIDA 33617		CR 765	LEE	436928-1-22-01	ROADWAY PLAN (1) 2

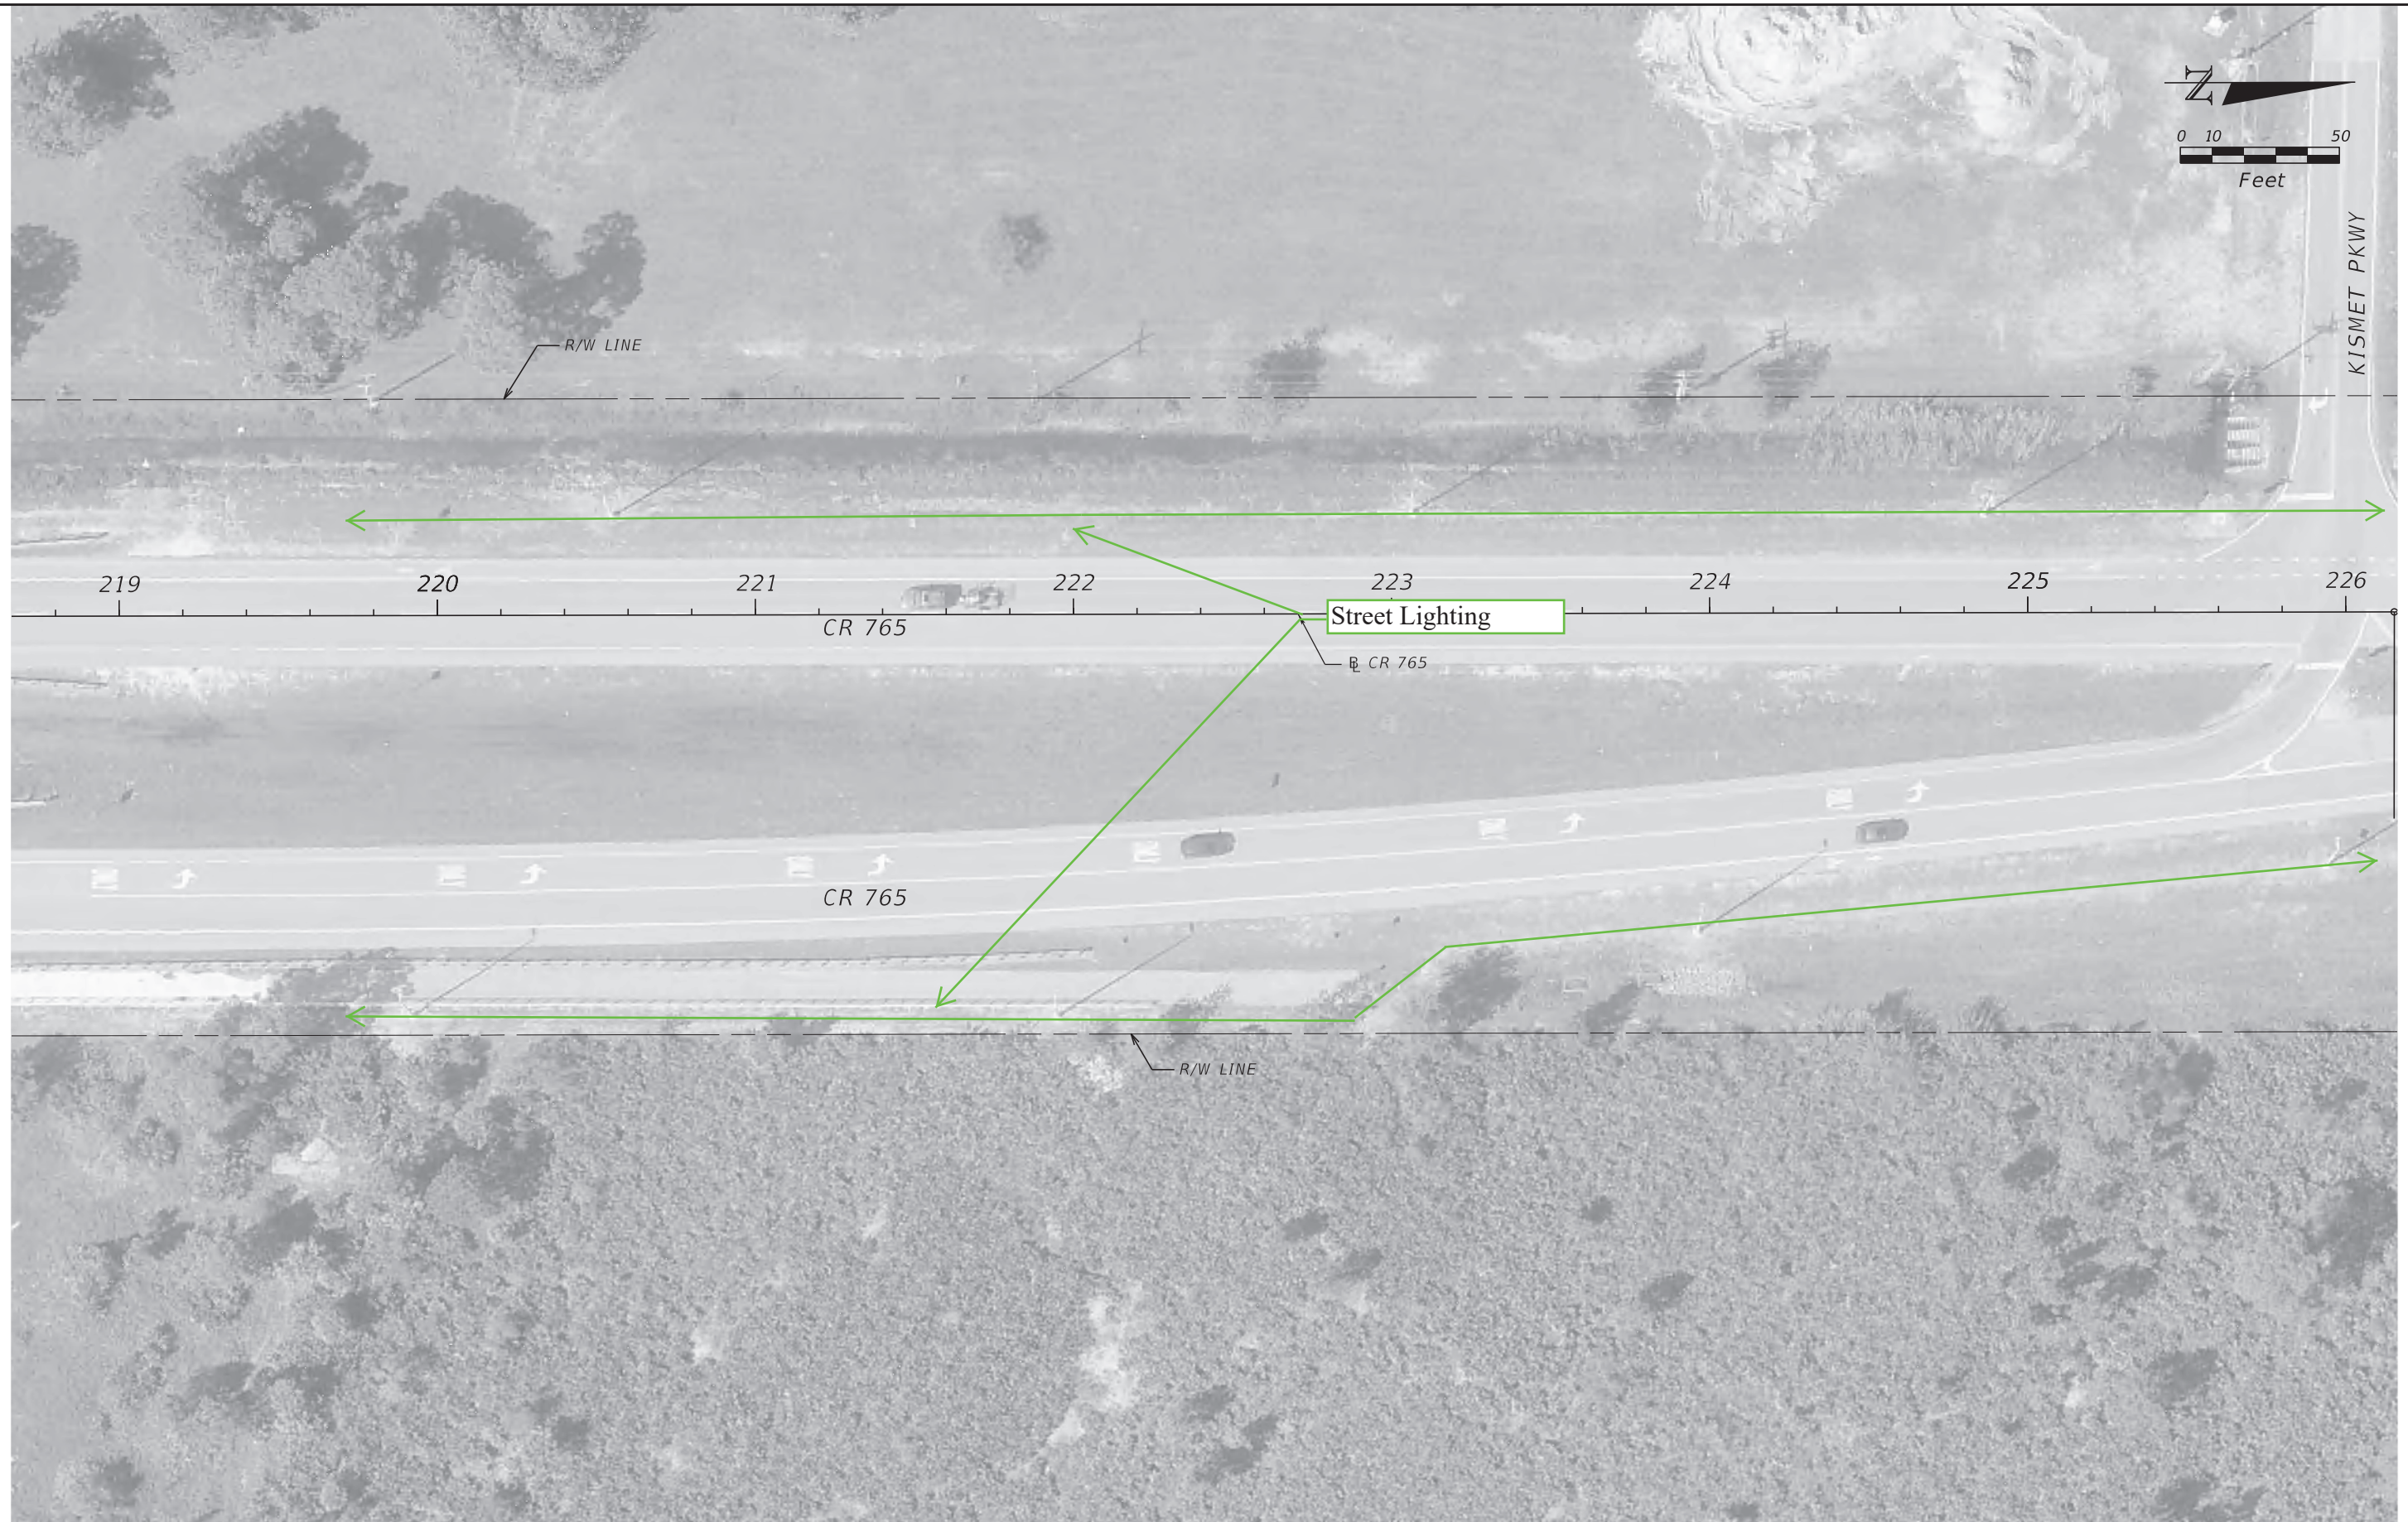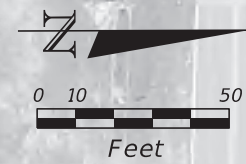


9/10/2020 4:38:09 PM Guest1 C:\worksets\FDOT\4369281\2201\Roadway\Plan 2.dgn

REVISIONS				ENGINEER OF RECORD		STATE OF FLORIDA DEPARTMENT OF TRANSPORTATION			SHEET NO.
DATE	DESCRIPTION	DATE	DESCRIPTION			ROAD NO.	COUNTY	FINANCIAL PROJECT ID	
				JAMES M. WINTER, JR., P.E. LICENSE NUMBER 55514 SCALAR CONSULTING GROUP INC. 13337 N. 56TH STREET TAMPA, FLORIDA 33617		CR 765	LEE	436928-1-22-01	3

ROADWAY PLAN (2)

THE OFFICIAL RECORD OF THIS SHEET IS THE ELECTRONIC FILE DIGITALLY SIGNED AND SEALED UNDER RULE 61G15-23.004, F.A.C.

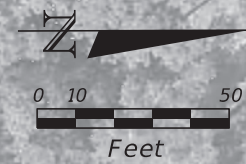


9/10/2020 4:38:19 PM Guest1 C:\worksets\FDOT\4369281\2201\Roadway\Plan 3.dgn

THE OFFICIAL RECORD OF THIS SHEET IS THE ELECTRONIC FILE DIGITALLY SIGNED AND SEALED UNDER RULE 61G15-23.004, F.A.C.

REVISIONS				ENGINEER OF RECORD		STATE OF FLORIDA DEPARTMENT OF TRANSPORTATION			SHEET NO.
DATE	DESCRIPTION	DATE	DESCRIPTION			ROAD NO.	COUNTY	FINANCIAL PROJECT ID	
				JAMES M. WINTER, JR., P.E. LICENSE NUMBER 55514 SCALAR CONSULTING GROUP INC. 13337 N. 56TH STREET TAMPA, FLORIDA 33617		CR 765	LEE	436928-1-22-01	4

ROADWAY PLAN (3)

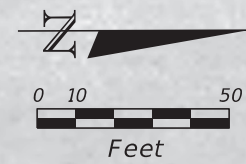

9/10/2020 4:40:36 PM Guest1
C:\Worksets\FDOT\4369281\2201\Roadway\Plan 17.dgn

THE OFFICIAL RECORD OF THIS SHEET IS THE ELECTRONIC FILE DIGITALLY SIGNED AND SEALED UNDER RULE 61G15-23.004, F.A.C.

REVISIONS				ENGINEER OF RECORD		STATE OF FLORIDA DEPARTMENT OF TRANSPORTATION			SHEET NO.
DATE	DESCRIPTION	DATE	DESCRIPTION			ROAD NO.	COUNTY	FINANCIAL PROJECT ID	
				JAMES M. WINTER, JR., P.E. LICENSE NUMBER 55514 SCALAR CONSULTING GROUP INC. 13337 N. 56TH STREET TAMPA, FLORIDA 33617		CR 765	LEE	436928-1-22-01	18
ROADWAY PLAN (17)									

LEE COUNTY UTILITIES

From: [Reycraft, Da id](#)
To: [Winnie Kwong](#)
Subject: RE: 436928-1: Burnt Store Rd PD&E Study- Initial UAO coordination
Date: Friday, September 2 , 2020 10:30: 9 AM
Attachments: [image002.jpg](#)
[image003.png](#)
[image004.png](#)

Ms. Kwong,

The project area is outside of the service area of Lee County Utilities therefore we have no infrastructure in the project area. If you have any problems or questions please let me know.

Thanks,

Dave

David Reycraft, MA, GISP
Manager, Public Utilities
Asset Management and Geographic Information Systems
Lee County Utilities
1500 Monroe St, 3rd Floor
Fort Myers, FL 33901
P 239.533.8150
F 239.485.8385
E dreycraft@leegov.com



From: Winnie Kwong, <wk Wong@scalarinc.net>
Sent: Wednesday, September 23, 2020 11:34 AM
To: tshevche@capecoral.net; Andy.Amendola@CharlotteCountyFL.gov; Maxwell-Newbold, Leonard <leonard_maxwell-newbold@comcast.com>; russb@broadstar.com; Bray, Joel <Joel.Bray@fpl.com>; Haskett, Danny <Danny.Haskett@crowncastle.com>; bruce.bullert@charlottefl.com; Eiverson@pineislandwater.com; ucdinfo@capecoral.net; Kirsch, Ryan <RKirsch@leegov.com>; Tom.Bailey@lcec.net; Reycraft, David <DReycraft@leegov.com>; ronald.o.smith@centurylink.com; craig.clark@centurylink.com
Cc: Kristin Caruso <kcaruso@scalarinc.net>; Andrews, Steven <Steven.Andrews@dot.state.fl.us>
Subject: [EXTERNAL] 436928-1: Burnt Store Rd PD&E Study- Initial UAO coordination

FPN: 436928-1-22-01

Description: Burnt Store Road (CR 765) from Van Buren Parkway to Charlotte County Line PD&E Study

County: Lee

Good morning,

Scalar Consulting Group Inc. has been selected to represent the Florida Department of Transportation in utility coordination between the Department and your agency on the above referenced project.

In an effort to better coordinate the selection of corridor and typical alternatives for roadway widening, and their impact on utilities, I am providing for your review the corridor aerial base maps for the Burnt Store Road PD&E Study. The utilities owned by you may require relocation and/or adjustment as necessitated by the highway construction.

Please mark-up (using the standard FDOT color code) and return one (1) set of aerial maps indicating the location, size and type, etc., of your existing and any future facilities. The mark-up should also identify all known **EASEMENTS** or other lands of ownership rights. I am also requesting you to provide/prepare a rough cost estimate for relocation of your facilities (per mile basis is acceptable), indicating the impact you anticipate with your facilities.

Please also advise us in writing on your company letterhead if you do not have any existing or planned utility installations within the limits of this job.

In your correspondence to my office, please refer to the FPN and description as listed above. This information will need to be returned by **October 23, 2020**.

Thank you for your cooperation. The Department will make sure the information, which you have furnished, will be considered prior to establishing future corridor(s). Please feel free to contact me should you have any questions regarding the project or need any additional information.

The project file can be found in the link below:

Here's a OneDrive link to [436928-1 Burnt Store Road \(CR 765\) from Van Buren Parkway to Charlotte County Line PD&E Study](#).

If you have any issues opening the file, please feel free to reach out to me at (813)988-1199 or through my email at (wkwong@scalarinc.net).

Kind Regards,

Winnie Kwong



13337 North 56th Street

Tampa, Florida 33617

Ph: (813) 988-1199 Ext. 215

Cell: (561) 568-9676

wkwong@scalarinc.net

This message is for the named person's use only. It may contain confidential, proprietary or legally privileged information. No confidentiality or privilege is waived or lost by any

mistransmission. If you receive this message in error, please immediately delete it and all copies of it from your system, destroy any hard copies of it and notify the sender. You must not, directly or indirectly, use, disclose, distribute, print, or copy any part of this message if you are not the intended recipient.



et Counted ow

Please note Florida has a very broad public records law. Most written communications to or from County employees and officials regarding County business are public records available to the public and media upon request. Your email communication may be subject to public disclosure.

Under Florida law email addresses are public records. If you do not want your email address released in response to a public records request do not send electronic mail to this entity. Instead contact this office by phone or in writing.

BROADSTAR/MDU PRO

From: [russ_b](#)
To: [Winnie Kwong](#)
Subject: Re: 436928-1: Burnt Store Rd PD&E Study- Initial UAO coordination
Date: Monday, October 12, 2020 :10: 4 PM
Attachments: [image001.png](#)

Hi Winnie,
Please accept this response that MDU Pro does not have facilities in your proposed area.

Russell Bell

Vice President of Engineering



www.BroadStar.com

Providing Quality CABLE, INTERNET & PHONE to the Multi-Housing Community for over 25 Years

On Mon, Oct 12, 2020 at 1:42 PM Winnie Kwong, <wk Wong@scalarinc.net> wrote:

FPN: 436928-1-22-01

Description: Burnt Store Road (CR 765) from Van Buren Parkway to Charlotte County Line PD&E Study

County: Lee

Hi Russel,

This is follow-up email to the call from earlier.

Please take a look at the plans below, if you do not have any facilities within the project limit,

please send us either a letter of no facilities or a letter of no conflict.

Project file: [436928-1 Burnt Store Road \(CR 765\) from Van Buren Parkway to Charlotte County Line PD&E Study](#).

Let me know if you have any questions in regards to the plans and thank you for your help!

Kind Regards,

Winnie Kwong, E.I.



13337 North 56th Street

Tampa, Florida 33617

Ph: (813) 988-1199 Ext. 215

Cell: (561) 568-9676

wk Wong@scalarinc.net

From: Winnie Kwong,
Sent: Thursday, September 24, 2020 1:50 PM
To: russb@broadstar.com
Subject: 436928-1: Burnt Store Rd PD&E Study- Initial UAO coordination

FPN: 436928-1-22-01

Description: Burnt Store Road (CR 765) from Van Buren Parkway to Charlotte County Line PD&E Study

County: Lee

Hi Russel,

I'm aware that you do not have any facilities in within the proposed project location and that you only have facilities in Burnt Store Marina. Can you please send me a letter of no facilities if that is the case?

Project file: [436928-1 Burnt Store Road \(CR 765\) from Van Buren Parkway to Charlotte County Line PD&E Study.](#)

Kind Regards,

Winnie Kwong



13337 North 56th Street

Tampa, Florida 33617

Ph: (813) 988-1199 Ext. 215

Cell: (561) 568-9676

wk Wong@scalarinc.net

This message is for the named person's use only. It may contain confidential, proprietary or legally privileged information. No confidentiality or privilege is waived or lost by any mistransmission. If you receive this message in error, please immediately delete it and all copies of it from your system, destroy any hard copies of it and notify the sender. You must not, directly or indirectly, use, disclose, distribute, print, or copy any part of this message if you are not the intended recipient.

APPENDIX C
PREFERRED ALTERNATIVE CONCEPT PLANS

1/16/2023 3:31:24 PM USER: mwilson
P:\2019\SP19D1000 Burnt Store Rd. PD&E\43692812201\roadway\PLANRD01.dgn



LEGEND:

(XX)	POND SITE NUMBER	[Yellow Box]	COUNTY CONSERVATION LAND
[Dashed Line]	EXISTING R/W	[Red Box]	STATE CONSERVATION LAND
[Line with Manholes]	DRAINAGE PIPE	[Green Box]	CITY/COUNTY OWNED PARCEL

REVISIONS			
DATE	DESCRIPTION	DATE	DESCRIPTION



ENGINEER OF RECORD
ANIRUDDHA S. GOTMARE, P.E.
P.E. LICENSE NUMBER 54801
SCALAR CONSULTING GROUP INC.
5713 CORPORATE WAY
WEST PALM BEACH, FL 33407

STATE OF FLORIDA DEPARTMENT OF TRANSPORTATION		
ROAD NO.	COUNTY	FINANCIAL PROJECT ID
CR 765	LEE	436928-1-22-01

**URBAN ALTERNATIVE
WITH PIPED OFF-SITE
DRAINAGE**

**SHEET
NO.
1**

THE OFFICIAL RECORD OF THIS SHEET IS THE ELECTRONIC FILE DIGITALLY SIGNED AND SEALED UNDER RULE 61G15-23.004, F.A.C.

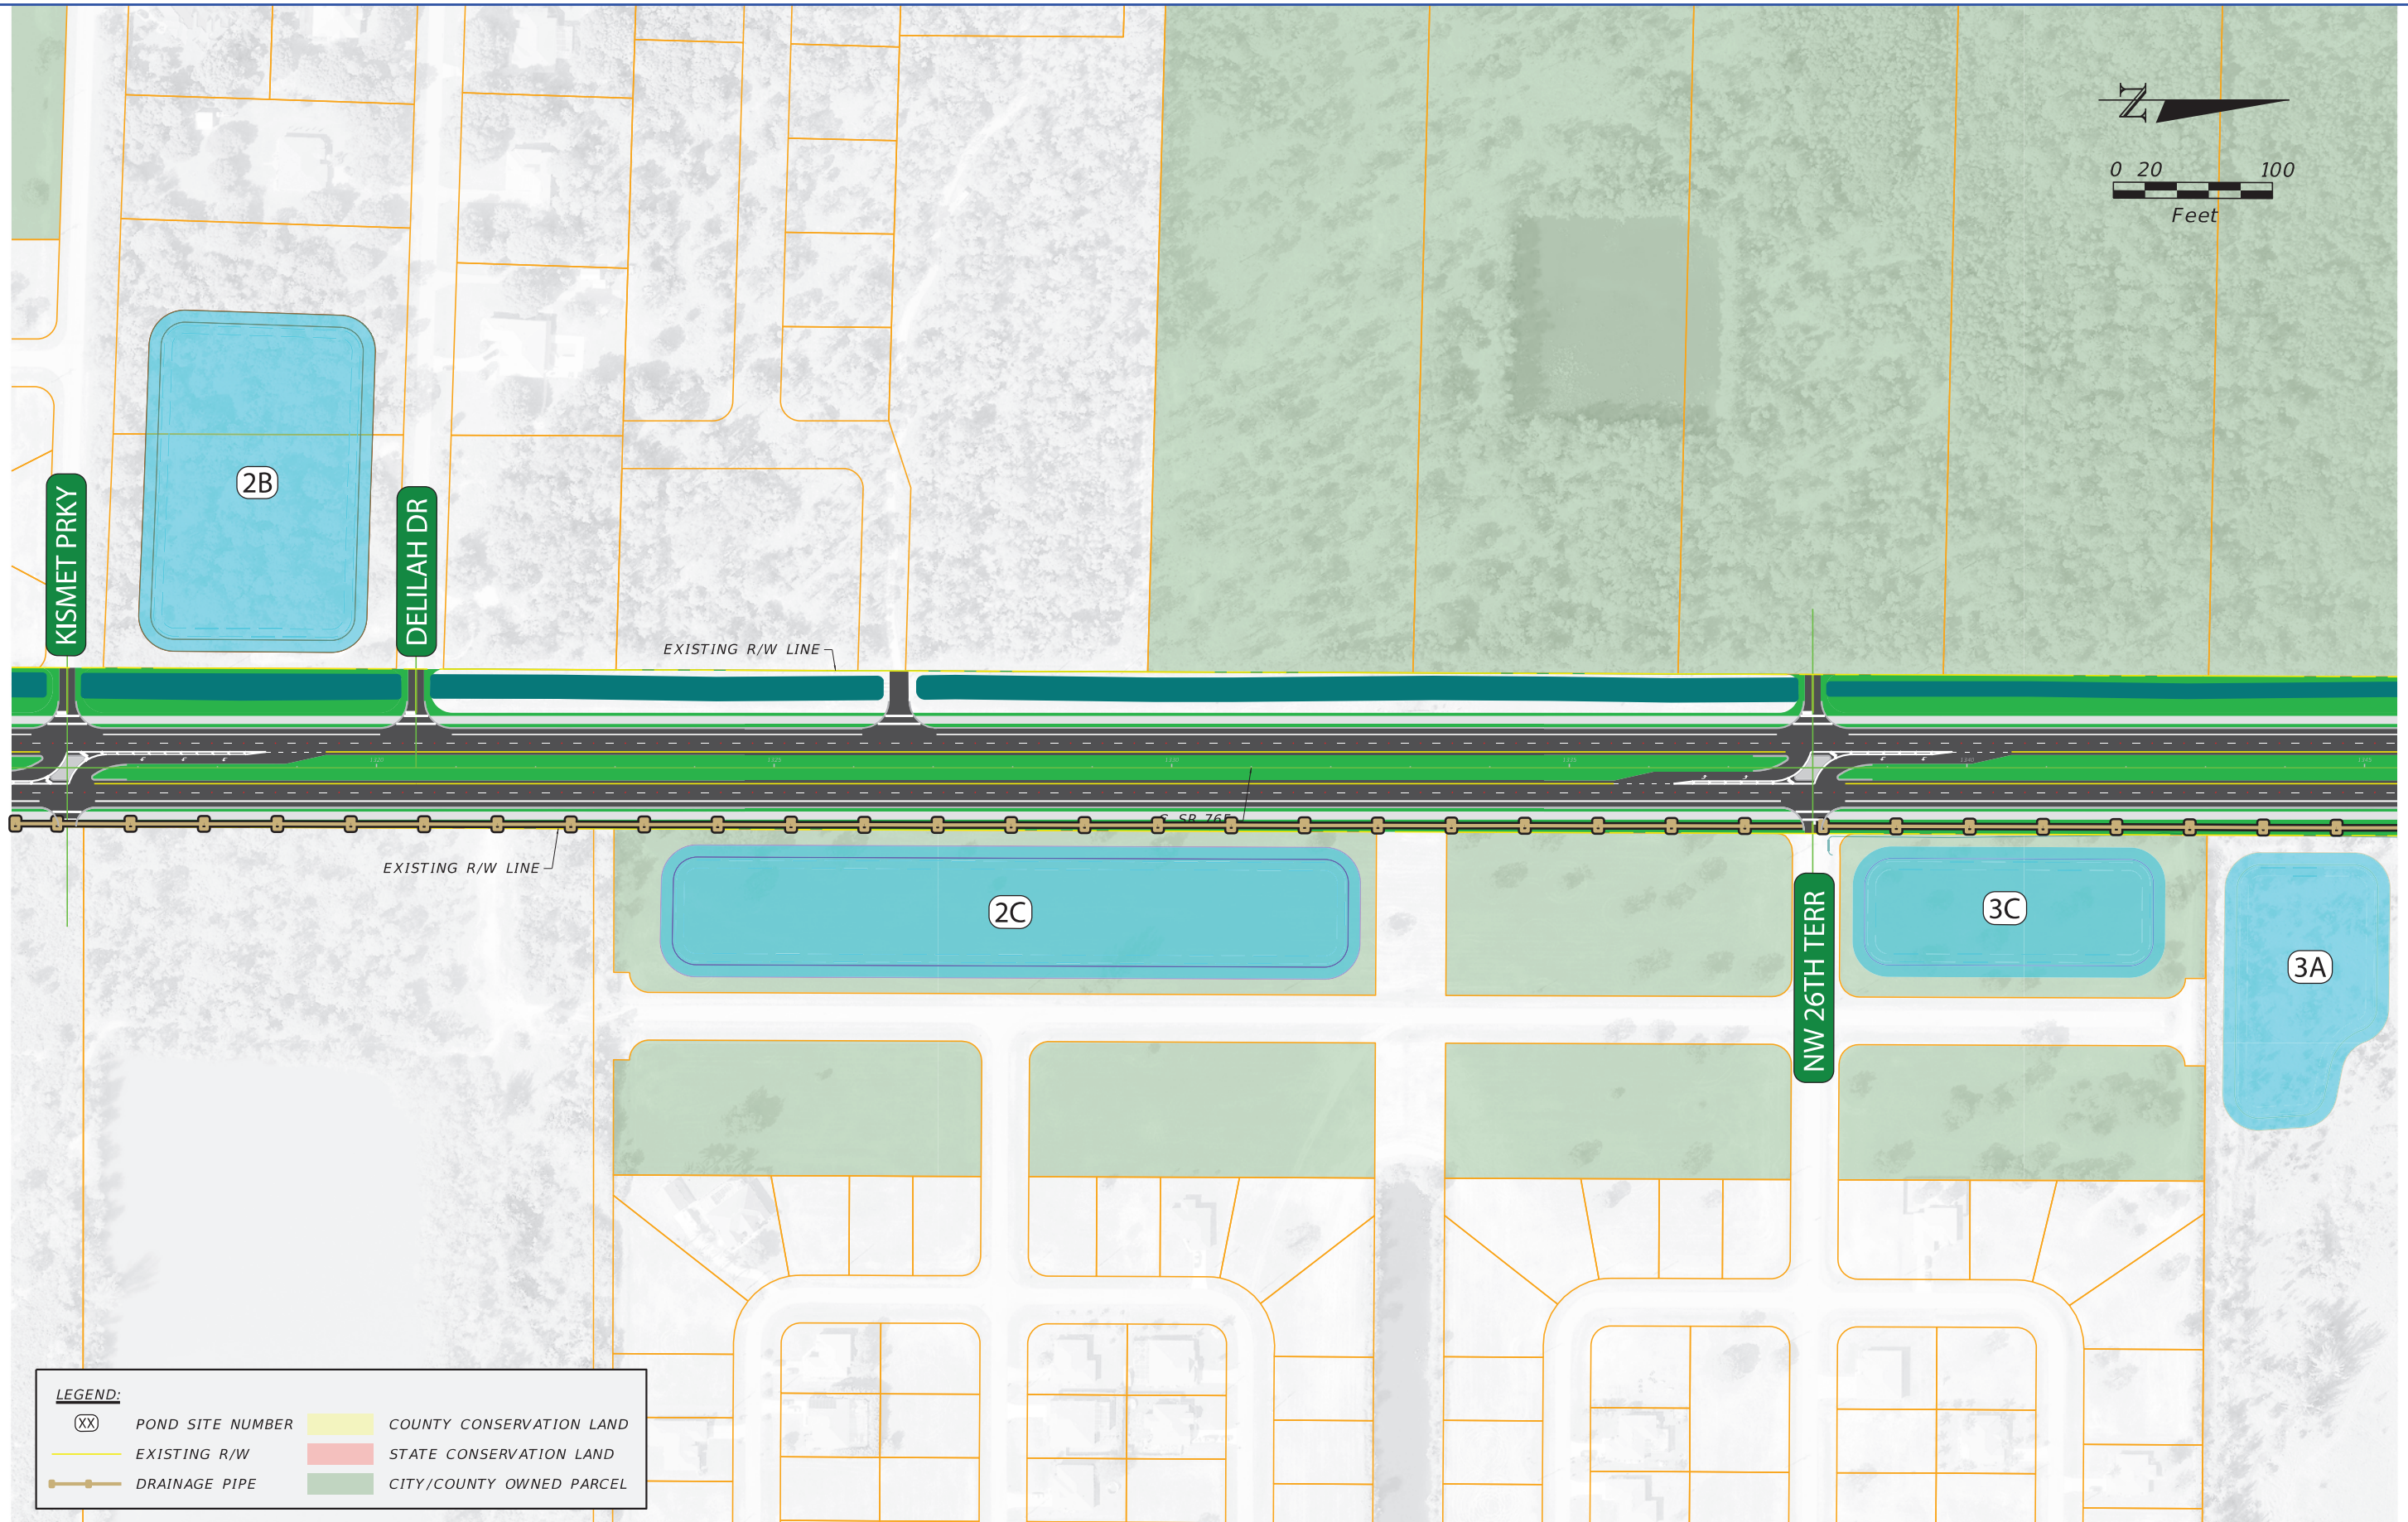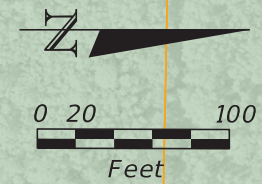




LEGEND:

(XX)	POND SITE NUMBER	[Yellow Box]	COUNTY CONSERVATION LAND
[Orange Line]	EXISTING R/W	[Red Box]	STATE CONSERVATION LAND
[Brown Line]	DRAINAGE PIPE	[Green Box]	CITY/COUNTY OWNED PARCEL

1/16/2023 3:31:42 PM USER: mwilson P:\2019\SP19D1000 Burnt Store Rd. PD&E\43692812201\roadway\PLANRD01.dgn

REVISIONS				ENGINEER OF RECORD		STATE OF FLORIDA DEPARTMENT OF TRANSPORTATION			URBAN ALTERNATIVE WITH PIPED OFF-SITE DRAINAGE	SHEET NO. 2
DATE	DESCRIPTION	DATE	DESCRIPTION			ROAD NO.	COUNTY	FINANCIAL PROJECT ID		
				ANIRUDDHA S. GOTMARE, P.E. P.E. LICENSE NUMBER 54801 SCALAR CONSULTING GROUP INC. 5713 CORPORATE WAY WEST PALM BEACH, FL 33407		CR 765	LEE	436928-1-22-01		

THE OFFICIAL RECORD OF THIS SHEET IS THE ELECTRONIC FILE DIGITALLY SIGNED AND SEALED UNDER RULE 61G15-23.004, F.A.C.

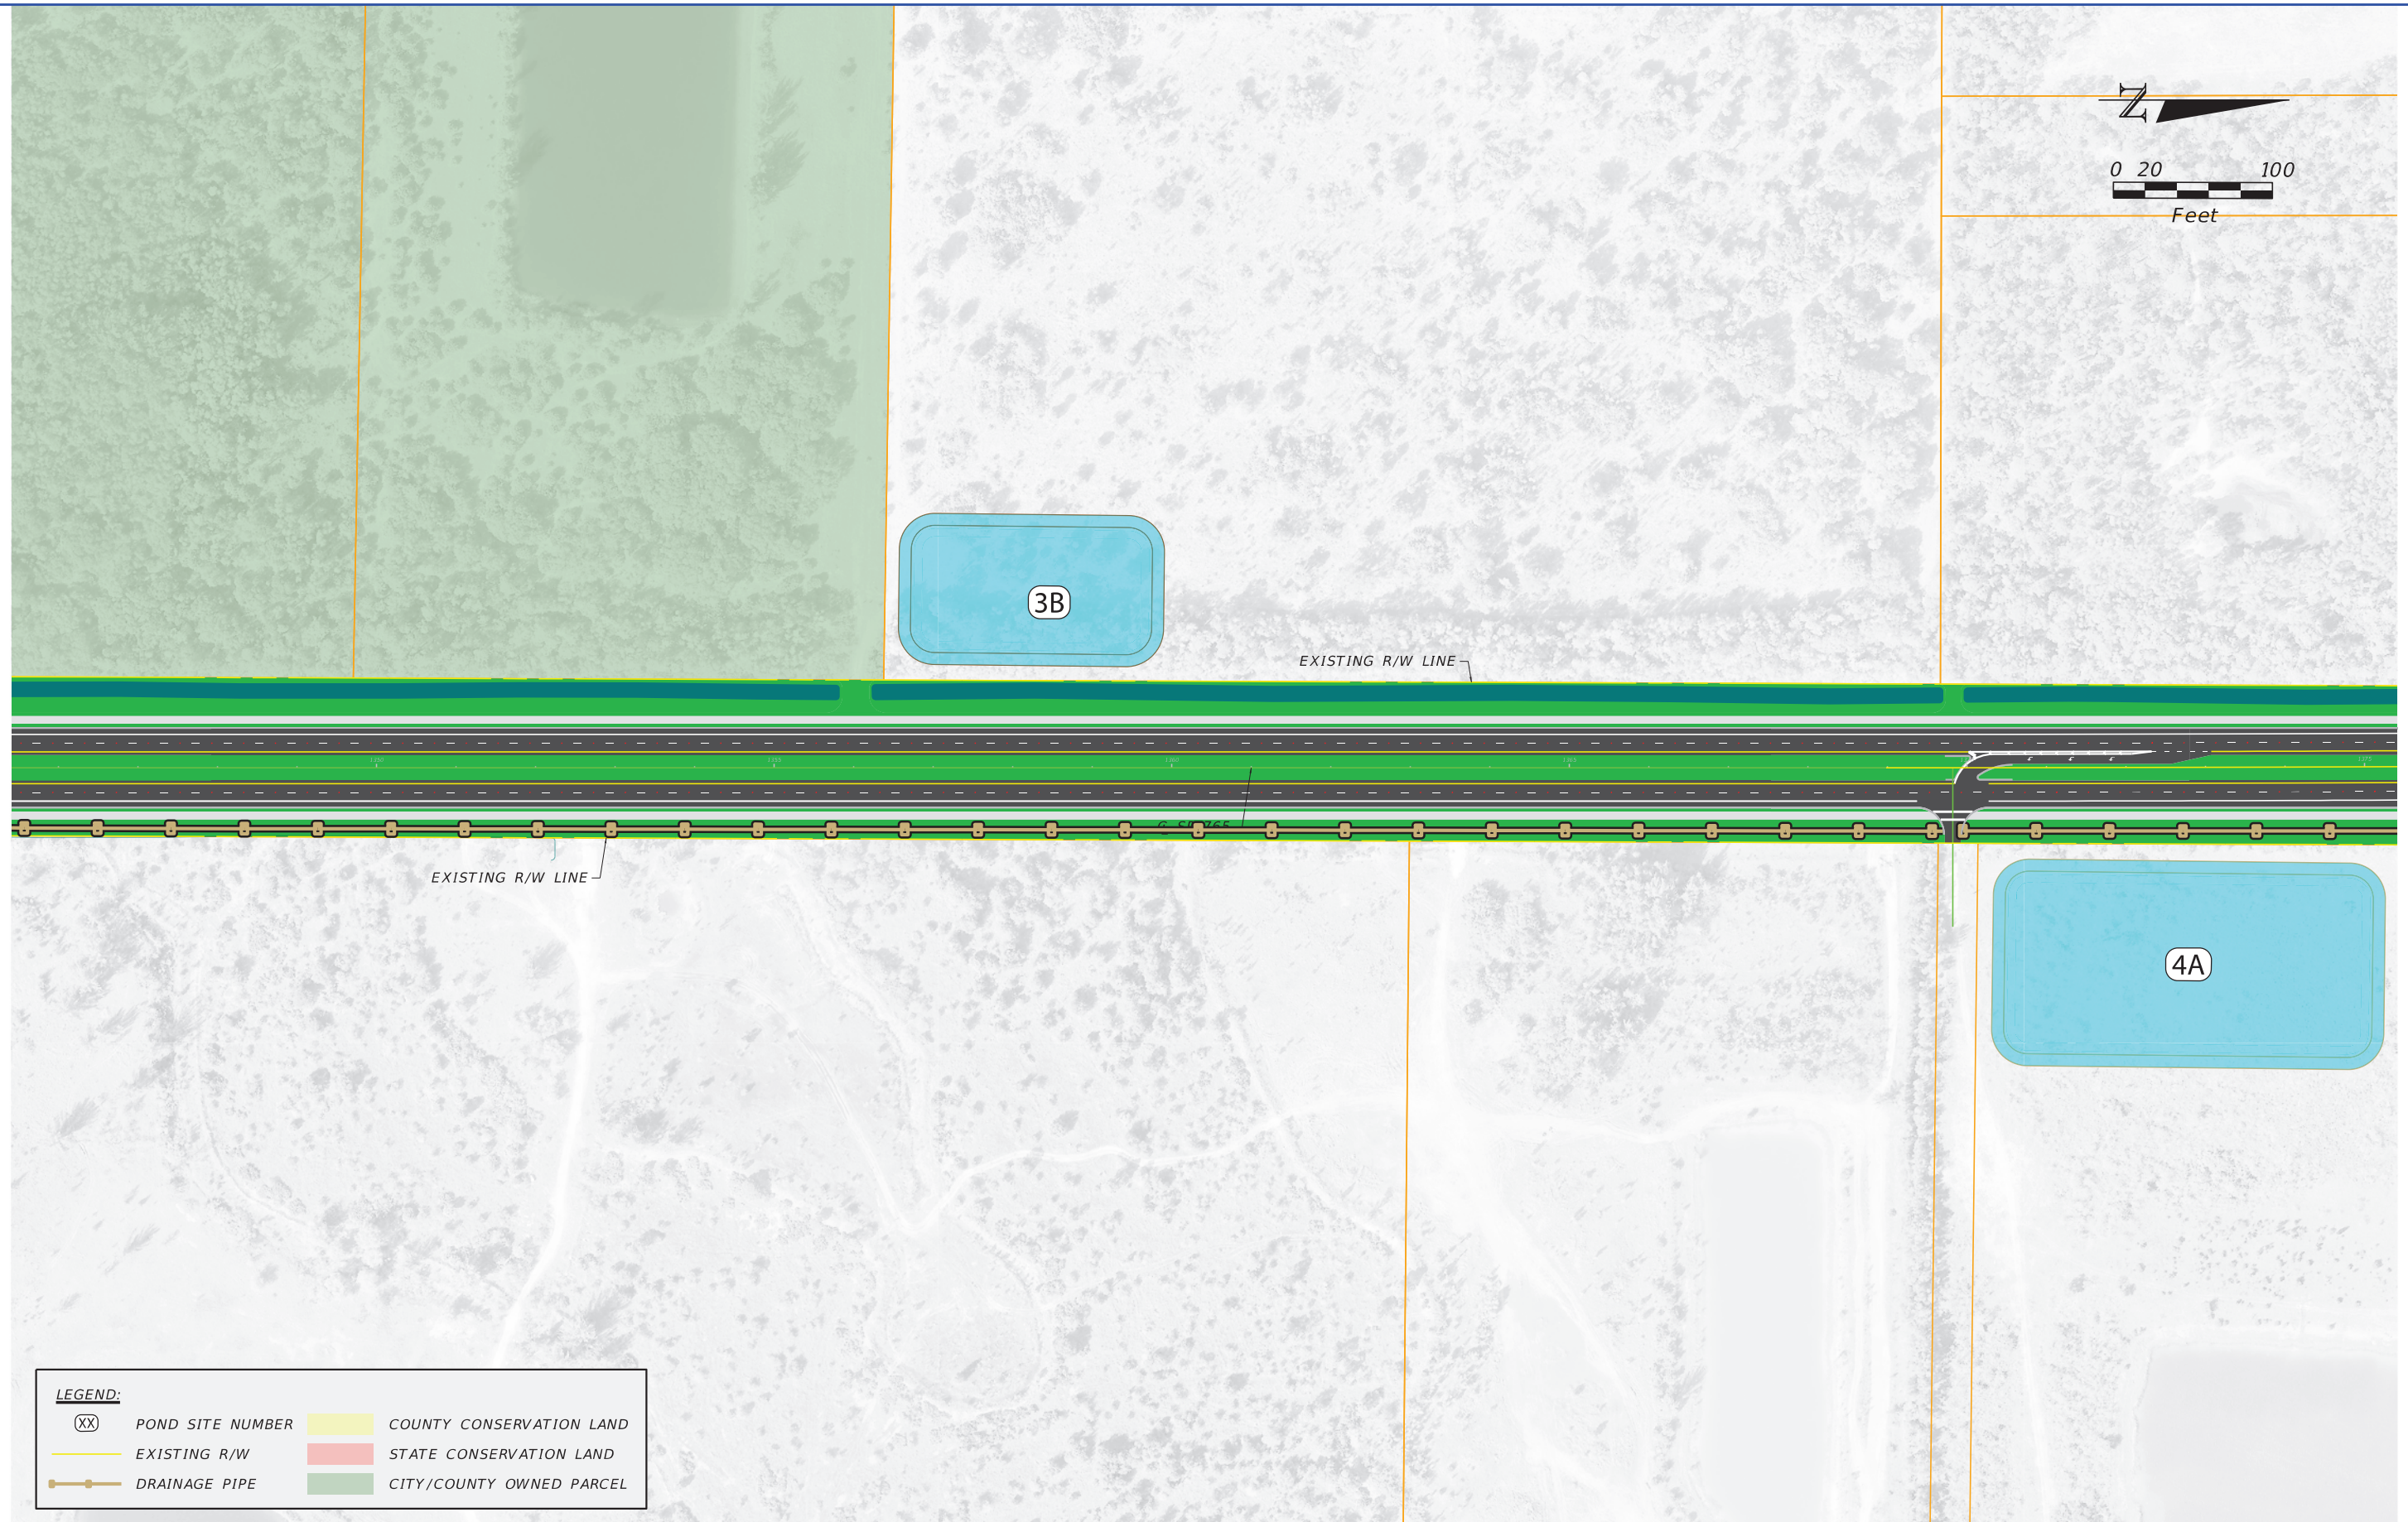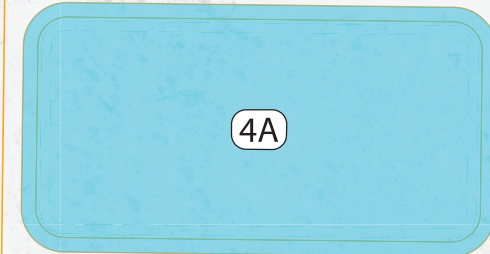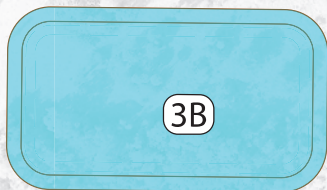


LEGEND:

XX	POND SITE NUMBER		COUNTY CONSERVATION LAND
	EXISTING R/W		STATE CONSERVATION LAND
 	DRAINAGE PIPE		CITY/COUNTY OWNED PARCEL

1/16/2023 3:31:58 PM USER: mwilson P:\2019\SP19D1000 Burnt Store Rd. PD&E\43692812201\roadway\PLAWR001.dgn

THE OFFICIAL RECORD OF THIS SHEET IS THE ELECTRONIC FILE DIGITALLY SIGNED AND SEALED UNDER RULE 61G15-23.004, F.A.C.

REVISIONS				ENGINEER OF RECORD			STATE OF FLORIDA DEPARTMENT OF TRANSPORTATION			URBAN ALTERNATIVE WITH PIPED OFF-SITE DRAINAGE	SHEET NO.
DATE	DESCRIPTION	DATE	DESCRIPTION				ROAD NO.	COUNTY	FINANCIAL PROJECT ID		
				ANIRUDDHA S. GOTMARE, P.E. P.E. LICENSE NUMBER 54801 SCALAR CONSULTING GROUP INC. 5713 CORPORATE WAY WEST PALM BEACH, FL 33407			CR 765	LEE	436928-1-22-01		3

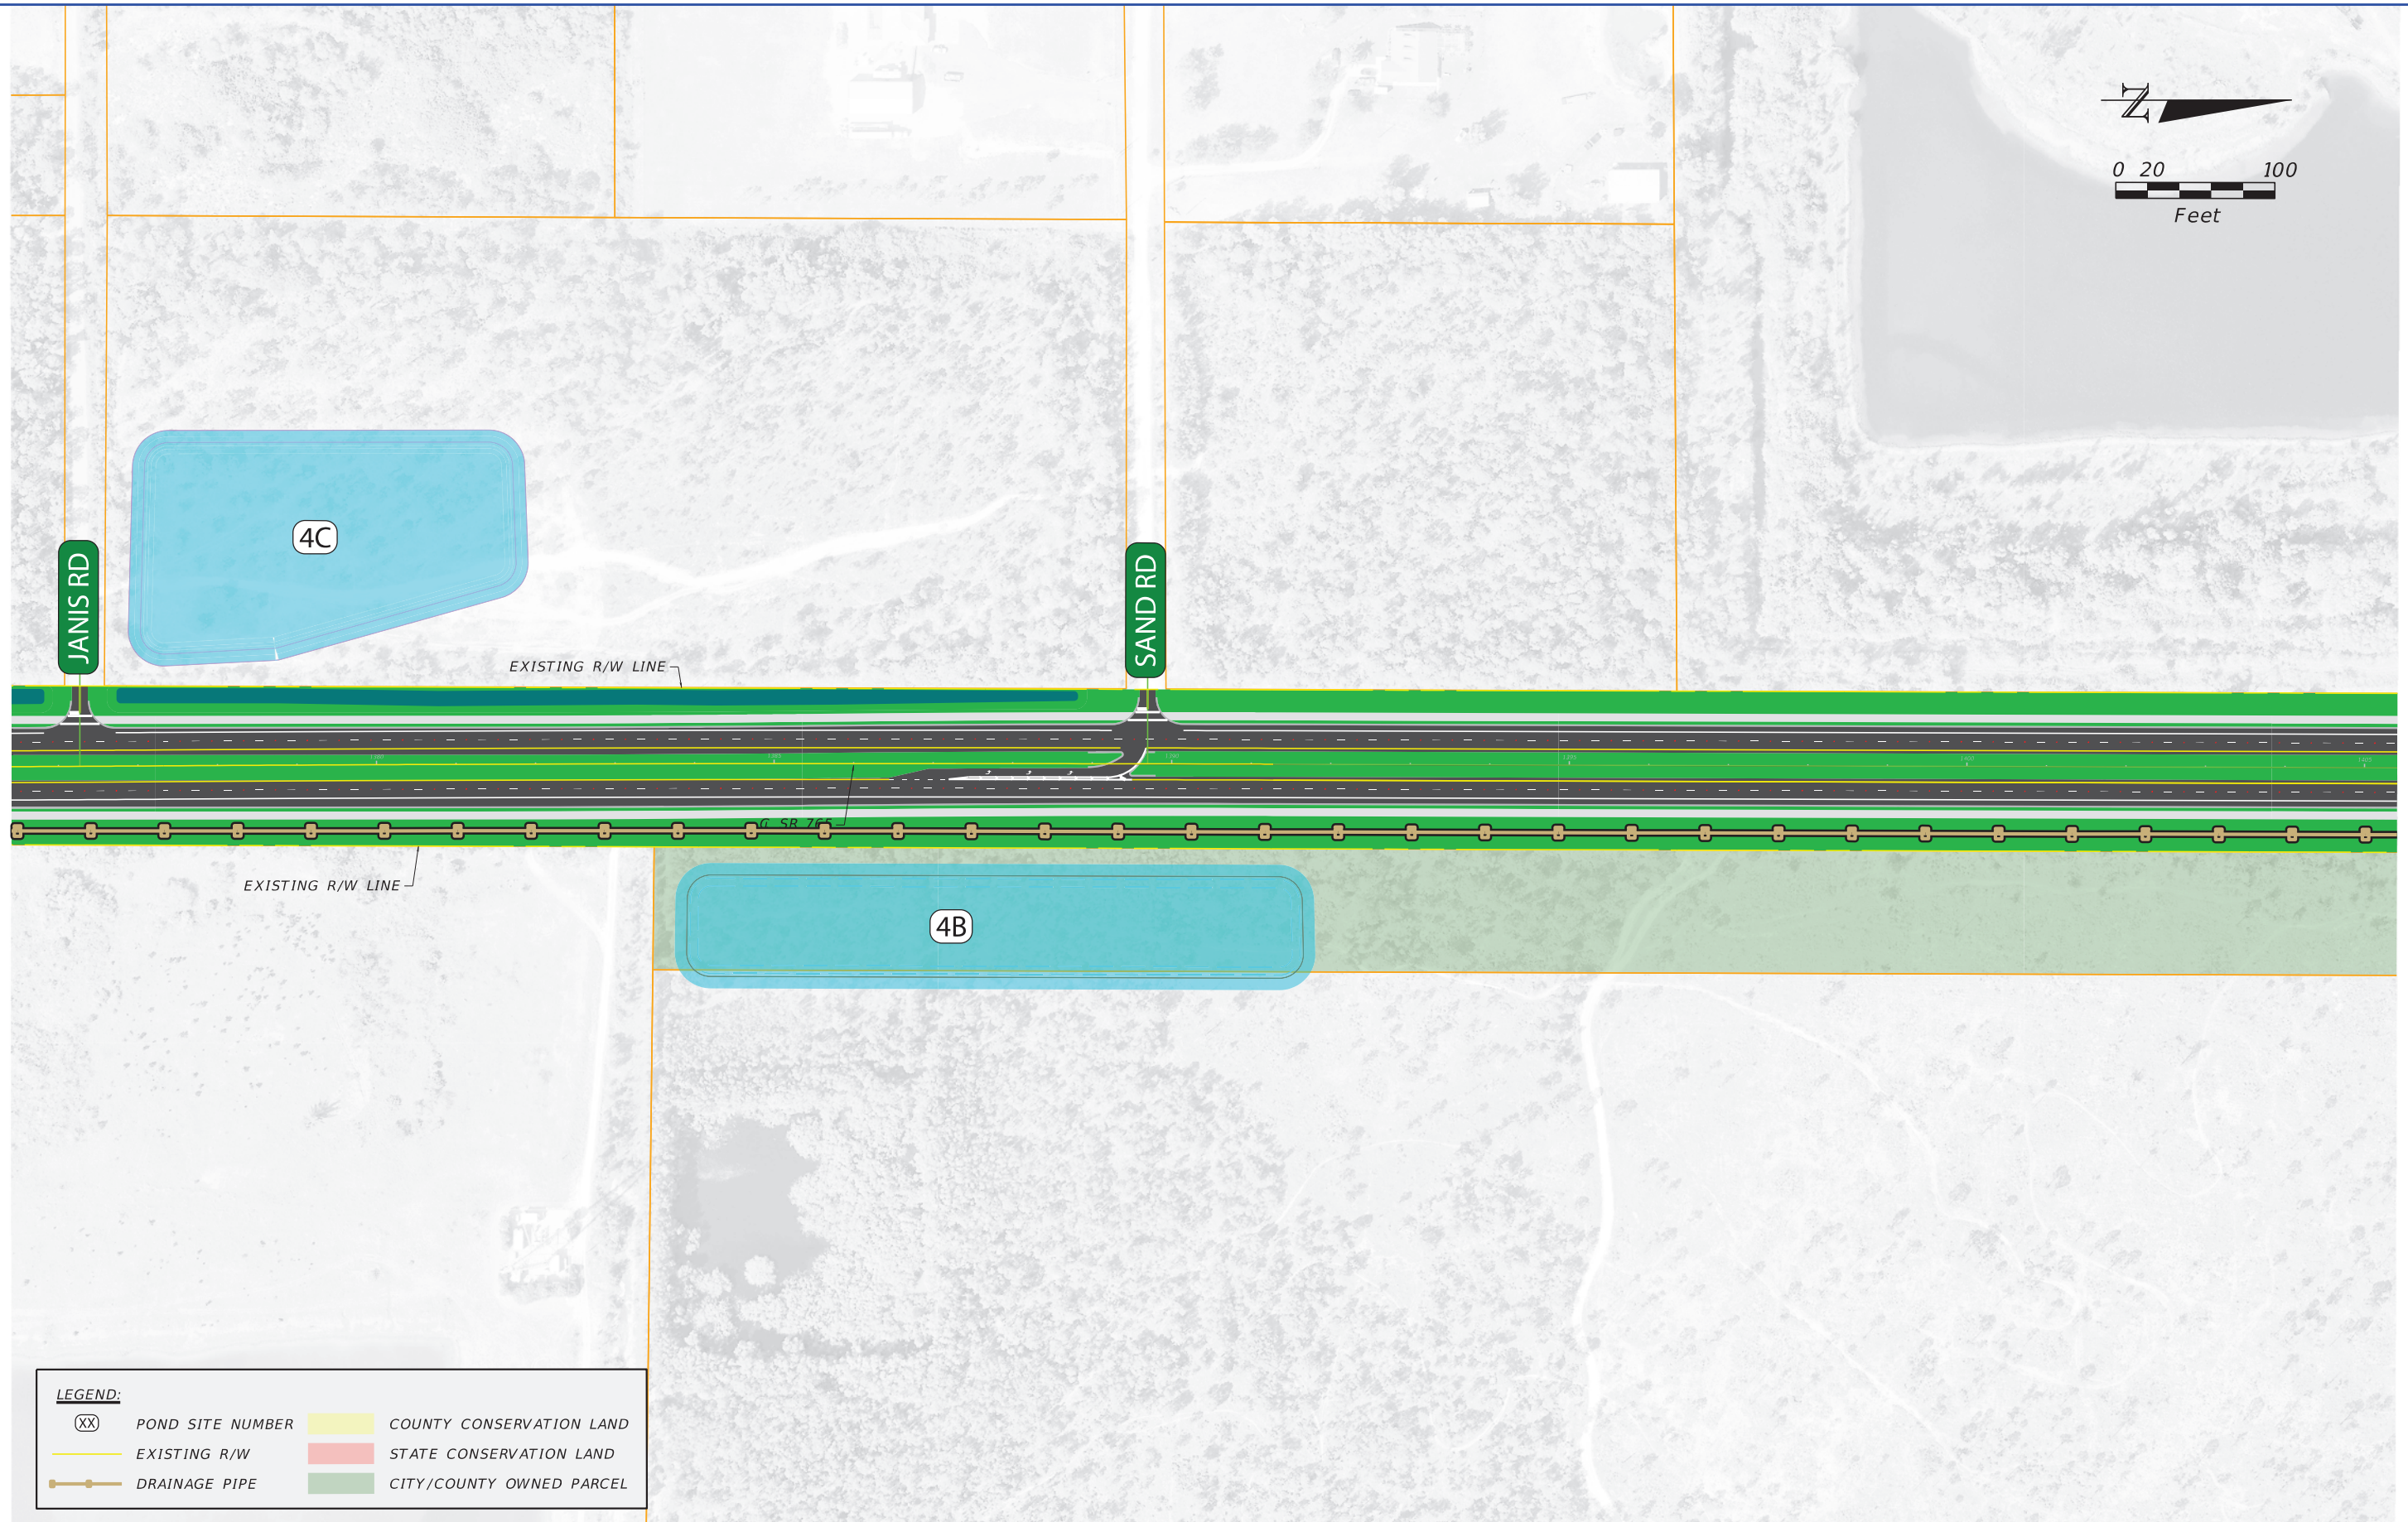

LEGEND:


(XX)	POND SITE NUMBER		COUNTY CONSERVATION LAND
	EXISTING R/W		STATE CONSERVATION LAND
	DRAINAGE PIPE		CITY/COUNTY OWNED PARCEL

1/16/2023 3:32:12 PM USER: mwilson P:\2019\SP19D1000 Burnt Store Rd. PD&E\43692812201\roadway\PLAMRD01.dgn

THE OFFICIAL RECORD OF THIS SHEET IS THE ELECTRONIC FILE DIGITALLY SIGNED AND SEALED UNDER RULE 61G15-23.004, F.A.C.

REVISIONS				ENGINEER OF RECORD			STATE OF FLORIDA DEPARTMENT OF TRANSPORTATION			URBAN ALTERNATIVE WITH PIPED OFF-SITE DRAINAGE	SHEET NO.
DATE	DESCRIPTION	DATE	DESCRIPTION	ANIRUDDHA S. GOTMARE, P.E. P.E. LICENSE NUMBER 54801 SCALAR CONSULTING GROUP INC. 5713 CORPORATE WAY WEST PALM BEACH, FL 33407			ROAD NO.	COUNTY	FINANCIAL PROJECT ID		4
							CR 765	LEE	436928-1-22-01		

1/16/2023 3:32:28 PM USER: mwilson
P:\2019\SP19D1000 Burnt Store Rd. PD&E\43692812201\roadway\PLAMRD01.dgn

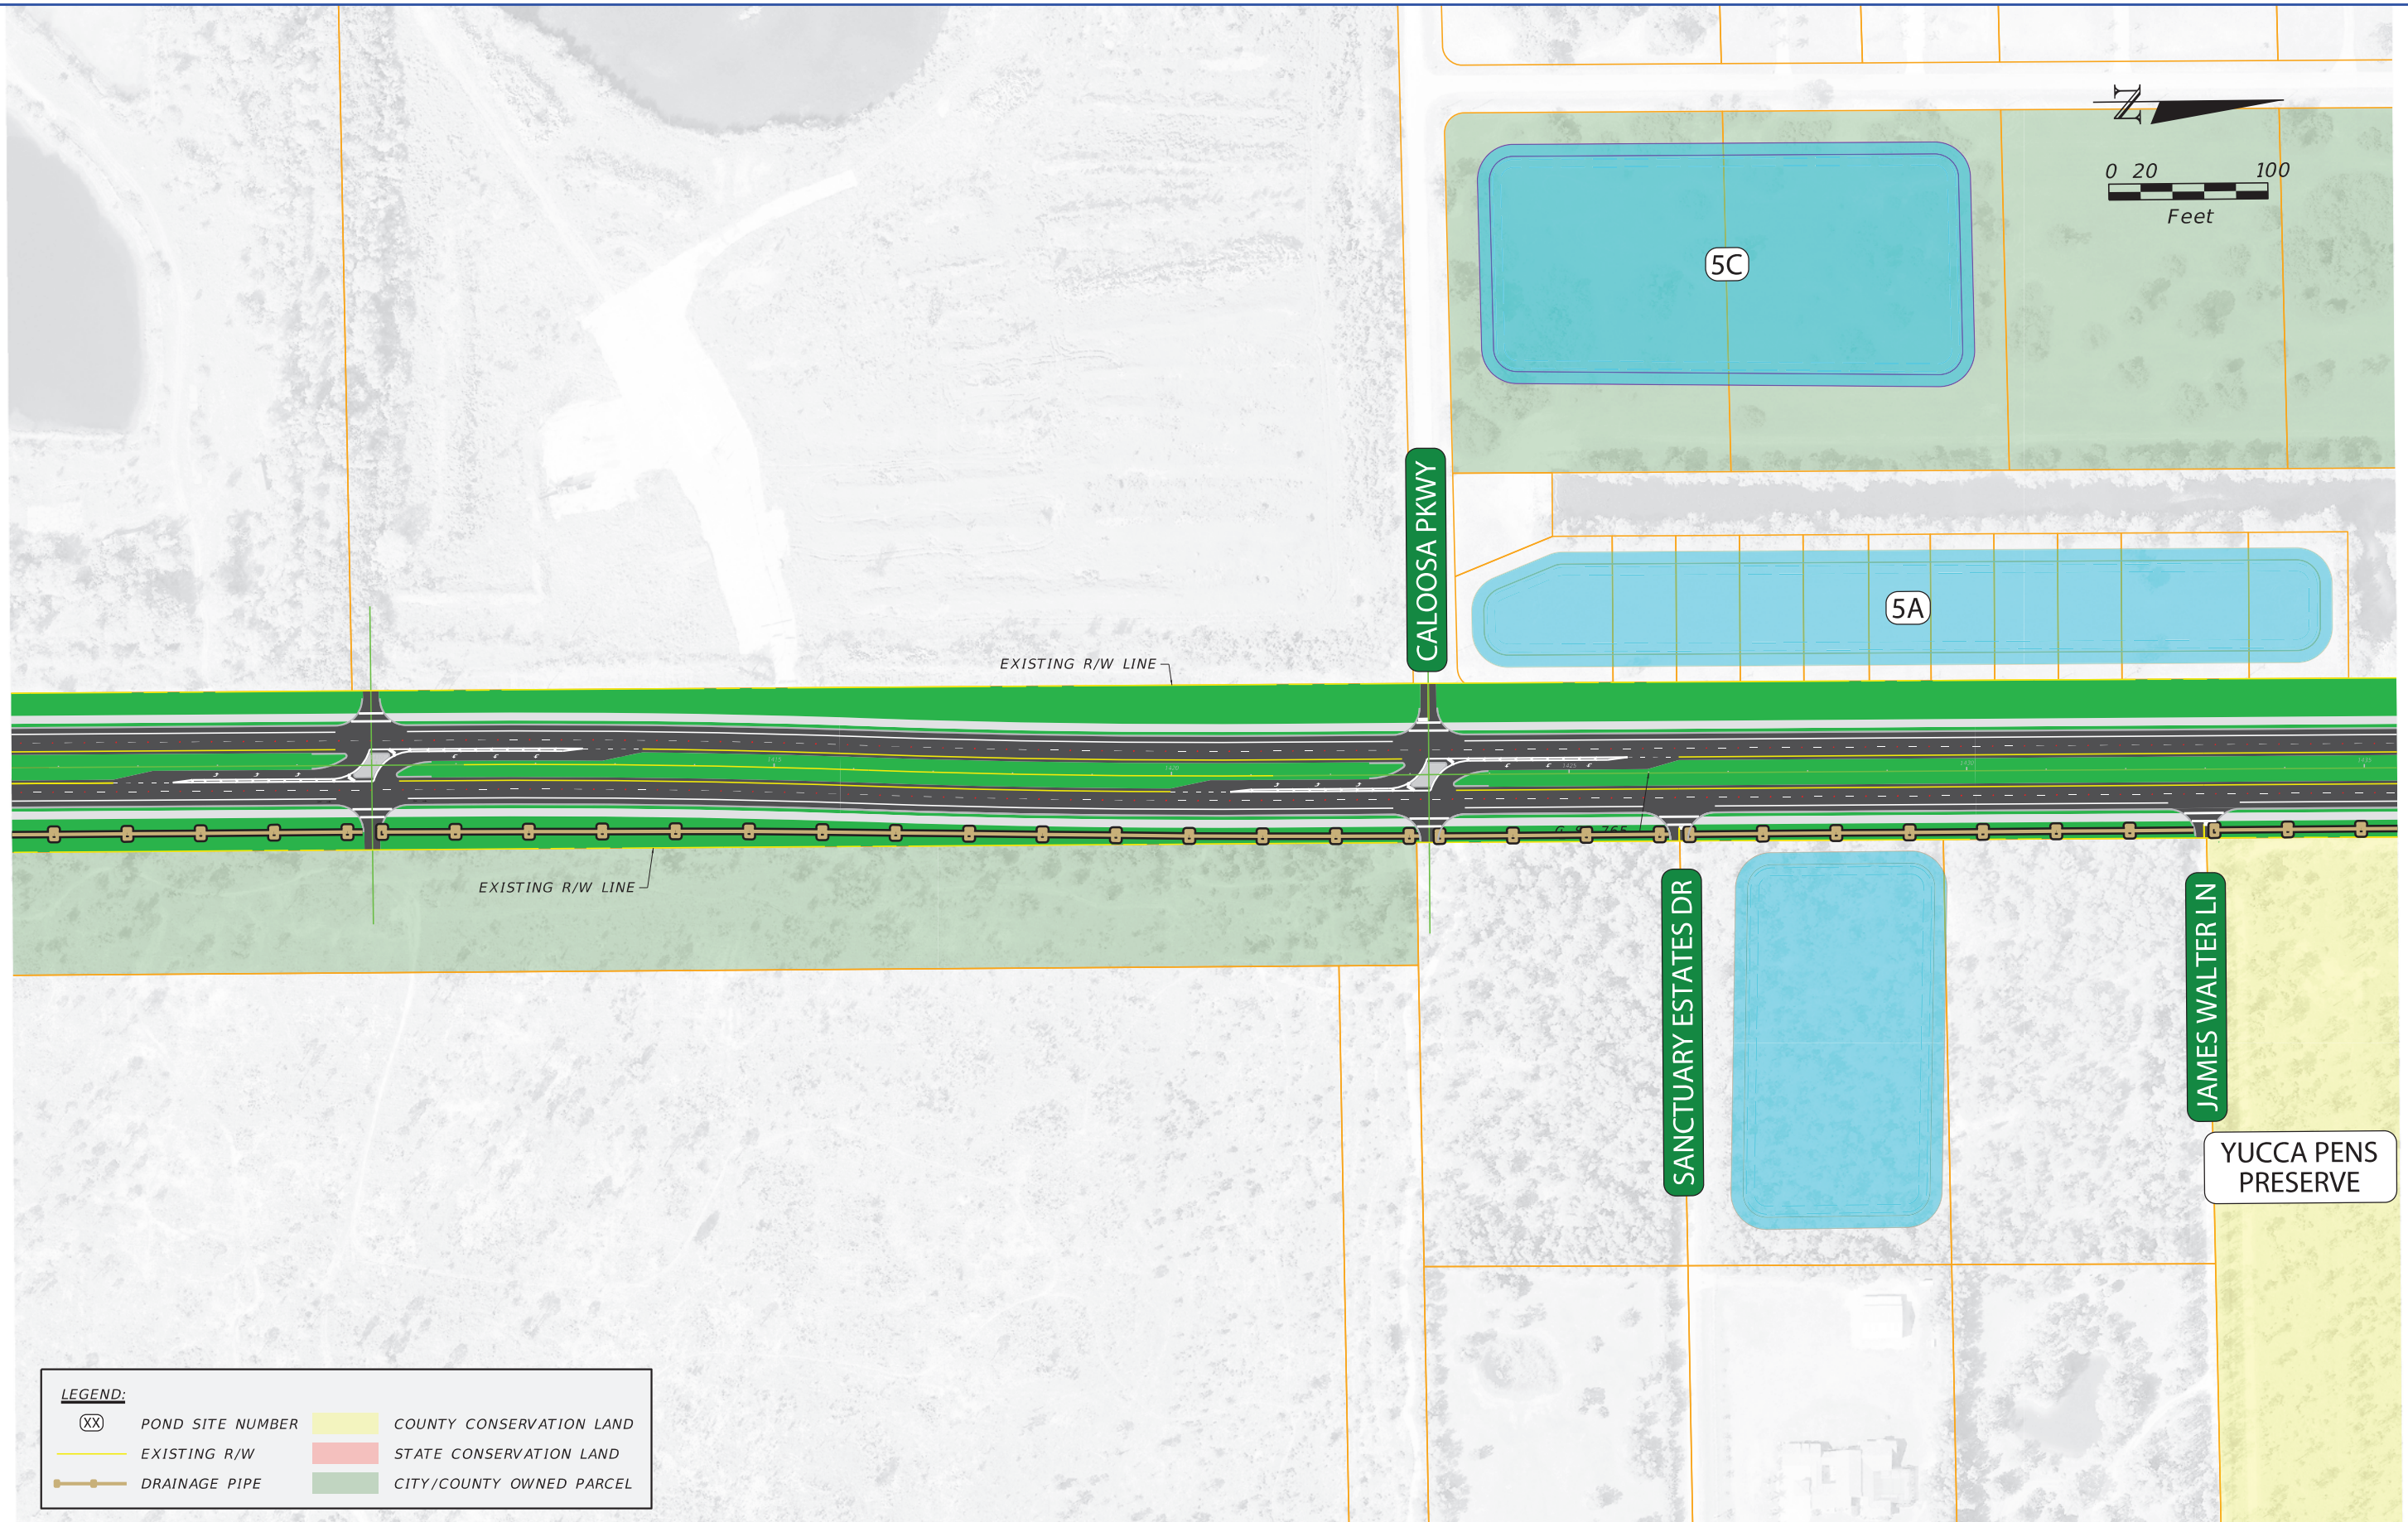

LEGEND:

(XX)	POND SITE NUMBER	(Yellow)	COUNTY CONSERVATION LAND
(Green line)	EXISTING R/W	(Red)	STATE CONSERVATION LAND
(Brown line with squares)	DRAINAGE PIPE	(Green)	CITY/COUNTY OWNED PARCEL

REVISIONS				ENGINEER OF RECORD		STATE OF FLORIDA DEPARTMENT OF TRANSPORTATION			URBAN ALTERNATIVE WITH PIPED OFF-SITE DRAINAGE	SHEET NO. 5
DATE	DESCRIPTION	DATE	DESCRIPTION			ROAD NO.	COUNTY	FINANCIAL PROJECT ID		
				ANIRUDDHA S. GOTMARE, P.E. P.E. LICENSE NUMBER 54801 SCALAR CONSULTING GROUP INC. 5713 CORPORATE WAY WEST PALM BEACH, FL 33407		CR 765	LEE	436928-1-22-01		

THE OFFICIAL RECORD OF THIS SHEET IS THE ELECTRONIC FILE DIGITALLY SIGNED AND SEALED UNDER RULE 61G15-23.004, F.A.C.



CAPE CORAL
FIRE DEPARTMENT
#7

NW 40TH LN

5A

EXISTING R/W LINE

YUCCA PENS
PRESERVE

EXISTING R/W LINE

6C

LEGEND:

(XX)	POND SITE NUMBER		COUNTY CONSERVATION LAND
	EXISTING R/W		STATE CONSERVATION LAND
	DRAINAGE PIPE		CITY/COUNTY OWNED PARCEL


1/16/2023 3:32:44 PM USER: mwilson P:\2019\SP19D1000 Burnt Store Rd. PD&E\43692812201\roadway\PLAWR001.dgn

THE OFFICIAL RECORD OF THIS SHEET IS THE ELECTRONIC FILE DIGITALLY SIGNED AND SEALED UNDER RULE 61G15-23.004, F.A.C.

REVISIONS				ENGINEER OF RECORD		STATE OF FLORIDA DEPARTMENT OF TRANSPORTATION			URBAN ALTERNATIVE WITH PIPED OFF-SITE DRAINAGE	SHEET NO.
DATE	DESCRIPTION	DATE	DESCRIPTION				ROAD NO.	COUNTY		FINANCIAL PROJECT ID
				ANIRUDDHA S. GOTMARE, P.E. P.E. LICENSE NUMBER 54801 SCALAR CONSULTING GROUP INC. 5713 CORPORATE WAY WEST PALM BEACH, FL 33407			CR 765	LEE		436928-1-22-01





MYRIAD LUXURY
MOTORCOACH
RESORT

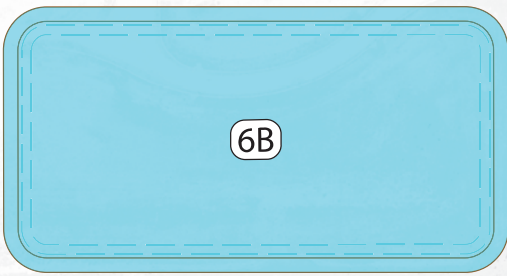

6B

DURDEN PKWY

EXISTING R/W LINE

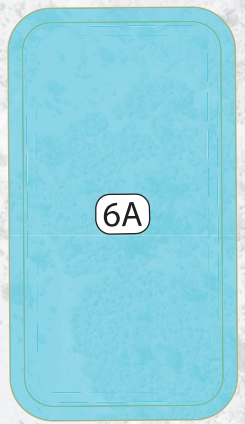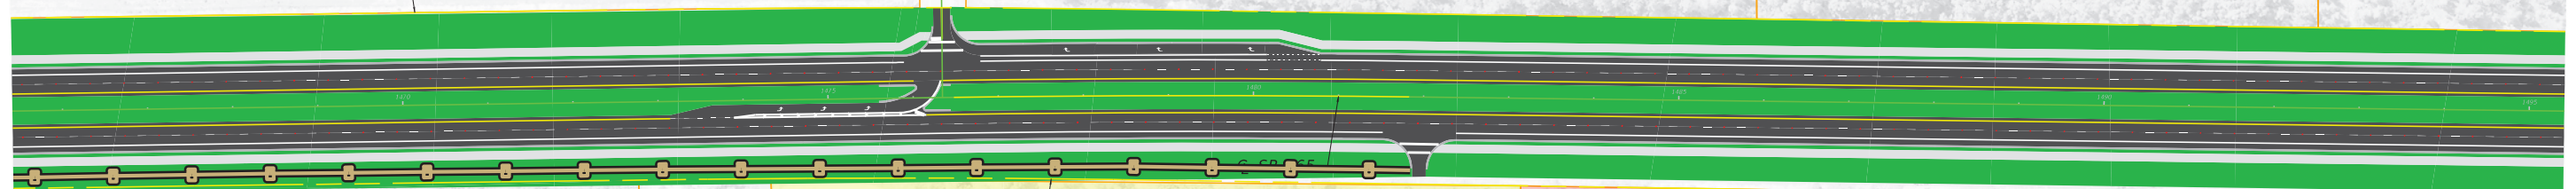

6A

EXISTING R/W LINE

YUCCA PENS
PRESERVE

BABCOCK WEBB/YUCCA PENS
UNIT WMA


LEGEND:

(XX)	POND SITE NUMBER	[Yellow Box]	COUNTY CONSERVATION LAND
[Green Line]	EXISTING R/W	[Red Box]	STATE CONSERVATION LAND
[Brown Line with Squares]	DRAINAGE PIPE	[Green Box]	CITY/COUNTY OWNED PARCEL


1/16/2023 3:32:59 PM USER: mwilson P:\2019\SP19D1000 Burnt Store Rd. PD&E\43692812201\roadway\PLAMRD01.dgn

THE OFFICIAL RECORD OF THIS SHEET IS THE ELECTRONIC FILE DIGITALLY SIGNED AND SEALED UNDER RULE 61G15-23.004, F.A.C.

REVISIONS				ENGINEER OF RECORD			STATE OF FLORIDA DEPARTMENT OF TRANSPORTATION			URBAN ALTERNATIVE WITH PIPED OFF-SITE DRAINAGE	SHEET NO.
DATE	DESCRIPTION	DATE	DESCRIPTION				ROAD NO.	COUNTY	FINANCIAL PROJECT ID		
				ANIRUDDHA S. GOTMARE, P.E. P.E. LICENSE NUMBER 54801 SCALAR CONSULTING GROUP INC. 5713 CORPORATE WAY WEST PALM BEACH, FL 33407			CR 765	LEE	436928-1-22-01		7

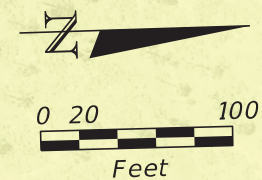


CHARLOTTE HARBOR
BUFFER PRESERVE

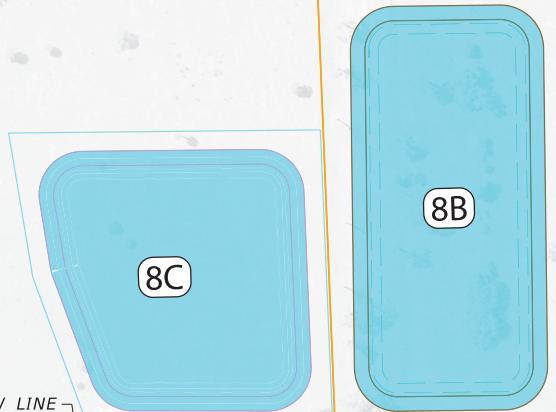

EXISTING R/W LINE

SR 765

EXISTING R/W LINE

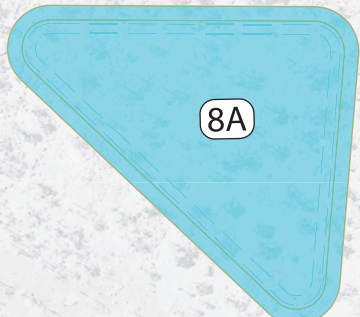

BABCOCK WEBB/YUCCA PENS
UNIT WMA

LEGEND:


(XX)	POND SITE NUMBER	[Yellow Box]	COUNTY CONSERVATION LAND
[Orange Line]	EXISTING R/W	[Red Box]	STATE CONSERVATION LAND
[Green Line]	DRAINAGE PIPE	[Green Box]	CITY/COUNTY OWNED PARCEL

1/16/2023 3:33:15 PM USER: mwilson P:\2019\SP19D1000 Burnt Store Rd. PD&E\43692812201\roadway\PLAWR001.dgn

THE OFFICIAL RECORD OF THIS SHEET IS THE ELECTRONIC FILE DIGITALLY SIGNED AND SEALED UNDER RULE 61G15-23.004, F.A.C.

REVISIONS				ENGINEER OF RECORD		STATE OF FLORIDA DEPARTMENT OF TRANSPORTATION			URBAN ALTERNATIVE WITH PIPED OFF-SITE DRAINAGE	SHEET NO.
DATE	DESCRIPTION	DATE	DESCRIPTION	ANIRUDDHA S. GOTMARE, P.E. P.E. LICENSE NUMBER 54801 SCALAR CONSULTING GROUP INC. 5713 CORPORATE WAY WEST PALM BEACH, FL 33407		ROAD NO.	COUNTY	FINANCIAL PROJECT ID		8
						CR 765	LEE	436928-1-22-01		

1/16/2023 3:33:30 PM USER: mwilson
 P:\2019\SP19D1000 Burnt Store Rd. PD&E\43692812201\roadway\PLAMRD01.dgn

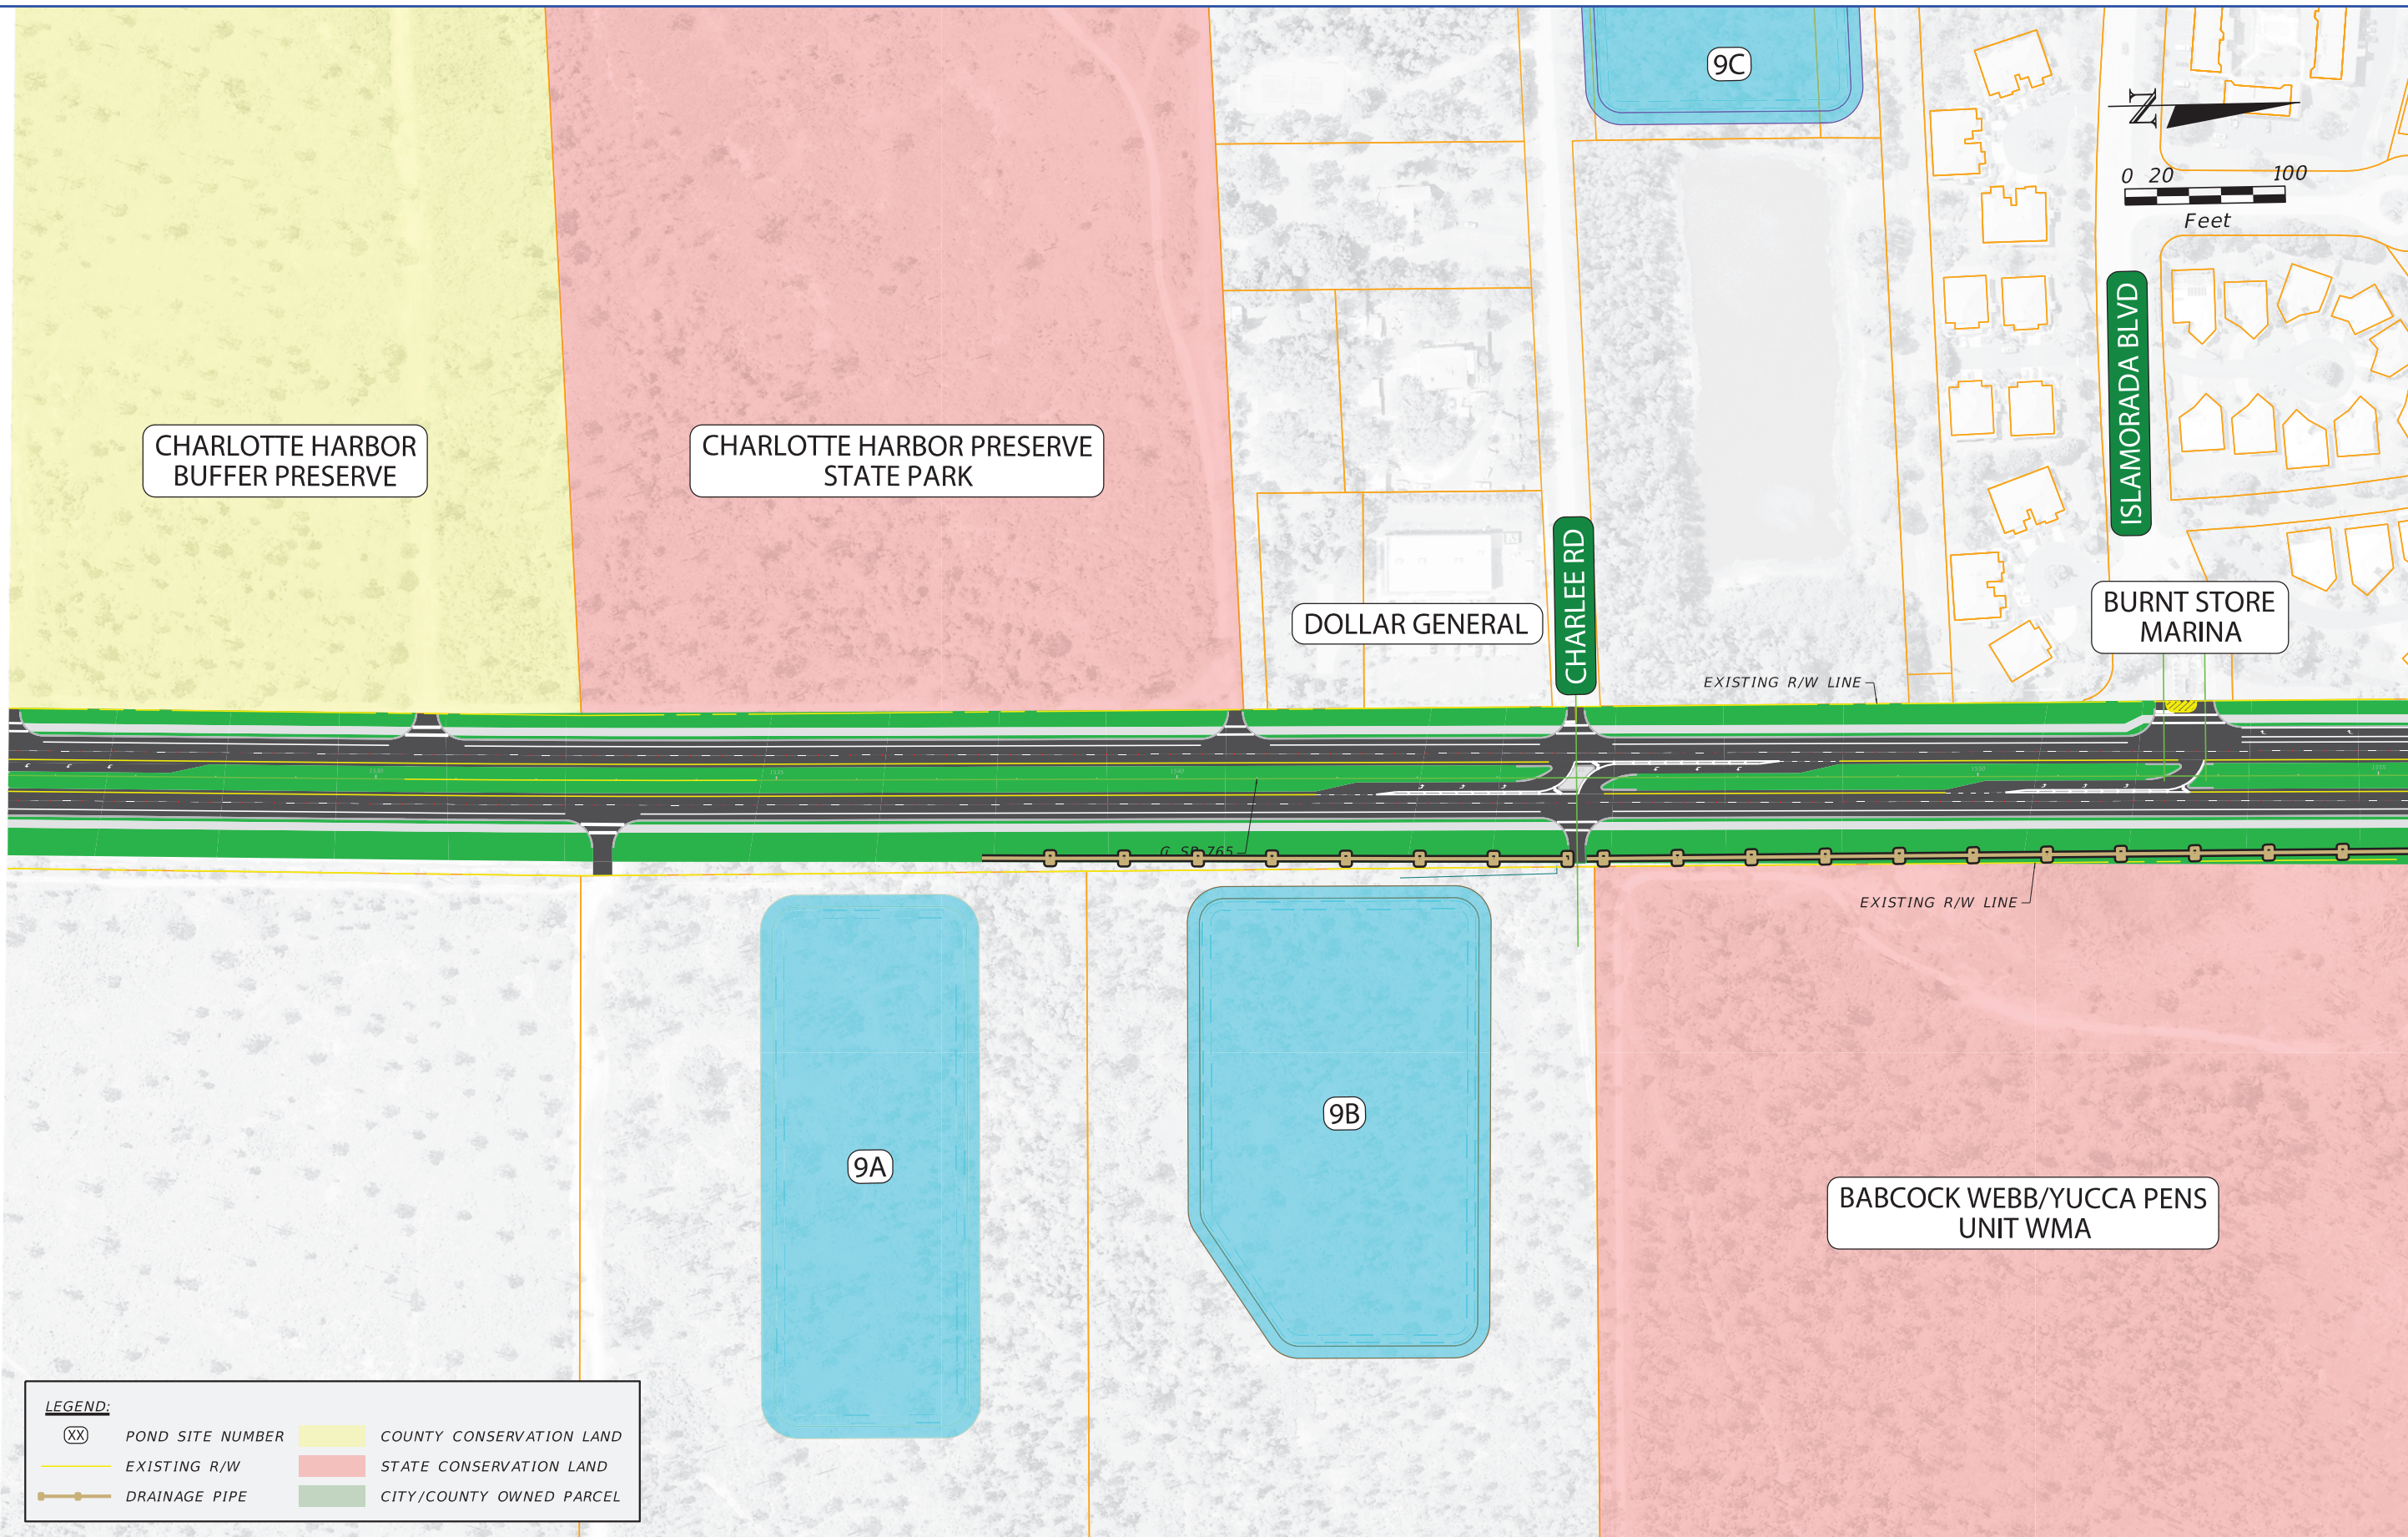


LEGEND:

(XX)	POND SITE NUMBER	[Yellow Box]	COUNTY CONSERVATION LAND
[Green Line]	EXISTING R/W	[Red Box]	STATE CONSERVATION LAND
[Brown Line]	DRAINAGE PIPE	[Green Box]	CITY/COUNTY OWNED PARCEL

REVISIONS				ENGINEER OF RECORD			STATE OF FLORIDA DEPARTMENT OF TRANSPORTATION			URBAN ALTERNATIVE WITH PIPED OFF-SITE DRAINAGE	SHEET NO. 9
DATE	DESCRIPTION	DATE	DESCRIPTION				ROAD NO.	COUNTY	FINANCIAL PROJECT ID		
				ANIRUDDHA S. GOTMARE, P.E. P.E. LICENSE NUMBER 54801 SCALAR CONSULTING GROUP INC. 5713 CORPORATE WAY WEST PALM BEACH, FL 33407			CR 765	LEE	436928-1-22-01		

THE OFFICIAL RECORD OF THIS SHEET IS THE ELECTRONIC FILE DIGITALLY SIGNED AND SEALED UNDER RULE 61G15-23.004, F.A.C.

1/16/2023 3:33:46 PM USER: mwilson
P:\2019\SP19D1000 Burnt Store Rd. PD&E\43692812201\roadway\PLAMRD01.dgn

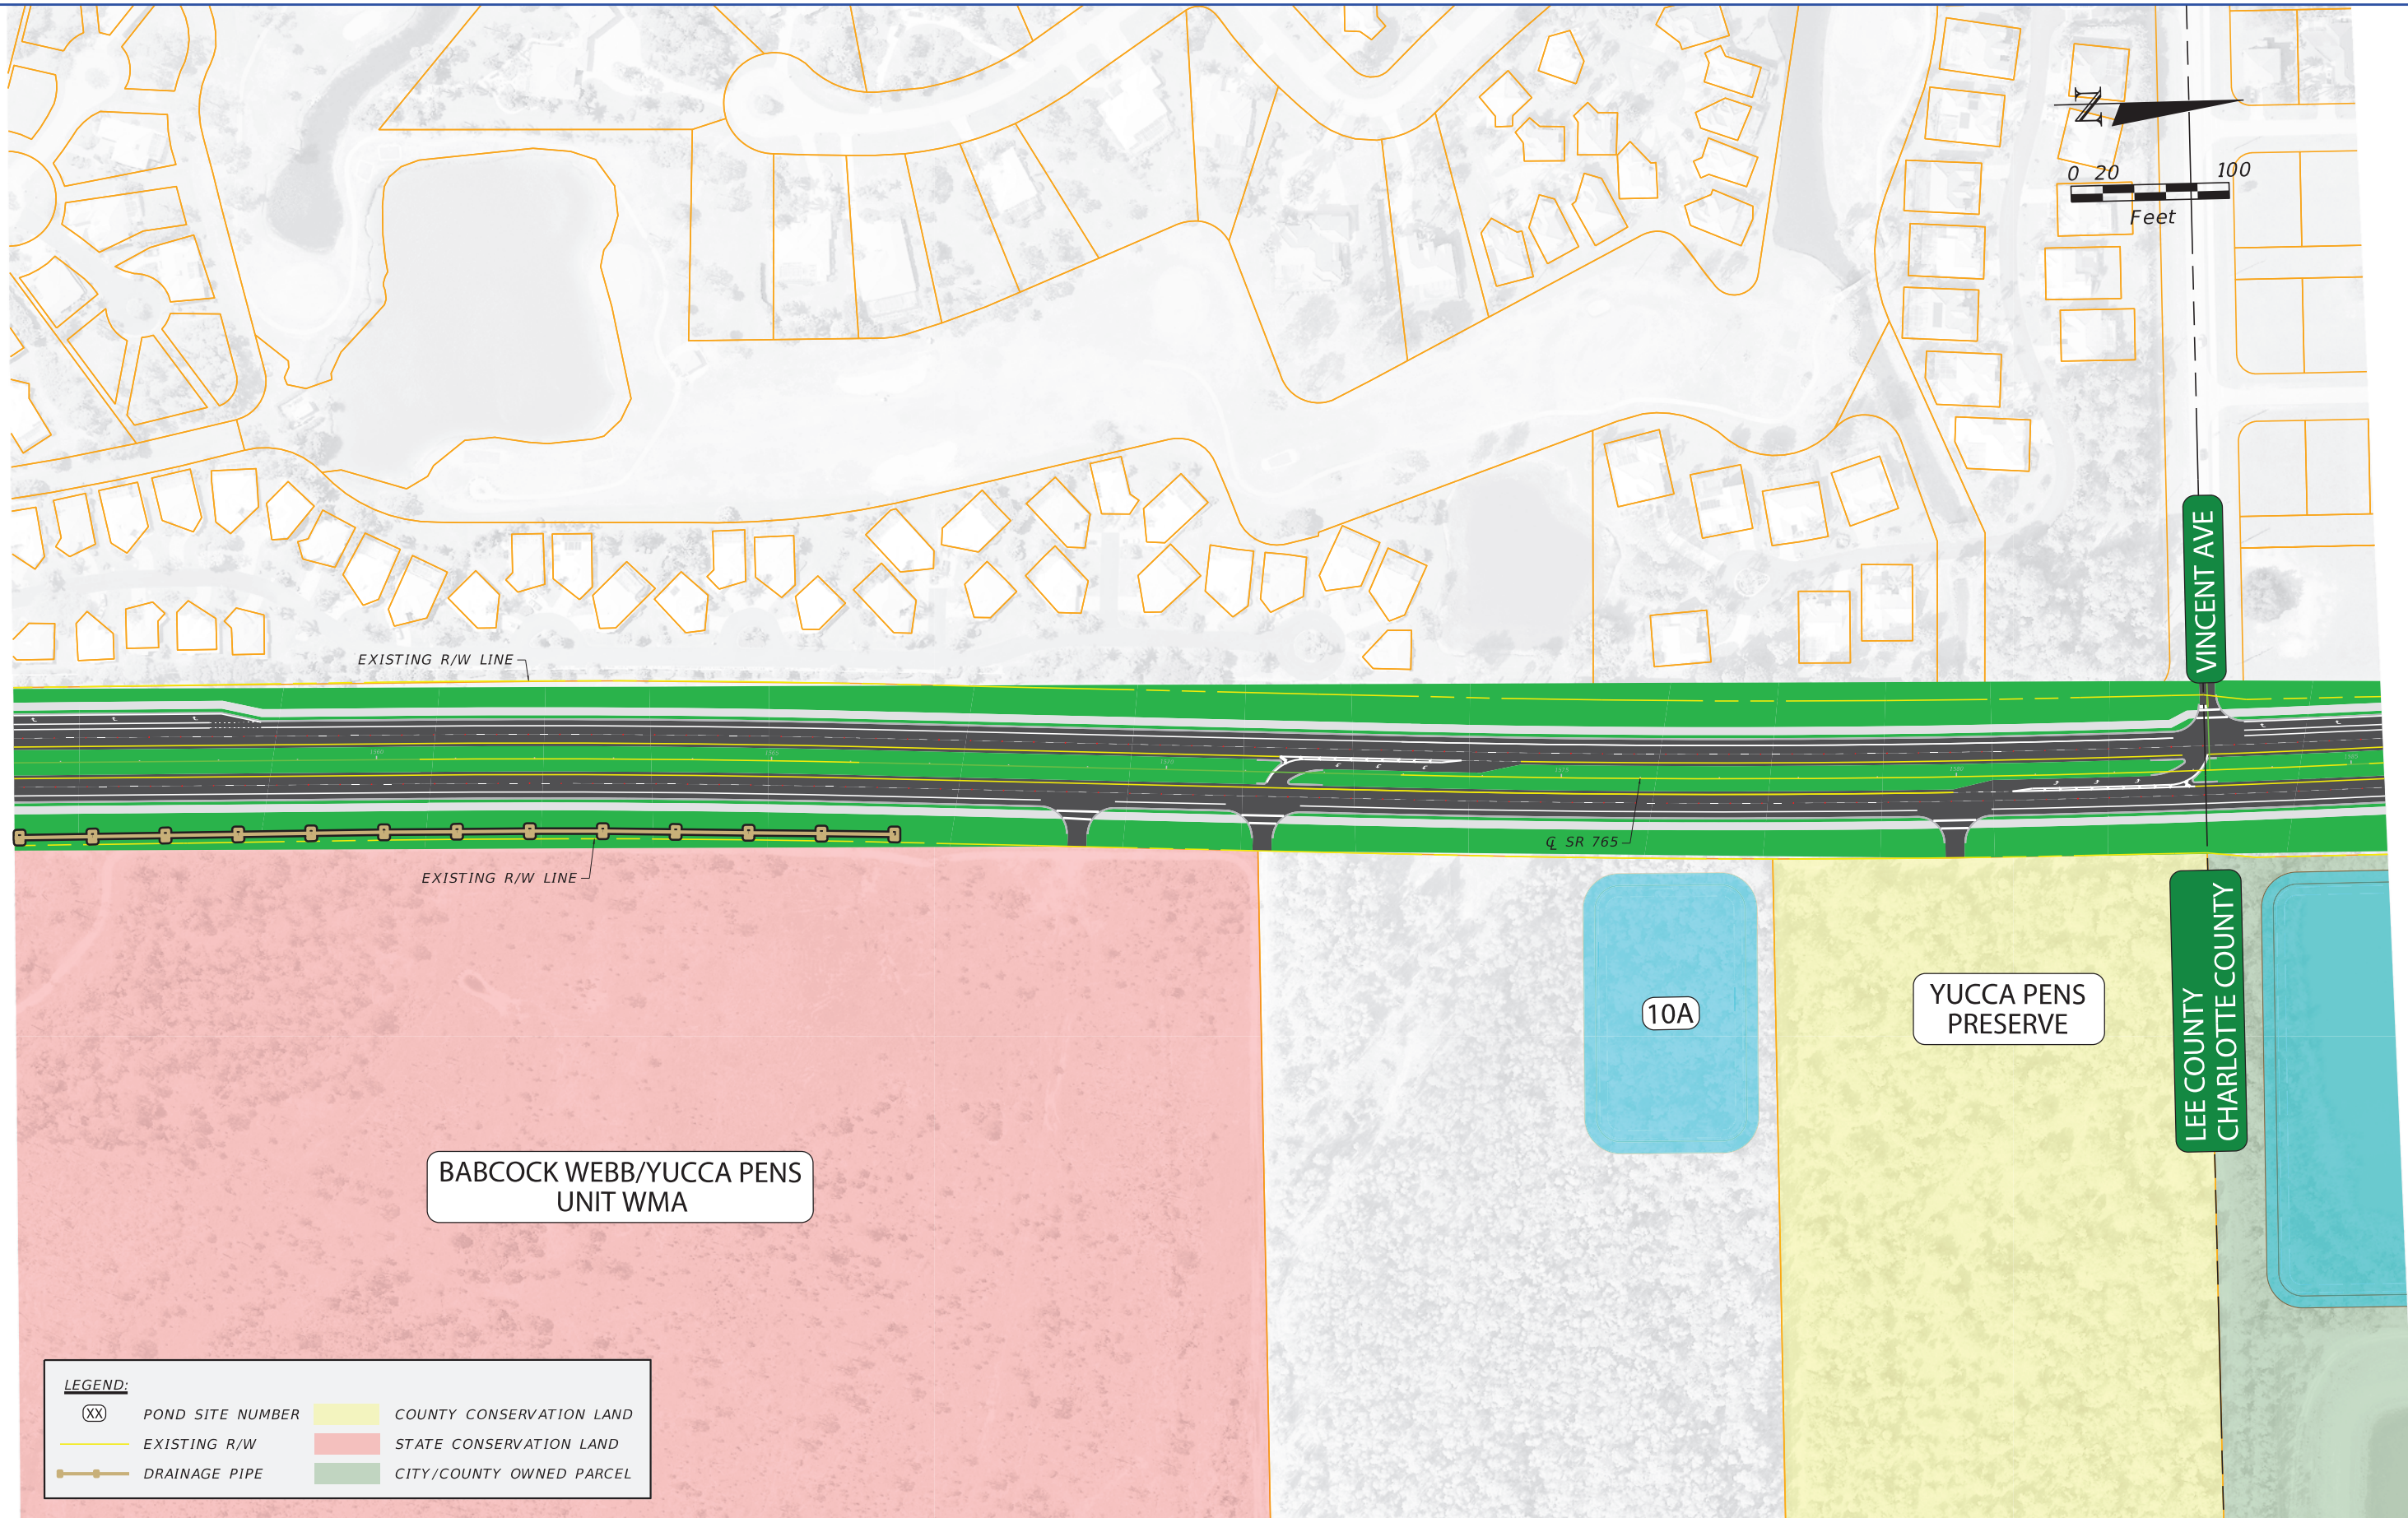


LEGEND:

(XX)	POND SITE NUMBER	[Yellow Box]	COUNTY CONSERVATION LAND
[Green Line]	EXISTING R/W	[Pink Box]	STATE CONSERVATION LAND
[Line with Squares]	DRAINAGE PIPE	[Green Box]	CITY/COUNTY OWNED PARCEL

REVISIONS				ENGINEER OF RECORD		STATE OF FLORIDA DEPARTMENT OF TRANSPORTATION			URBAN ALTERNATIVE WITH PIPED OFF-SITE DRAINAGE	SHEET NO. 10
DATE	DESCRIPTION	DATE	DESCRIPTION			ROAD NO.	COUNTY	FINANCIAL PROJECT ID		
				ANIRUDDHA S. GOTMARE, P.E. P.E. LICENSE NUMBER 54801 SCALAR CONSULTING GROUP INC. 5713 CORPORATE WAY WEST PALM BEACH, FL 33407		CR 765	LEE	436928-1-22-01		

THE OFFICIAL RECORD OF THIS SHEET IS THE ELECTRONIC FILE DIGITALLY SIGNED AND SEALED UNDER RULE 61G15-23.004, F.A.C.

1/16/2023 3:34:03 PM USER: mwilson
P:\2019\SP19D1000 Burnt Store Rd. PD&E\43692812201\roadway\PLAMRD01.dgn

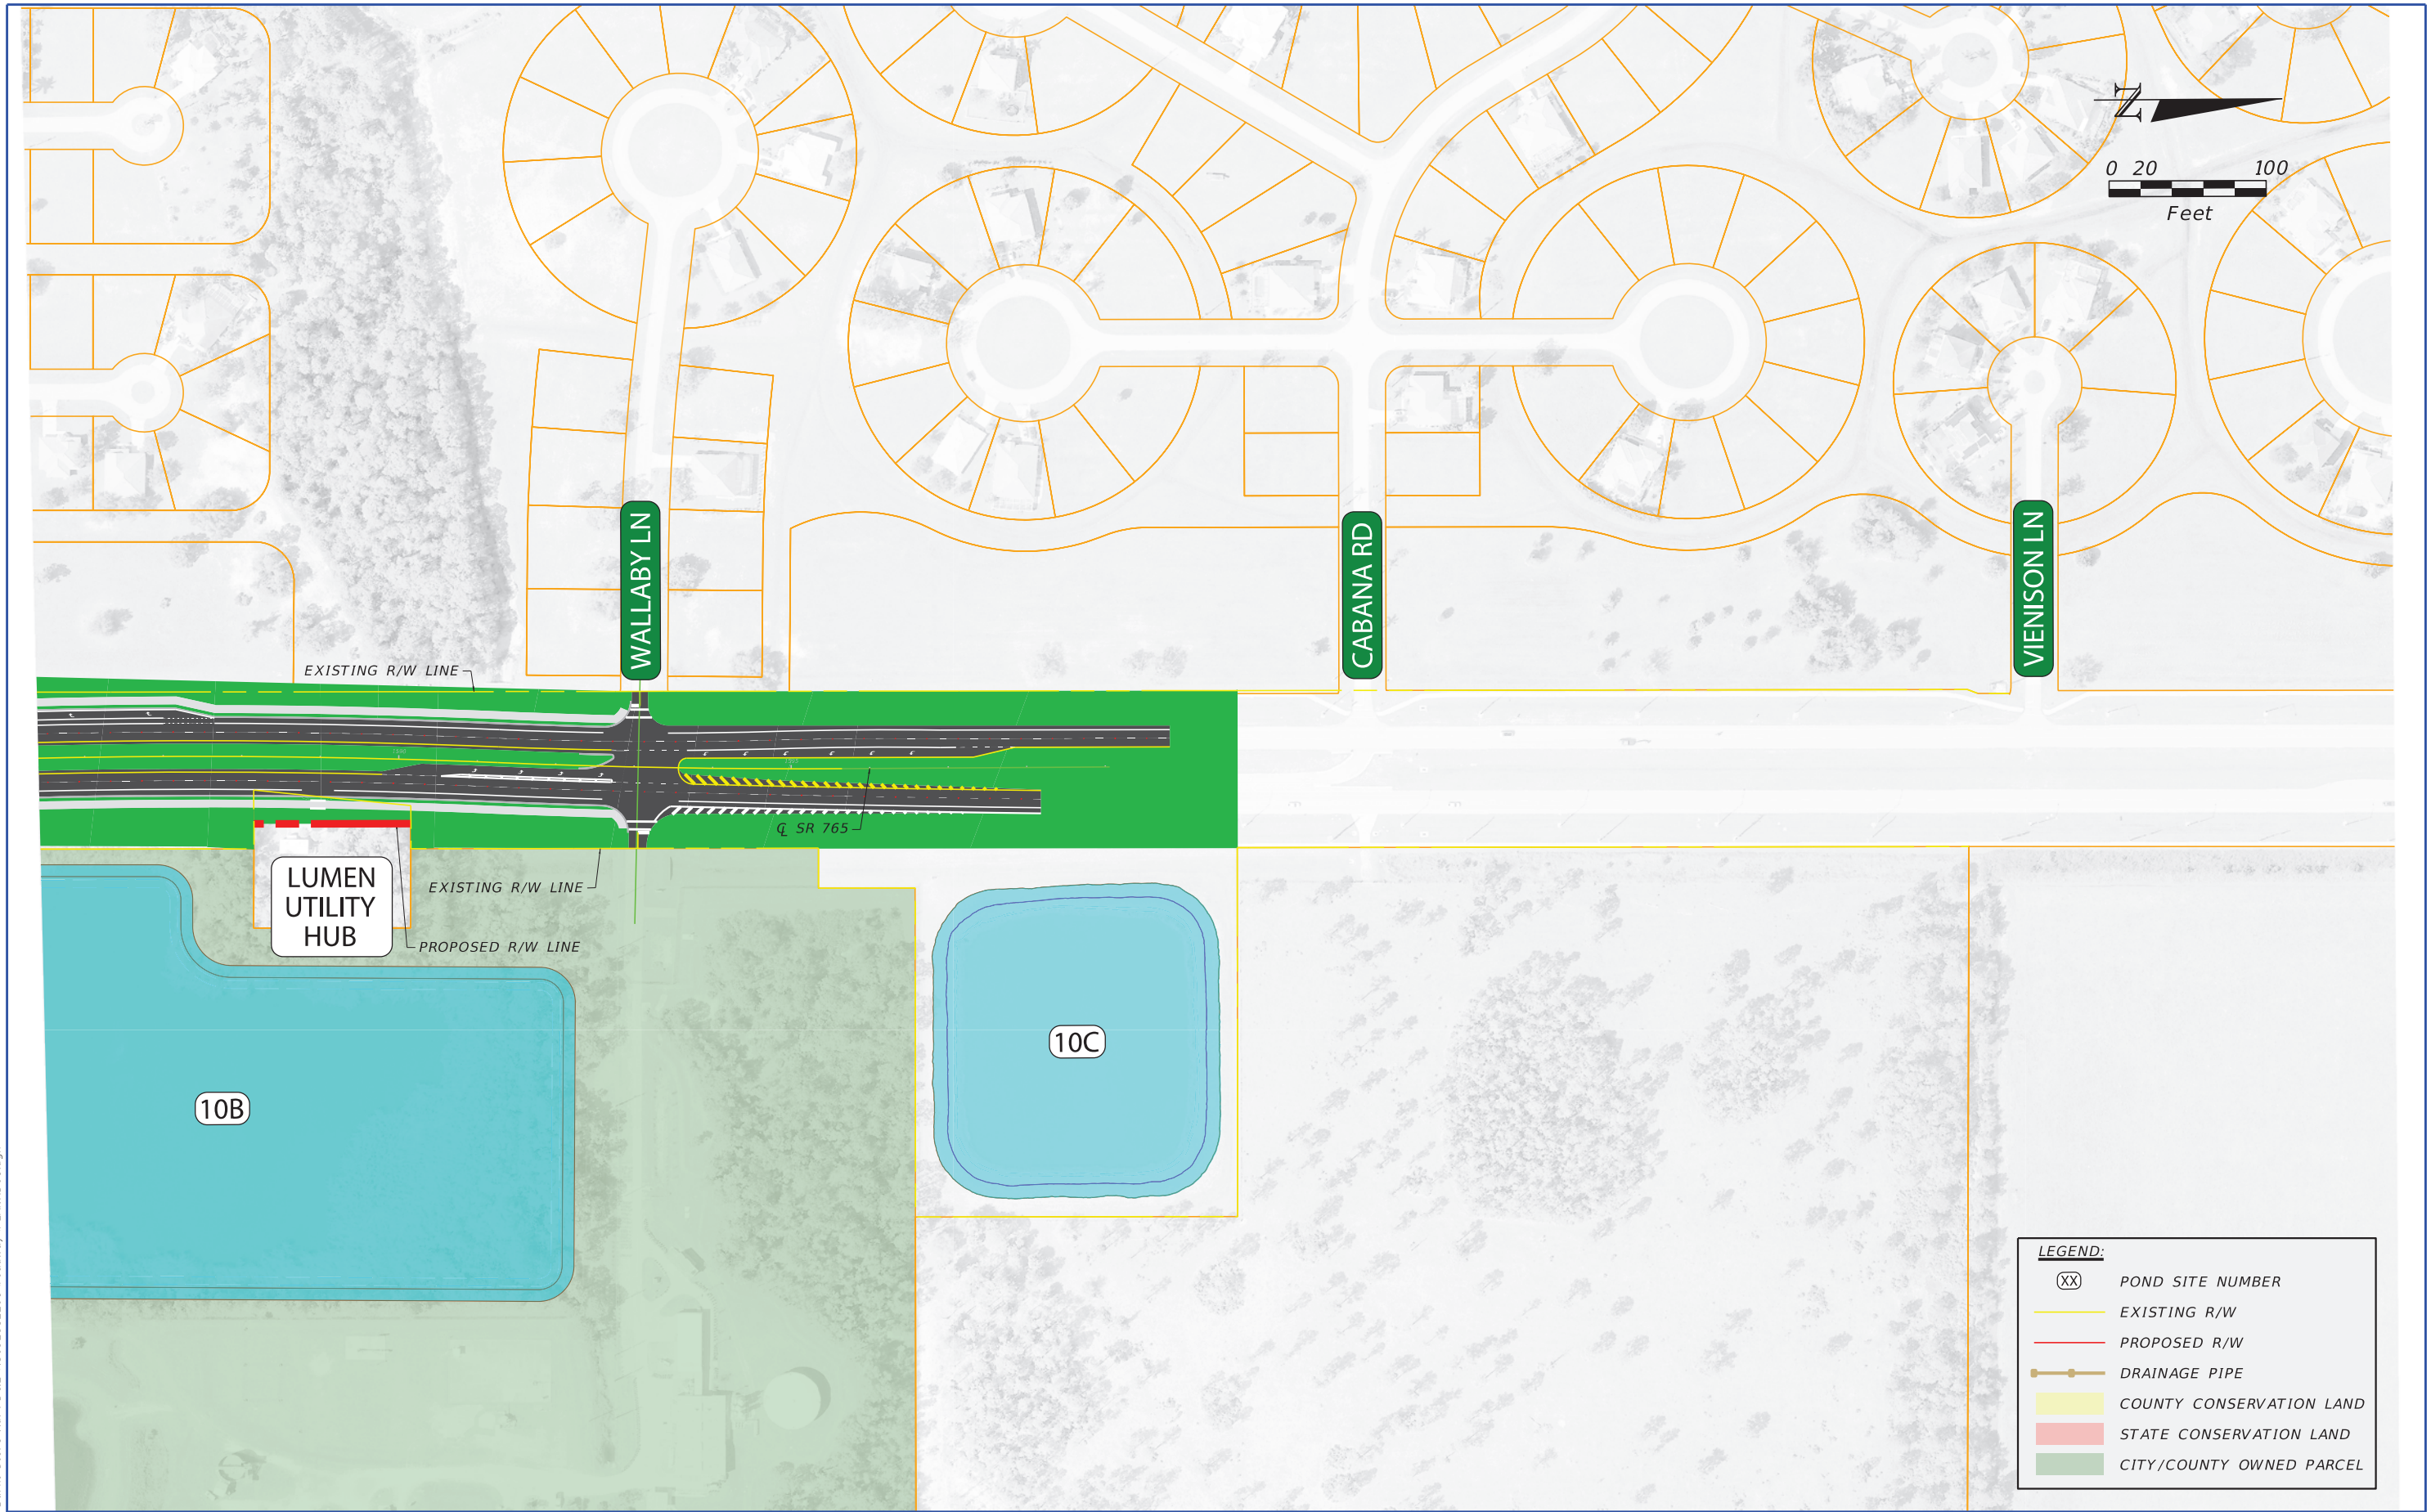

LEGEND:

- (XX) POND SITE NUMBER
- EXISTING R/W
- PROPOSED R/W
- DRAINAGE PIPE
- COUNTY CONSERVATION LAND
- STATE CONSERVATION LAND
- CITY/COUNTY OWNED PARCEL

REVISIONS			
DATE	DESCRIPTION	DATE	DESCRIPTION

ENGINEER OF RECORD
ANIRUDDHA S. GOTMARE, P.E.
P.E. LICENSE NUMBER 54801
SCALAR CONSULTING GROUP INC.
5713 CORPORATE WAY
WEST PALM BEACH, FL 33407

STATE OF FLORIDA DEPARTMENT OF TRANSPORTATION		
ROAD NO.	COUNTY	FINANCIAL PROJECT ID
CR 765	LEE	436928-1-22-01

**URBAN ALTERNATIVE
WITH PIPED OFF-SITE
DRAINAGE**

**SHEET
NO.
11**

THE OFFICIAL RECORD OF THIS SHEET IS THE ELECTRONIC FILE DIGITALLY SIGNED AND SEALED UNDER RULE 61G15-23.004, F.A.C.